

10/24/95
11:00 cancelled
11/6/95
A.S.A.P.
12/9/95
3:00
12/6/95
11:00

PERMIT

SEWAGE DISPOSAL SYSTEM

DEPARTMENT OF HEALTH AND MENTAL HYGIENE

P 50988 A

A REPAIR

DISTRICT 3rd

DATE 11/23/95

DATE SYSTEM APPROVED 12/8/95

INSPECTOR DKS

HOWARD COUNTY HEALTH DEPARTMENT
BUREAU OF ENVIRONMENTAL HEALTH
313-2640

INDEXED
03 295524

Arde Contracting, Inc. Jack Fyock Septic Service IS PERMITTED TO INSTALL ALTER

ADDRESS 9693 Gerwig Lane, Columbia, MD 21046 PHONE 290-9899

SUBDIVISION Evergreen Valley Estates LOT 28 ROAD 3105 Evergreen Way

PROPERTY OWNER Gary & Virginia Wollen

ADDRESS _____

SEPTIC TANK CAPACITY Existing GALLONS

NUMBER OF BEDROOMS 5

180 SQUARE FEET PER BEDROOM

LINEAR FEET OF TRENCH REQUIRED 180

REPAIR -- PURPOSE - INSTALL SEPTIC REPAIR PRIOR TO COMPLETYON OF ADDITION

Call for inspection when ground is opened so sanitarian can recommend repair.

Existing drywell may be abandoned.

Install new line from septic tank to d.b.

Trenches to be 2' wide, inlet 4.5', bottom 9.5', stone 5'.

Trenches to be installed on contour across back yard ^{near perc hole}

PLANS APPROVED BY Souma K Glee DATE 11/6/95 (A)

COVER NO WORK UNTIL INSPECTED AND APPROVED

NEITHER THE HOWARD COUNTY COUNCIL NOR THE HEALTH DEPARTMENT IS RESPONSIBLE FOR THE SUCCESSFUL OPERATION OF ANY SYSTEM

NOTE: CLEANOUT REQUIRED EVERY 70 FEET OF SEWER LINE AND/OR AT 90° SWEEPS IN LINES FROM HOUSE TO DRAIN FIELDS, 90° ELBOWS NOT ACCEPTABLE.

NOTE: ALL PARTS OF SEPTIC SYSTEMS (I.E. TANK, DISTRIBUTION BOX TRENCHES) TO BE 100 FEET FROM WELL (UNLESS OTHERWISE SPECIFICALLY AUTHORIZED)

NOTE: IF DEEP TRENCH(ES) ARE USED CALL FOR INSPECTION BEFORE AND AFTER PLACING GRAVEL IN TRENCH(ES)

NOTE: NO DRY WELL SHALL EXCEED 15 FOOT IN DIAMETER NO ABSORPTION TRENCH TO EXCEED 100 FEET IN LENGTH

NOTE: ALL PIPE FROM HOUSE TO SEPTIC TANK MUST BE CAST IRON OR SCHEDULE 35/40 PVC OR ABS


PERMIT VOID AFTER TWO YEARS

NOTE: INSTALL STAND PIPE ON SEPTIC TANK AND DRY WELL STAND PIPES MUST BE 6 INCHES IN DIAMETER CAST IRON, CONCRETE OR TERRA COTTA OR PVA OR ABS ACCEPTED. IF TOP OF SEPTIC TANK IS DEEPER THAN 3 FEET. MANHOLE TO GRADE REQUIRED.

NOTE: DISTRIBUTION BOXES MUST HAVE BAFFLES

***INSTALLER IS RESPONSIBLE FOR OBTAINING FINAL APPROVAL ON THIS PERMIT**

P
A-50988A

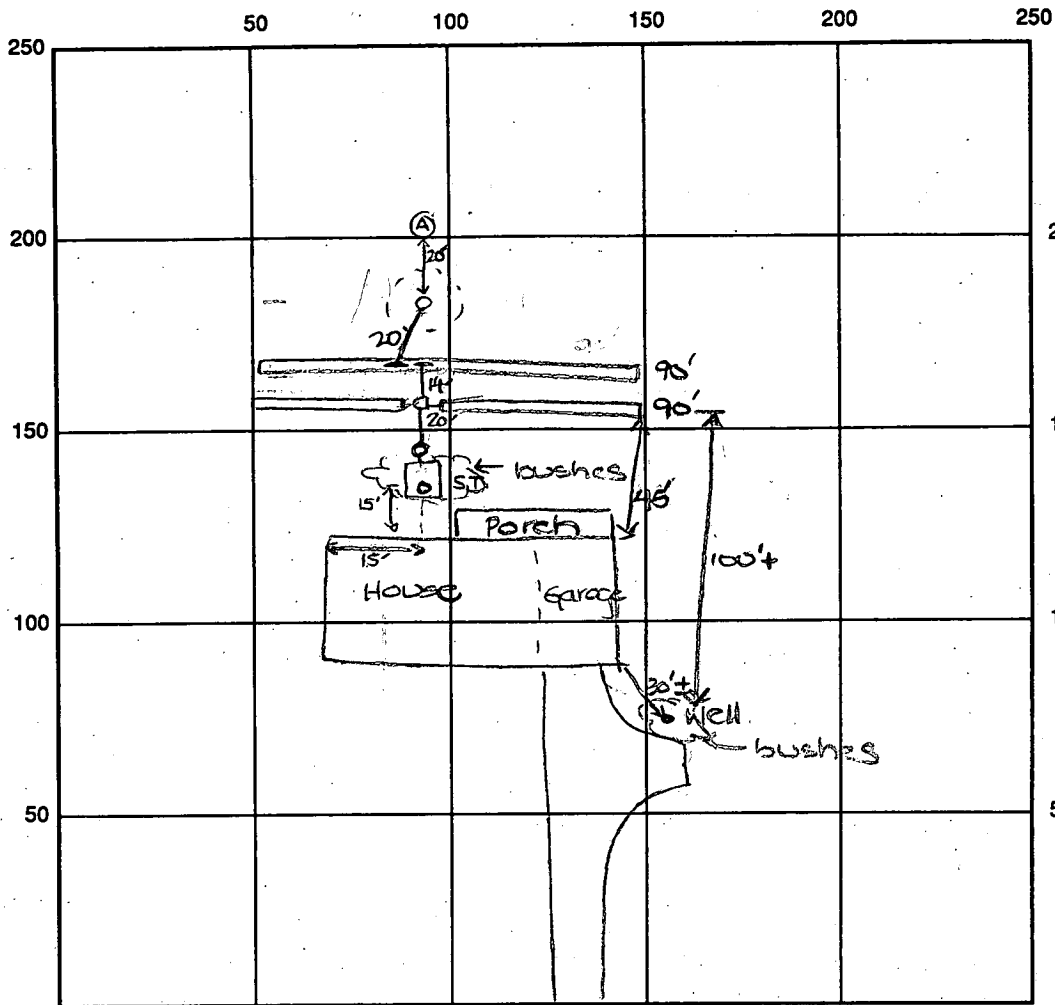

INDICATE NORTH - NAME ADJOINING ROADWAY AS BASE LINE

Evergreen Way

SEPTIC TANK LEVEL Existing CLEANOUTS one on s.t., one in line
one on d.w.

DISTRIBUTION BOX LEVEL OK

DRAIN FIELD/TITLE DEPTH 9.5 FT. TRENCH WIDTH 2 FT. INLET DEPTH 4.5 FT.

EFFECTIVE GRAVEL DEPTH 4 FT. TOTAL LENGTH 090' 390' FT. → 180' total


NUMBER OF TRENCHES 2 ONE SIDEWALL/AREA 900 SQ. FT.

DRYWALL INSIDE DIAMETER Existing FT. EFFECTIVE DEPTH BELOW INLET Existing FT.

ABSORBENT AREA 900 SQ. FT. + Existing


REMARKS: 11/6/95 perc test OK. Drywell may be abandoned. DKS
12/7/95 Drywell to be maintained. OK to stone trenches
and continue. DKS
12/8/95 FINAL - OK to cover all work. DKS

DATE SYSTEM APPROVED 12/8/95 INSPECTOR Sonia K. Goo

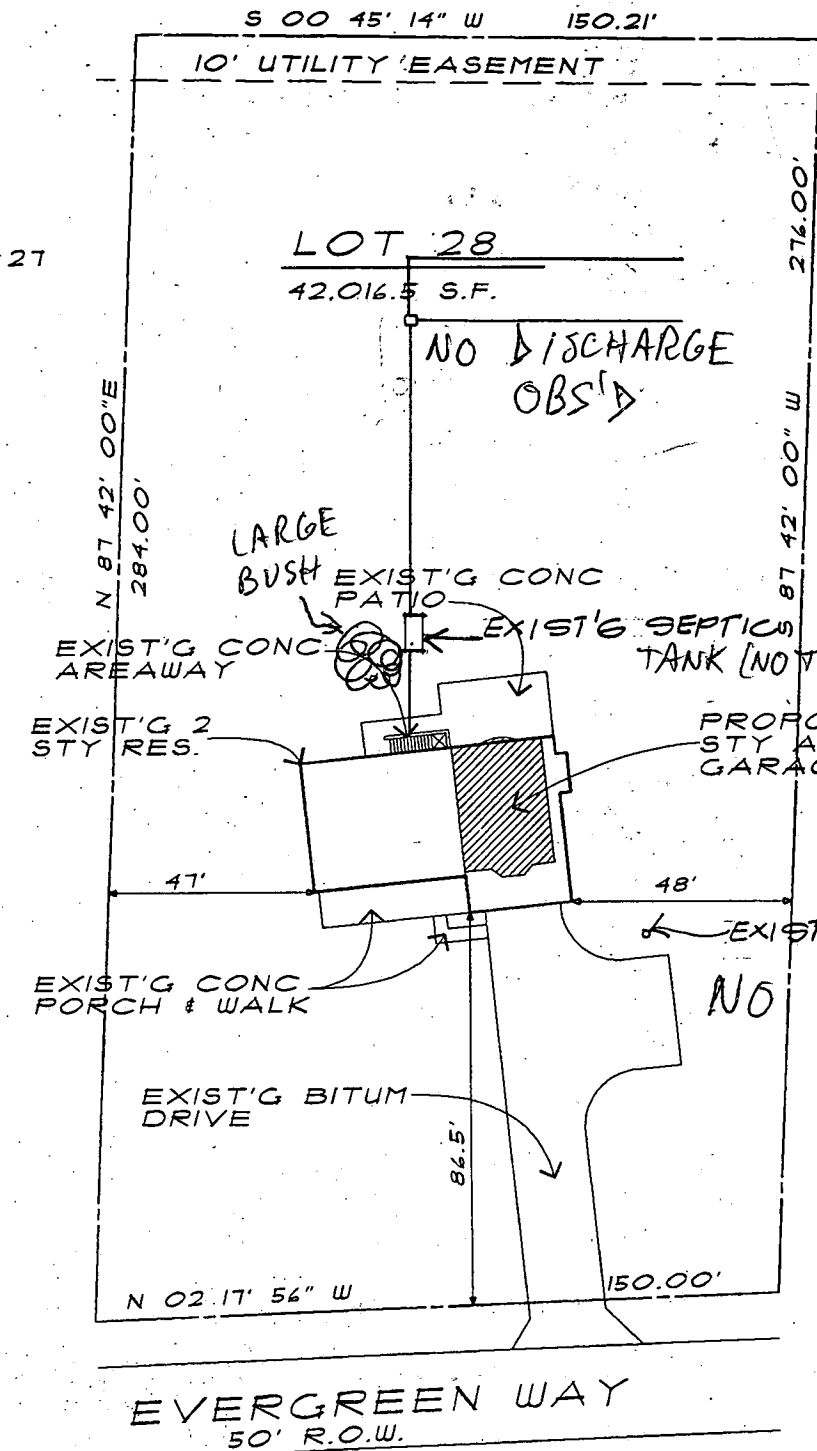

8/30/95
 RECOMMEND
 SEPTIC REPAIR
 FOR BR ADDITION
 MR


9/25/95
 PAUL ARNOLD (CONTRACTOR
 FOR ADDITION) HAS
 AGREED TO
 INSTALL
 REPAIR PRIOR TO
 COMPLETION OF
 ADDITION - OK
 NO TAG TO SIGN MR
 TAG

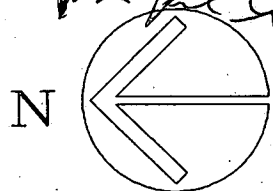

Add'l on BDRM Suite
 BLDG. PERMITS SIGNED
 AND RETURNED 9-25-95
 Serial # 61435

LOT 28, 3105 EVERGREEN WAY, EVERGREEN VALLEY ESTATES, SECTION 4, P.B. 10, FOLIO 54, 3RD ELECTION DIST., HOWARD CO., MD

	SITE PLAN	1"=40'-0"
	WOLLEN ADDITION	15 AUG 95

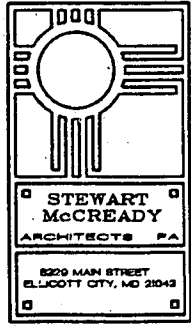

09648
APPLICATION

HOWARD COUNTY

SERIAL NUMBER

PERMIT APPLICATION

DEPARTMENT OF INSPECTIONS, LICENSES & PERMIT
3430 COURT HOUSE DRIVE, ELICOTT CITY, MARYLAND 21043

61435 /

BUILDING ADDRESS (HOUSE NO., STREET, TOWN OR AREA)

3105 EVERGREEN WAY
ELICOTT CITY, MD 21043

GRADING/SEDIMENT CONTROL YES NO

SDP #

DESCRIPTION OF WORK AUTHORIZED

ADD MASTER BDRM SUITE WITH
BATHROOM OVER EXISTING
GARAGE.

LOT NO.	PARCEL NO.	SEC.	AREA	BLOCK NO.	LIBER.	FOLIO
28		4				

SUB DIVISION	ZONE	ZONE MAP	ELEC. DIST.	CENSUS TR.
Evergreen Valley Estates			3A5	

OWNER NAME AND ADDRESS
GARY I VIRGINIA WOLLEN
3105 EVERGREEN WAY
ELICOTT CITY MD 21043

PHONE NO.
6133

OCCUPANT'S NAME AND ADDRESS
SAME AS ABOVE

PHONE NO.

ARCHITECT OR ENGINEER'S NAME AND ADDRESS
STEWART / MCCREARY ARCHITECTS, PA
8429 MAIN ST.
ELICOTT CITY, MD 21043

PHONE NO.
465-7677

CONTRACTOR'S NAME AND ADDRESS
AT BID Ardo Contracting, Inc.
290-9899 8693 Gerwig La. Cal. 21046

PHONE NO.

EXISTING USE
SINGLE FAMILY DWELLING

PROPOSED USE
ADDITION TO SAME

EST. CONSTRUCTION COST
\$50,000.00

LICENSE NUMBER

PERMIT FEE

SIZE OF BLDG.	FRONT	DEPTH	HEIGHT
	53'	35'	23.5'

TYPE OF BLDG.	AREA	VOLUME	ROOF
B. ROOMS			
ROOMS			
BATHS			
FIREPLACES			

FOOTINGS	FOUNDATION	S. WALLS

UTILITIES				
WATERWELL	SEWER/SEPTIC	GAS	ELECTRICITY	TYPE OF HEAT
				AC

I have carefully examined and read this application and know the same is true and correct, and that is doing this work, all provisions of Howard County Ordinances and the State Laws of Maryland will be complied with, whether specified or not; and I will notify the Department of Inspections, and Permits twenty-four hours in advance when I am ready for the inspections called for elsewhere in the application; and that no work will be covered up until such inspections have been complied with.

Don Thomas
Agent
8/23/95
DATE

W/S CODE

FOR OFFICE USE ONLY

DISTRICT IN FEET FROM RW LINE TO FRONT BUILDING LINE

SIDE YARD (DISTANCE IN FEET FROM SIDE BLDG. LINE TO SIDE PROPERTY LINE)

TO SIDE BUILDING LINE DISTANCE IN FEET, REAR YD. REQUIRING SET

BACK (CORNER LOT ONLY)

SDP #

Check payable to: DIRECTOR OF FINANCE OF HOWARD COUNTY

CAUTION

To begin construction before a permit placard has been issued and displayed on the job is a violation of the law.
Use and occupancy permit must be applied for two weeks before it will be issued.

IMPORTANT: PLEASE SHOW ZIP CODES AND AREA CODES WHEREVER REQUIRED.

LP-69-591

FUNCTION	DATE	SIGNATURE APPROVAL
ZONING/PLANNING		
SHA		
SEDIMENT/GRADING		
BUILDING OFFICIAL		
WATER & SEWER		
HEALTH DEPT.	9/25/95	<i>Mark E. R...</i>
FIRE PROTECTION		
STORM WATER MGM		

APPROVED

DATE

Distribution of Copies:
White - Building Official
Green - Planning & Zoning

Yellow - Engineering
Pink - Health Dept.
Gold - S.H.A.

Am