

7/12/00
Septic CO. 10 AM

PERMIT

P 513636

SEWAGE DISPOSAL SYSTEM

A 56429-~~ATI~~

INDEXED

HOWARD COUNTY HEALTH DEPARTMENT

BUREAU OF ENVIRONMENTAL HEALTH

410-313-2640

ISSUE DATE 6/14/2000

APPROVAL DATE 7/12/00

03-327477

Hatfields Equipment IS PERMITTED TO INSTALL ALTER

ADDRESS 13785 Burntwoods Road, Glenelg, MD 21737 PHONE 301-854-6172

SUBDIVISION Gaither Hunt I LOT NUMBER 35 ADDRESS 11083 Dorsch Farm Road

PROPERTY OWNER Ryan Homes PROPERTY OWNER'S ADDRESS 11460 Cronridge Drive

SEPTIC TANK CAPACITY 1250 GALLONS Owings Mills, MD 21117

PUMP CHAMBER CAPACITY _____ GALLONS

NUMBER OF BEDROOMS 4 *** TOP SEAMED SEPTIC TANK REQUIRED ***

SQUARE FEET PER BEDROOM 180

LINEAR FEET OF TRENCH REQUIRED 240

TRENCHES: Trenches to be 3 feet wide. Inlet 3 feet below original grade. Bottom maximum depth
5 feet below original grade. 2 feet of stone below distribution box.

LOCATION: Start the first trench approximately 115' from the front lot line and 25' from the
left lot line. Run trenches along contour toward right side of property.

PLANS APPROVED Craig Williams OK SRH 6/19/00 DATE 6/19/2000

PERMIT VOID AFTER 2 YEARS

NOTE: CONTRACTOR RESPONSIBLE FOR SCHEDULING A PRE-CONSTRUCTION INSPECTION FOR ALL INSTALLATIONS

NOTE: TOP OF SEPTIC TANKS ARE TO BE NO DEEPER THAN 3.0 FEET BELOW FINISH GRADE

NOTE: WATERTIGHT SEPTIC TANKS REQUIRED

NOTE: CLEANOUT REQUIRED EVERY 70 FEET OF SEWER LINE AND/OR AT 90° SWEEPS IN LINES FROM HOUSE TO DRAIN FIELDS, 90° ELBOWS ARE NOT ACCEPTABLE

NOTE: ALL PARTS OF SEPTIC SYSTEMS (I.E. TANK, DISTRIBUTION BOX, DRAINFIELDS) TO BE 100 FEET FROM ANY WATER WELL UNLESS OTHERWISE SPECIFICALLY AUTHORIZED

NOTE: NO ABSORPTION TRENCH TO EXCEED 100 FEET IN LENGTH UNLESS SPECIFICALLY AUTHORIZED

NOTE: ALL PIPE FROM HOUSE TO SEPTIC TANK MUST BE CAST IRON OR SCHEDULE 35/40 PVC OR ABS

NOTE: MANHOLE RISERS REQUIRED ON ALL SEPTIC TANKS AND PUMP CHAMBERS


NOTE: DISTRIBUTION BOXES MUST HAVE BAFFLES

NOTE: IF PUMPED SEPTIC SYSTEM REQUIRED, (1) SEPTIC PUMP DETAIL TO BE PROVIDED BY INSTALLER PRIOR TO ISSUANCE OF SEPTIC PERMIT (2) PUMP PERFORMANCE TEST IS NECESSARY PRIOR TO HEALTH DEPARTMENT APPROVAL OF SEPTIC PERMIT

NEITHER THE HOWARD COUNTY COUNCIL NOR THE HEALTH DEPARTMENT IS RESPONSIBLE FOR THE
SUCCESSFUL OPERATION OF ANY SYSTEM
PERMITTEE RESPONSIBLE FOR OBTAINING FINAL APPROVAL ON THIS PERMIT
CALL 410-313-2640 FOR INSPECTION OF SEPTIC SYSTEM

A56429-ATI

NOT TO SCALE

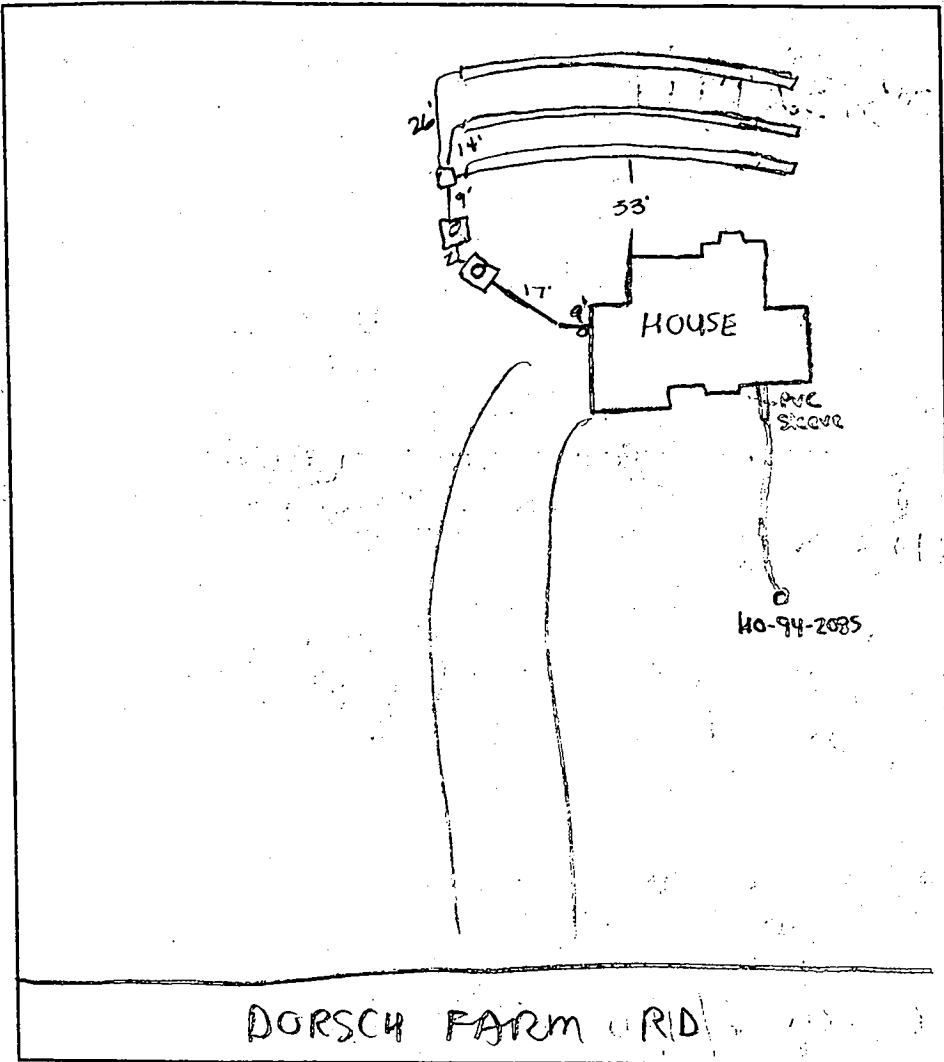

TRENCH DATA

TRENCH WIDTH 3.0
 TRENCH INLET DEPTH 3.0
 TRENCH BOTTOM DEPTH 5.0
 DEPTH OF STONE 2.0
 NUMBER OF TRENCHES 3
 TOTAL TRENCH LENGTH 240
 ABSORBENT AREA 720
 DISTRIBUTION BOX LEVEL OK
 BAFFLE IN DISTRIBUTION BOX ✓

SEPTIC TANK DATA

SEPTIC TANK 1250 GALLONS
 MANHOLE RISER OK
 6 INCH INSPECTION PORT ✓

PUMP CHAMBER DATA

PUMP CHAMBER GALLONS 1250
 MANHOLE RISER ✓
 ALARM N/A
 PUMP PERFORMANCE TEST N/A

PRE-CONSTRUCTION INSPECTION: _____

INSPECTION COMMENTS: 7/12/00 OK to cover all work

7/13/00 - WPI OK - (SRID)

INSPECTOR 7/12/00

DATE SYSTEM APPROVED A. M. Malle

7/13/00
2:00

HOWARD COUNTY HEALTH DEPARTMENT
Bureau of Environmental Health
3525-H Ellicott Mills Drive
Ellicott City, MD 21043
461-9933

APPLICATION FOR PITLESS ADAPTER, WELL PUMP AND PRESSURE TANK INSTALLATION

New Installation Replacement
Receipt # _____ Date 8/11/2000
Name of Installer LEHSAC CORP. Telephone 410-242-6888
License Number 3344 Certified well Pump Installer _____ Well Driller _____ Registered Plumber
Name of Property Owner RYAN Telephone 410-654-6888
Subdivision Gaithersburg Lot # 35 Well Tag # HO-14-2085
Site Address 11093 DORCH AVE RD

Pump
1. Type
a. Deep well jet _____
b. Shallow well jet _____
c. Submersible
2. Make JACUZZI
3. Model # T254712B-52
4. Capacity 7 GPM
5. Pump exceeds well capacity Yes _____ No
6. If Yes, is low pressure cutoff switch installed? Yes _____ No
7. What methods are used to protect the pump and electrical wiring from vibrations? Torque arrestors Cable guards Other _____

Motor
1. Horsepower 3/4
2. RPM _____
3. Voltage _____
a. 110 _____
b. 220

Pitless Adapter
1. Make WILKINS
2. Model # _____
3. Depth 42"

Tank
1. Capacity 86 gal
2. Pressure relief valve? YES

Piping
1. Type 16016
2. Size 1"
3. NSF and/or BOCA Code approved
4. Depth of supply line 42"

Well data
1. Depth 225 ft.
2. Yield 10 GPM
3. Static water level 38 ft.
4. Will water supply be disinfected by installer? YES

I understand that it is my responsibility to notify the Howard County Health Department when the installation is ready for inspection (otherwise this permit is null and void).

All information given above is true to the best of my knowledge.


7/13/00-WPI OR (SRK)

Signature of Applicant: [Signature]

Date: 8/11/2000

Note: A sticker indicating approval/status of the installation will be placed on the well casing at the time of the inspection.

HD-215

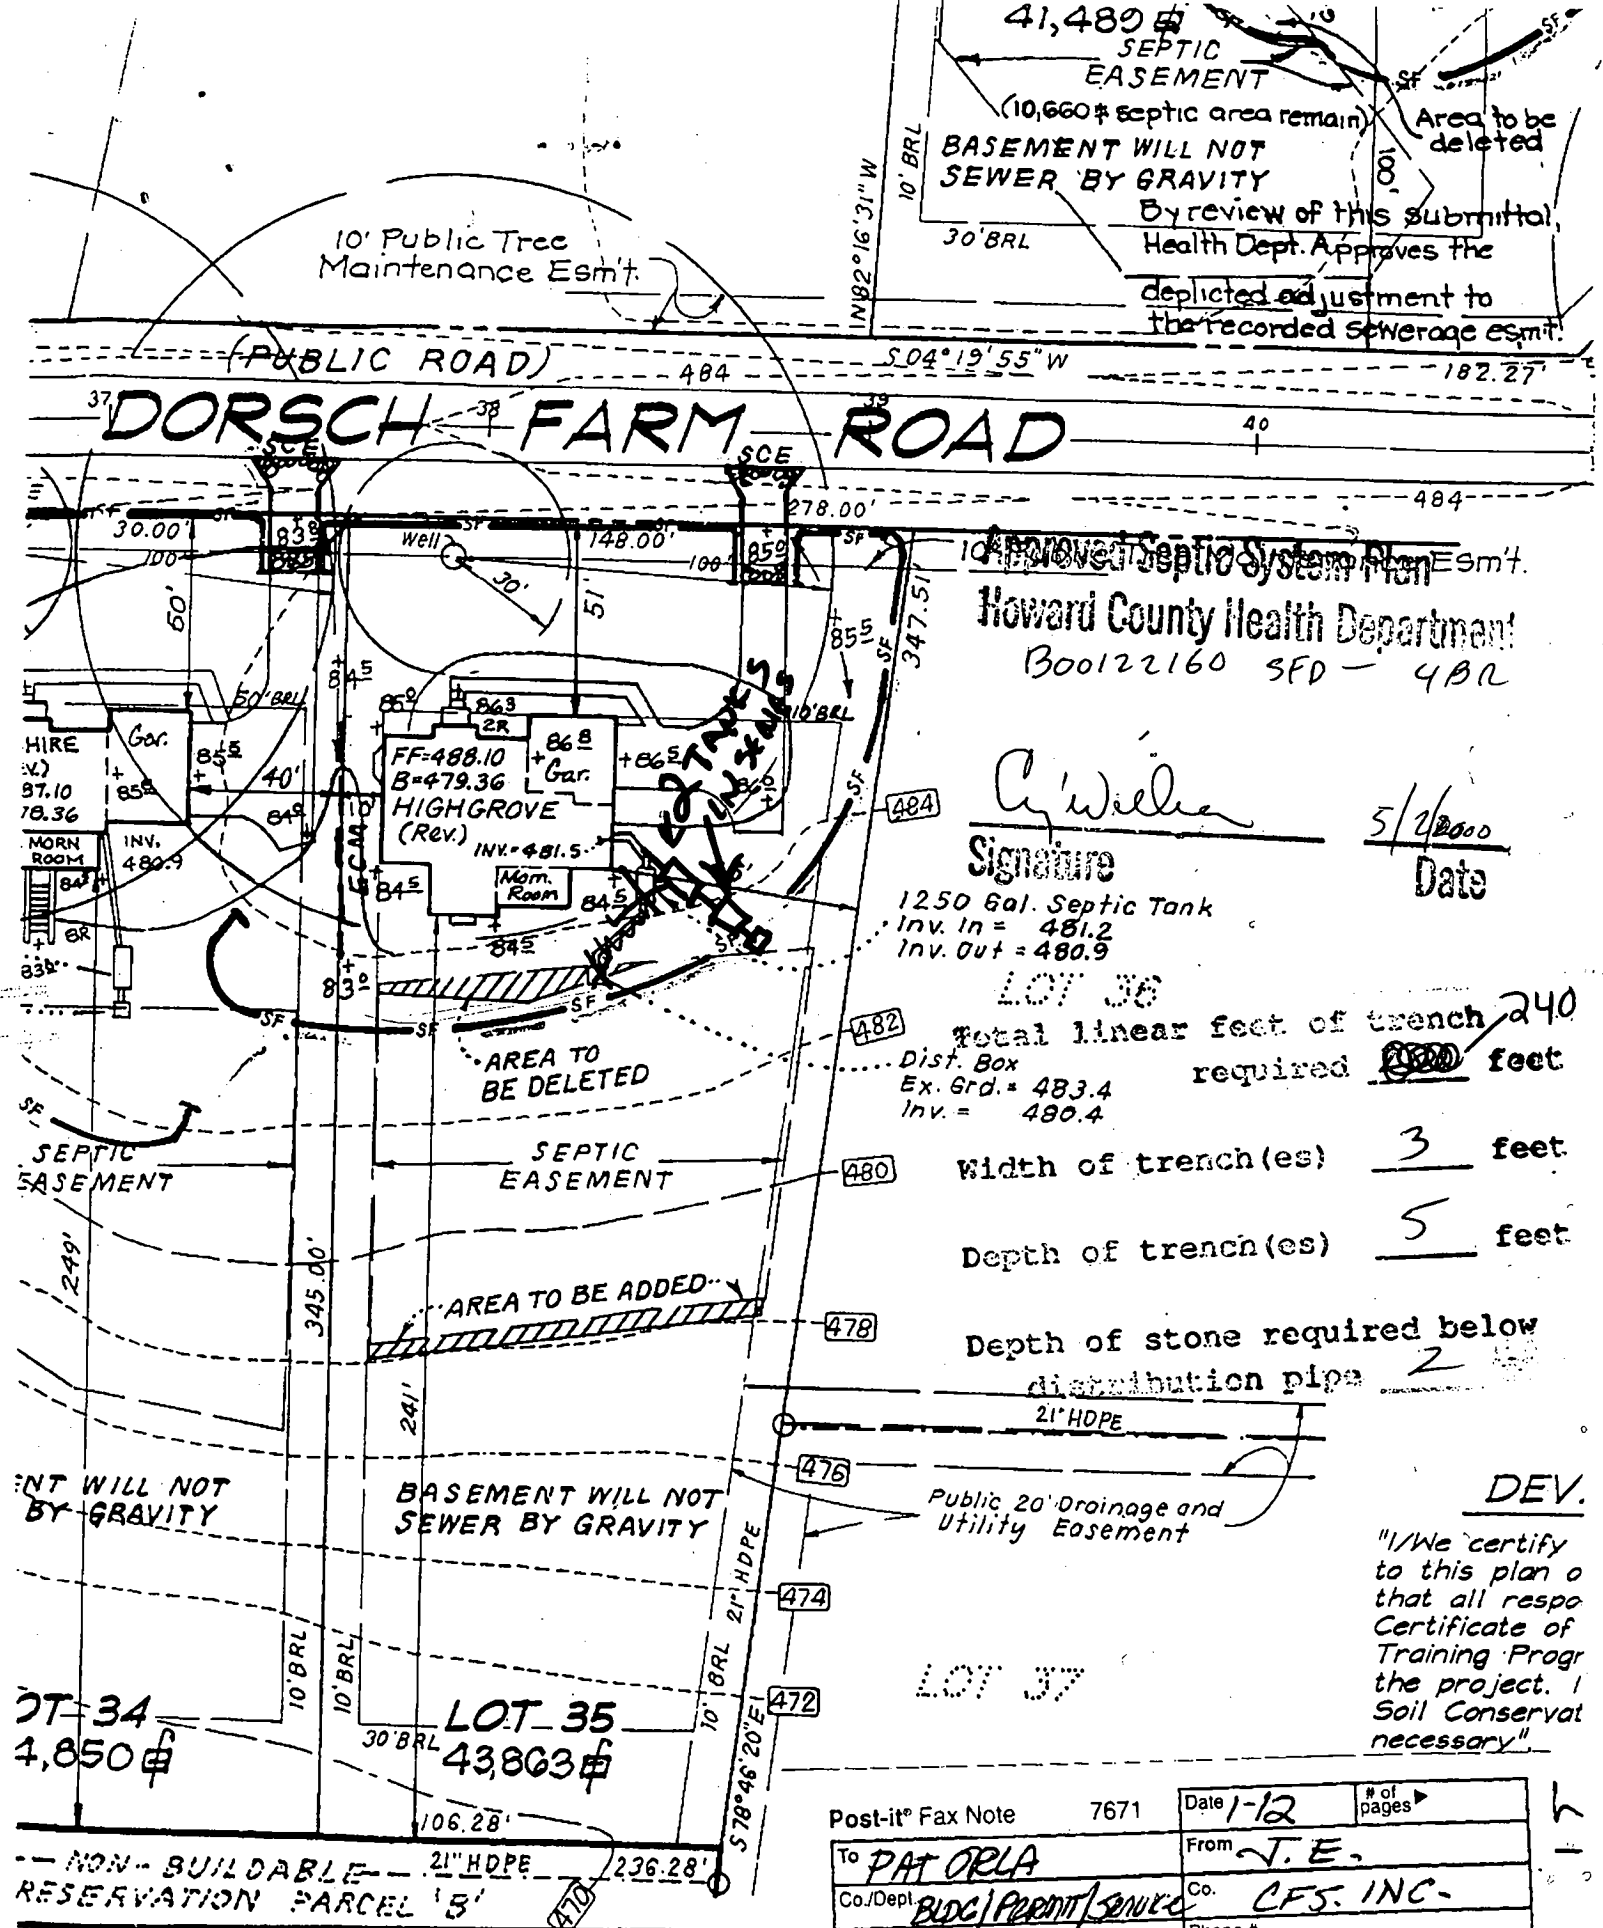

41,480 \$
 SEPTIC EASEMENT
 (10,660 \$ septic area remain)
 BASEMENT WILL NOT SEWER BY GRAVITY
 By review of this submittal, Health Dept. Approves the depicted adjustment to the recorded sewerage esmt.

10' Public Tree Maintenance Esmt.

(PUBLIC ROAD)

DORSCH FARM ROAD

Approved Septic System Plan
 Howard County Health Department
 B00122160 SFD - 4BR

C. Wilber
 Signature
 5/2/2000
 Date

1250 Gal. Septic Tank
 Inv. In = 481.2
 Inv. Out = 480.9

LOT 36
 Total linear feet of trench required 240 feet
 Dist. Box Ex. Grd. = 483.4
 Inv. = 480.4
 Width of trench(es) 3 feet
 Depth of trench(es) 5 feet
 Depth of stone required below distribution pipe 2

Public 20' Drainage and Utility Easement

DEV.
 "I/We certify to this plan that all responsible parties have completed the Certificate of Training Program for the project. Soil Conservation necessary"

Post-it® Fax Note	7671	Date	1-12	# of pages	
To	PAT ORLA	From	J. E.		
Co./Dept.	BUDG/PARENT/SERVICE	Co.	CFS. INC.		
Phone #	Gaither Hunt	Phone #			
Fax #	LOT 35	Fax #			

LOT 34 4,850 \$
 LOT 35 43,863 \$
 21" HDPE
 NON-BUILDABLE RESERVATION PARCEL 'B'

APPLICATION

PERCOLATION TESTING

A _____

P _____

HOWARD COUNTY HEALTH DEPARTMENT
BUREAU OF ENVIRONMENTAL HEALTH
3525-H ELLICOTT MILLS DRIVE/ELLICOTT CITY, MARYLAND 21043
TELEPHONE: 313-2840

DISTRICT _____

DATE 4-12-96

TO: THE COUNTY HEALTH OFFICER
ELLICOTT CITY, MARYLAND

I HEREBY APPLY FOR THE NECESSARY TEST PRIOR TO APPLICATION FOR PERMIT TO CONSTRUCT (OR RECONSTRUCT) A SEWAGE DISPOSAL SYSTEM.

PROPERTY OWNER J Thomas Scriver RYAN HOMES

ADDRESS c/o Land Design & Development PHONE 410 740 5176

AGENT OR PROSPECTIVE BUYER Donald R. Reuser Jr

ADDRESS 10805 Hickory Ridge Rd PHONE _____
21044

PROPERTY LOCATION:
SUBDIVISION GAITHER HUNT I LOT NO. 35

ROAD AND DESCRIPTION 11083 DORSCH FARM ROAD

TAX MAP 29 PARCEL # 21
SIZE OF LOT 1+ Acres TYPE BLDG. SFD - 4 BRMS
(SINGLE FAMILY DWELLING OR COMMERCIAL)

**BLDG PERMIT SIGNED
AND RETURNED 5/2/2000.**
B00122160

THE SYSTEM INSTALLED UNDER THIS APPLICATION IS ACCEPTABLE ONLY UNTIL PUBLIC FACILITIES BECOME AVAILABLE. I FULLY UNDERSTAND THE FEE CONNECTED WITH THE FILING OF THIS PERC TEST APPLICATION IS NON-REFUNDABLE UNDER ANY CIRCUMSTANCES. I ALSO AGREE TO COMPLY WITH ALL M.O.S.H.A. REQUIREMENTS IN TESTING THIS LOT. [Signature]
(SIGNATURE OF APPLICANT)

APPROVED BY _____ FOR _____ DATE _____

DISAPPROVED BY _____ FOR _____ DATE _____

HOLD PENDING FURTHER TESTS _____

REASONS FOR REJECTION OR HOLDING _____

PERCOLATION TEST PLAT/PRELIMINARY PLAT - TITLE OR I.D. # _____ DATE _____

SITE DEVELOPMENT PLAN/FINAL PLAT - TITLE OR I.D. # _____ DATE _____

THIS IS NOT A PERMIT

COUNTY #


SOIL PROFILE

0'

Empty vertical box for soil profile notes.

Empty vertical box for soil profile notes.

Empty vertical box for soil profile notes.

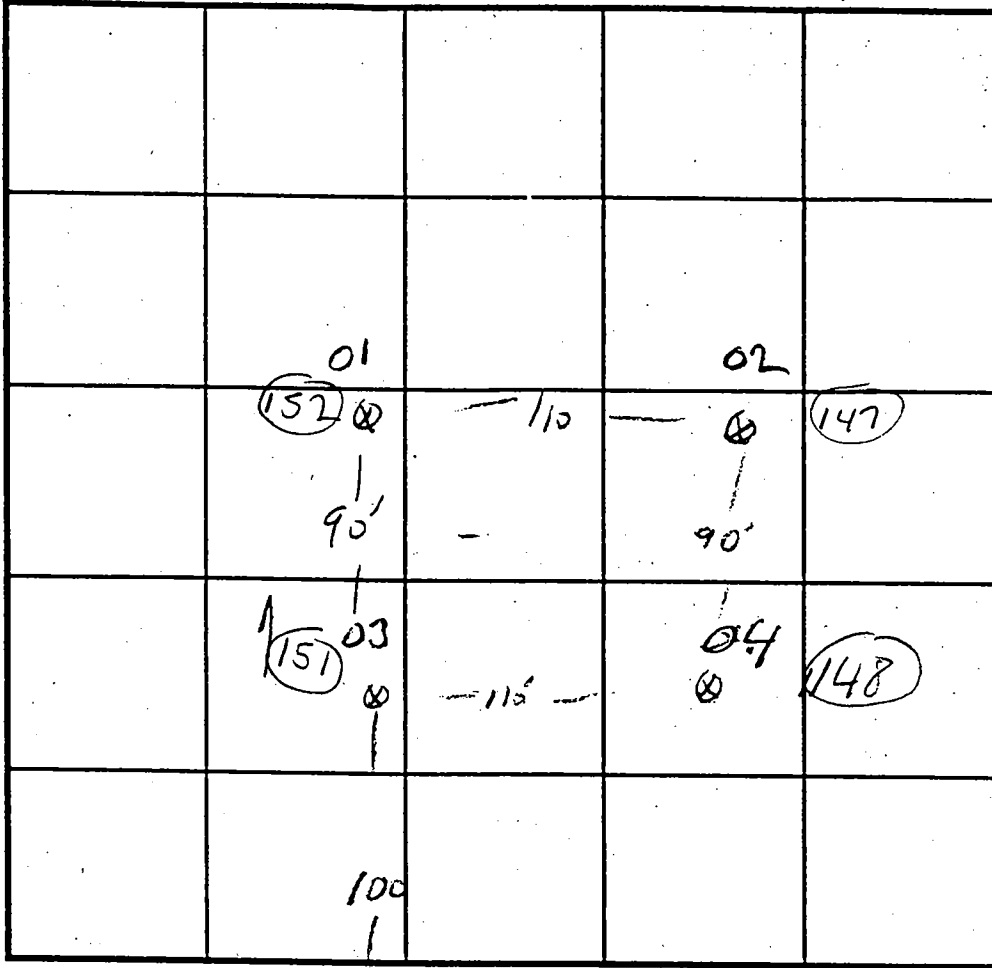

SOIL PROFILE

0'

TOP SOIL

ORANGE SANDY CLAY LOAM

Brown SSC

1'

6

11

PLAT #5 CIRCLED

INDICATE NORTH - NAME ADJOINING ROADWAY AS BASE LINE.

N FARM ROAD

DATE	TEST NO.	DEPTH	PRE-WET		TEST - 1" DROP		TIME
			START	STOP	START	STOP	
4/12-96	151 03	5' 11'	3:23	3:26	3:26	3:33	74W
	152 01	46" 11'	3:27	3:28	3:30	3:32	2MW
	148 04	4'8" 10'6"	3:32	3:34	3:34	3:39	5MW
	147 02	4' 10'6"	3:38	3:39	3:39	3:41	2MW

REMARKS LOT 53




TYPE OF SOIL 6, SAUAGE

TESTED BY ALKE + ALKE ALSO PRESENT Don REWICK

TRENCH DESIGN DATA: AVERAGE PERCOLATION TIME _____ TRENCH WIDTH _____


INLET DEPTH _____ MAXIMUM BOTTOM DEPTH _____ SQ. FT/BEDROOM _____

COUNTY #
SOIL PROFILE

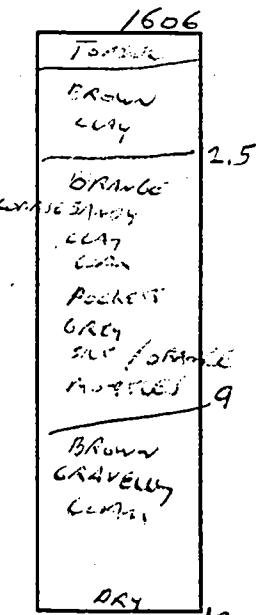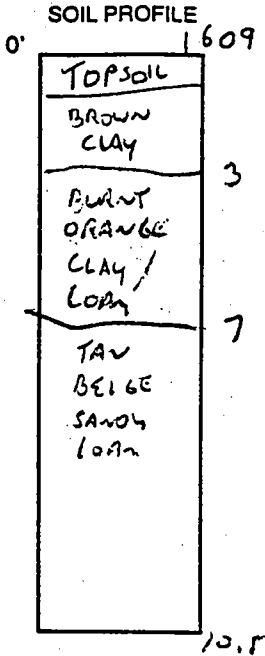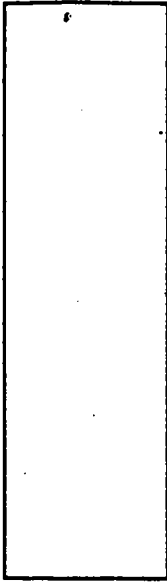

INDICATE NORTH - NAME ADJOINING ROADWAY AS BASE LINE.

DATE	TEST NO.	DEPTH	PRE-WET		TEST - 1" DROP		TIME	
			START	STOP	START	STOP		
1/24/97	LOT 40/59 1609	10.5V	SEE TEST PLAN FOR LOCATION					
	LOT 36 1606	12V						
X	* REED	9'	12:27	12:43	= 1/2 INCH			
X	LOT 35 1605	11V						
	↓	6' NOT DIGABLE			FAIL			
	AS DUG 1605	LOT 35 10' UPSLOPE	12:37	12:39	12:39	12:42	3 MIN	
		6' / 11V						

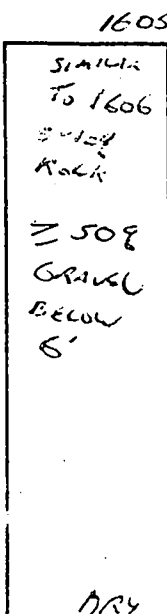



REMARKS SEE TEST PLAN FOR LOCATIONS - 1606 SHOULD BE OK SHALLOW
 TYPE OF SOIL FURTHER REVIEW / TESTING REED
 TESTED BY G. SAUVAGE ALSO PRESENT _____
 TRENCH DESIGN DATA: AVERAGE PERCOLATION TIME _____ TRENCH WIDTH _____
 INLET DEPTH _____ MAXIMUM BOTTOM DEPTH _____ SQ. FT./BEDROOM _____

P. 97.08

SEE

SHEET

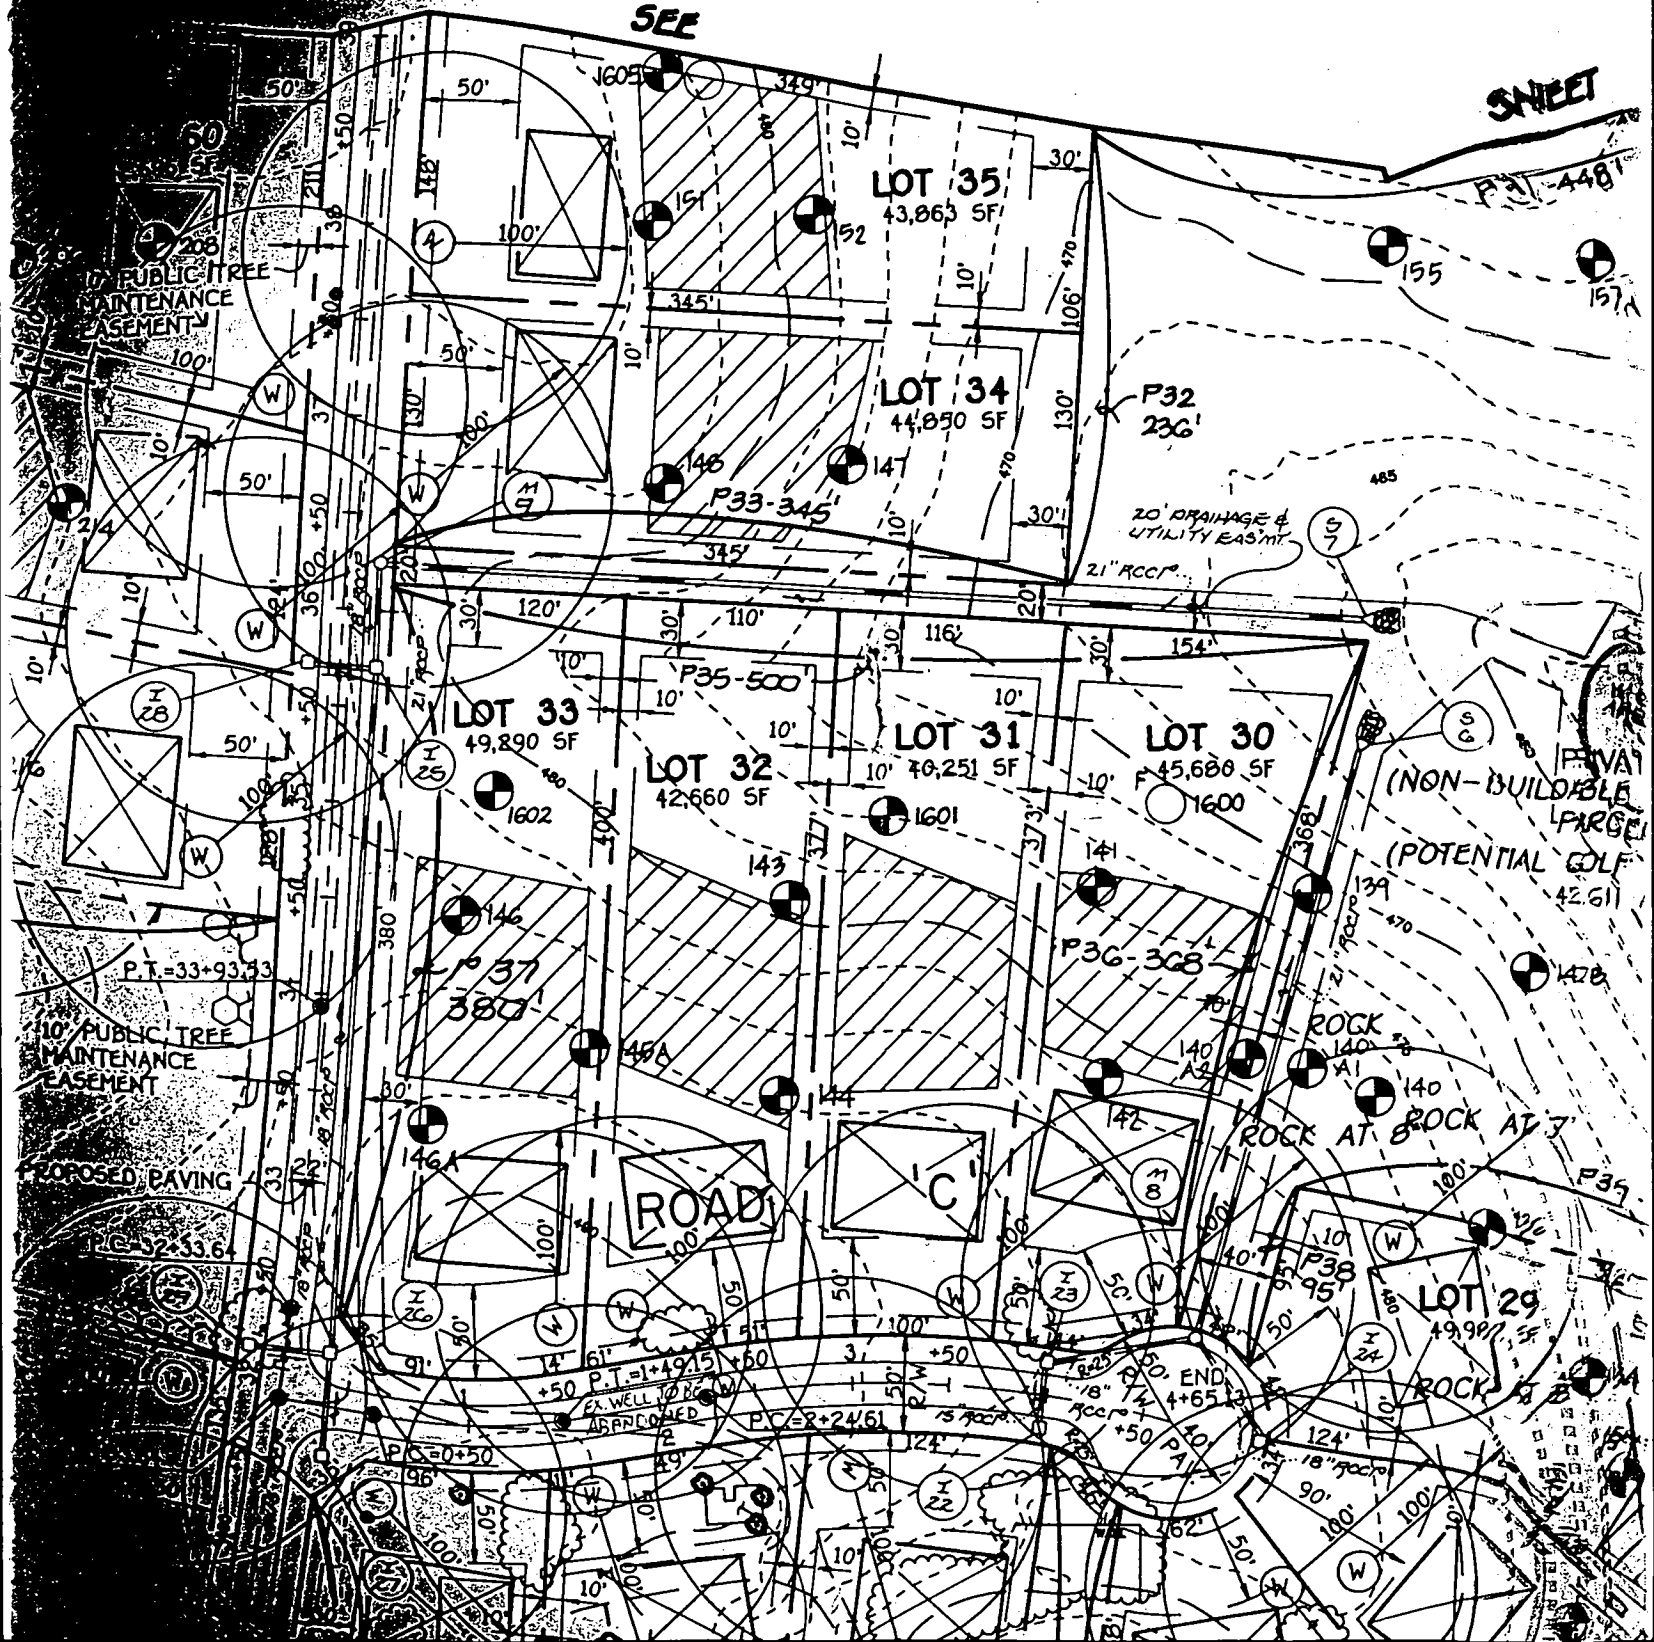

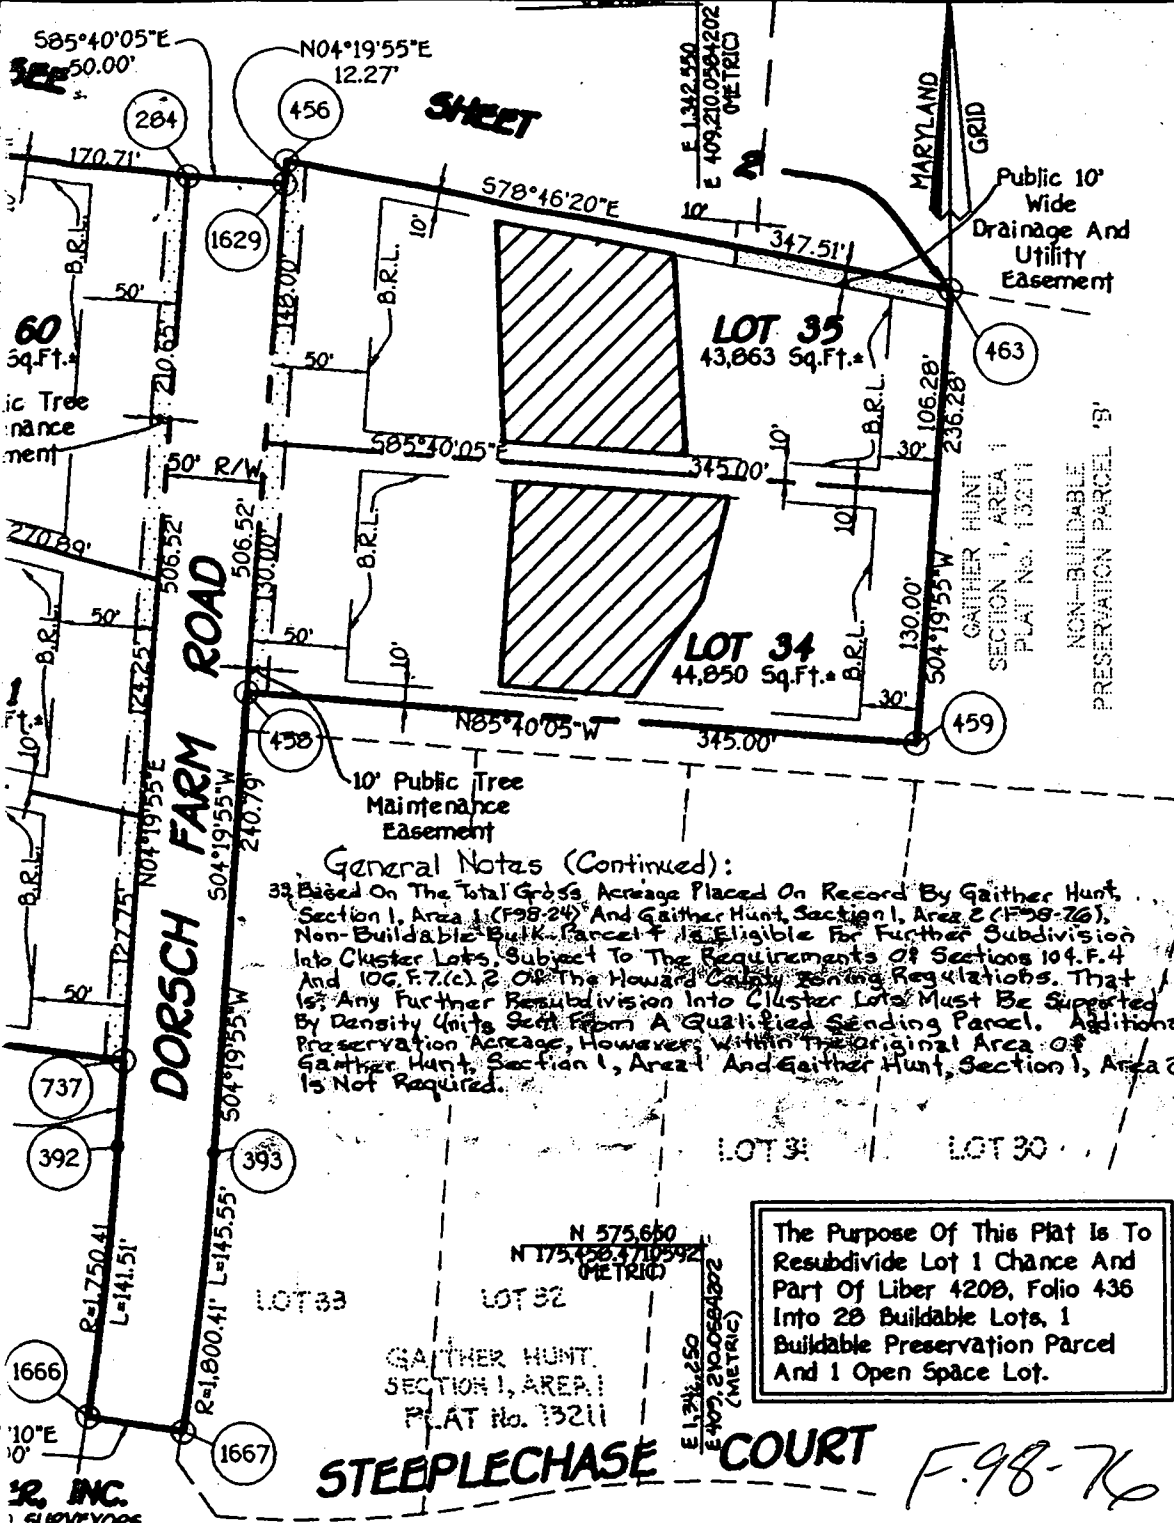

The Purpose Of This Plat Is To Resubdivide Lot 1 Chance And Part Of Liber 4208, Folio 436 Into 28 Buildable Lots, 1 Buildable Preservation Parcel And 1 Open Space Lot.

Owners

Camilla Carroll
 4400 Manor Lane
 Ellicott City, Maryland 21042

Carroll Land Family Corporation
 c/o J. Thomas Scrivener
 8808 Centre Park Drive, Suite 209
 Columbia, Maryland 21045

Developer

Russell Development, LLC
 c/o J. Thomas Scrivener
 8808 Centre Park Drive, Suite 209
 Columbia, Maryland 21045

SURVEYORS CERTIFICATE

I Herby Certify That The Final Plat Shown Hereon Is Correct; That It Is A Subdivision Of And (1) All Of That Land Conveyed By Philip Carroll To Camilla Carroll By Deed Dated June 11, 1988 And Recorded Among The Aforesaid Land Records In Liber 1842 At Folio 431; Said Property Also Being Known As Lot 1 As Shown On A Plat Entitled "Chance Lot 1" And Recorded As Plat No. 6985 And (2) Part Of That Land Conveyed By Philip Carroll To Carroll Land Family Corporation By Deed Dated January 14, 1998 And Recorded Among The Aforesaid Land Records In Liber 4208 At Folio 436. And That All Monuments Are In Place Or Will Be In Place Prior To Acceptance Of The Streets In The Subdivision By Howard County, Maryland, As Shown, In Accordance With The Annotated Code Of Maryland, As Amended, And Monumentation Is In Accordance With The Howard County Subdivision Regulations.

RECORDED AS PLAT AMONG THE LAND R

Buildable
 (A Resubdivision
 "Chance Lot 1" - P

Tax Map

14. All Lot Areas Are More Or Less Measured
15. Distances Shown Are Based On Surface Measurements
16. The Wetlands Delineation Study Was Prepared By Howard County On August, 1996, Under 5-9-96, Under 5-96-18.
17. The Traffic Study Was Prepared By The Traffic Engineering Firm On August, 1996, Under 5-96-18.
18. No Clearing, Grading Or Construction Is Permitted On The Property
19. Previous File Numbers: 5-96-18, P-97-08 / 1996, Under 5-96-18.
20. The Existing Houses And Accessory Structures, Additions Or Modifications To The Existing Structures, Shall Be Subject To The Building Restriction Ordinance
21. This Project Is Subject To Waiver Petition To Improve One Side Of Manor Lane Nor Contain A Wetland Area
22. * Denotes Wetland Area
23. Denotes Centerline Of Existing Street
24. Denotes Approximate Elevation Of 10 Feet
25. Denotes Forest Conservation Easement Established To Fulfill The Requirements Of The Conservation Act. No Clearing, Grading Or Construction Is Allowed. However, Forest Conservation Easement Are Allowed.
26. Denotes Public 10' Wide Tree Maintenance Area Ten Feet In Width, Running Along The Edge Of Subdivision Is Reserved Upon All Easement Allows Howard County The Right Specific Purpose Of Installation, Repair And Maintenance Of Private Lots. No Building On The Said Easement Area.
27. Preservation Parcel 'A' Will Be Privately Owned. Parcel Is Encumbered By An Easement Agreement, Inc. And Howard County, Maryland Which Provides For Maintenance Responsibilities Of The Owner.
28. Density Tabulation
 - A. Total Area Of Submission For Section 1
 - B. Area Utilized For Development Rights
 - 1) The Area Of Bulk Parcel 'A'
 - 2) Support The Density And The Allowed Development Rights For Subdivision
 - C. Allowed Development Rights For Subdivision (55.313 Acres / 4.25 DU/Acre = 36.6 DU)
 - D. Permitted Development Rights Under (55.313 Acres / 2 DU/Acre = 76.6 DU)
 - E. Number Of Proposed Buildable Lots A Section 1, Area 2 = 71 DU.
 - F. Total Number Of Density Rights Required (71 DU. - 36 DU.) = 35 Total DU. (35 CEO Units. - 35 CEO Units Provided)
29. Sending Parcel Information
 1. Tax Map No: 21
 2. Part Of Parcel No: 7
 3. Grid No.: 10
 4. Ownership: E. Alexander Adams and Betty Smith Adams (L. 4346, F. 4347)
30. Articles Of Incorporation Of Gaither Hunt Department Of Assessments And Taxation
31. Open Space Tabulation
 - A. Total Submission Area (Section 1, Area 2)
 - B. Open Space Required = 7.945 Ac. (58.892 Ac.) x 5%
 - C. Open Space Provided = 8.194 Ac. (Lot 53 and Lot 63 Of Gaither Hunt)
 - D. Percentage Of Open Space Provided (8.194 / 7.945) = 103.13%
32. Open Space Lot 53 Is Dedicated To The Subdivision And Recording Referenced Are Recorded In Liber No. 4373 At Folio 100. Using The Cluster Exchange Option (1) The Development Rights For 19 Of The Subdivision Plat Have Been Transferred To A. Nine (9) CEO Units From The Property, Betty Smith Adams, Tax Map 21, Parcel 7, B. Ten (10) CEO Units From Property, Tax Map: 6, Parcel 53, Grid: 21, L. The Creation Of These Lots Is Based On The Density Units Provided For Every Two Acres.

C1 9868 SEQUENCE NO. (MDE USE ONLY)

STATE OF MARYLAND WELL COMPLETION REPORT FILL IN THIS FORM COMPLETELY PLEASE TYPE

THIS REPORT MUST BE SUBMITTED AFTER WELL IS COMPLETED. COUNTY NUMBER A56429 A

ST/CO USE ONLY DATE Received 07 06 99

DATE WELL COMPLETED 06 30 99 Depth of Well 225 (TO NEAREST FOOT)

PERMIT NO. FROM "PERMIT TO DRILL WELL" HO 94 2085

OWNER Russell Development STREET OR RFD Dorsch Farm Road TOWN Ellicott City SUBDIVISION Gaither Hunt SECTION II LOT 35

WELL LOG Table with columns: DESCRIPTION, FEET (FROM, TO), check if water bearing. Includes entries for Brown sandstone, Hard Gray Granite, medium Hard Green Granite, and Hard Gray Granite.

GROUTING RECORD Form with fields for CEMENT (CM), BENTONITE CLAY (BC), NO. OF BAGS (10), NO. OF POUNDS (940), GALLONS OF WATER (60), DEPTH OF GROUT SEAL (38).

CASING RECORD Form with fields for casing types (ST, CO, PL, OT), MAIN CASING TYPE (ST), Nominal diameter (06), Total depth (38).

OTHER CASING (if used) Form with fields for diameter and depth.

SCREEN RECORD Form with fields for screen type (ST, BR, HO, PL, OT) and depth (38).

PUMPING TEST Form with fields for HOURS PUMPED (3), PUMPING RATE (10), METHOD USED TO MEASURE PUMPING RATE (Watch & Bucket), WATER LEVEL (29' before, 79' when), TYPE OF PUMP USED (S - submersible).

PUMP INSTALLED Form with fields for DRILLER INSTALLED PUMP (NO), TYPE OF PUMP INSTALLED (S), CAPACITY (31-35 GPM), PUMP HORSE POWER (37-41), PUMP COLUMN LENGTH (43-47), CASING HEIGHT (+ above, - below).

NUMBER OF UNSUCCESSFUL WELLS (0) WELL HYDROFRACTURED (Y)

CIRCLE APPROPRIATE LETTER: A (well abandoned), E (electric log), P (test well converted).


I HEREBY CERTIFY THAT THIS WELL HAS BEEN CONSTRUCTED IN ACCORDANCE WITH COMAR 26.04.04 "WELL CONSTRUCTION" AND IN CONFORMANCE WITH ALL CONDITIONS STATED IN THE ABOVE CAPTIONED PERMIT...

DRILLERS LIC. NO. MWD 355 DRILLERS SIGNATURE (Max S. Jones) LIC. NO. JWD 341

DEPTH (nearest ft.) 110, 38, 225. SLOT SIZE 1, 2, 3. DIAMETER OF SCREEN (56-60).

GRAVEL PACK IF WELL DRILLED WAS FLOWING WELL INSERT F IN BOX 68

MDE USE ONLY (NOT TO BE FILLED IN BY DRILLER) T (E.R.O.S.) W Q

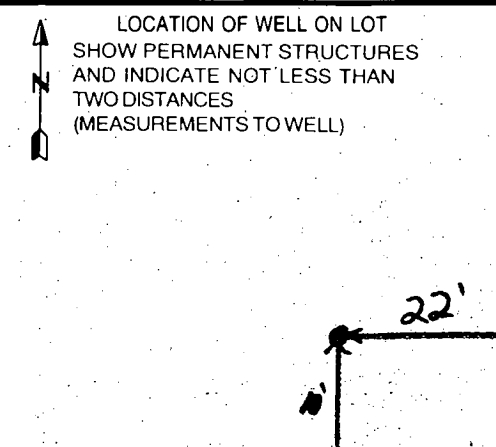

B 1 **5152**

SEQUENCE NO. (MDE USE ONLY)

STATE OF MARYLAND
PERMIT TO DRILL WELL
please print or type

STATE PERMIT NUMBER

HO-94-2085
fill in this form completely

Date Received (APA)
01-29-99

OWNER INFORMATION

Russell Development LLC
Last Name Owner First Name
8808 Centre Park Dr Suite 209
Street or RFD
Columbia MD 21045
Town State Zip

B 3 LOCATION OF WELL

Howard
COUNTY
Gaither Hunt
SUBDIVISION
SECTION **1** LOT **35**
Ellicott City
NEAREST TOWN

MILES FROM TOWN (enter 0 if in town) **4**

DRILLER INFORMATION


MICHAEL BARLOW MW D355
Driller's Name License No.

MICHAEL BARLOW Well Drilling Service Inc
Firm Name

912 FAUN CT Joppa MD 21085
Address

[Signature] **1-22-99**
Signature Date

B 4 DIRECTION OF WELL FROM TOWN (CIRCLE BOX)

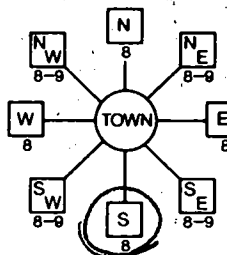

Dorset Farm Rd
NEAR WHAT ROAD

ON WHICH SIDE OF ROAD (CIRCLE APPROPRIATE BOX)

25
DISTANCE FROM ROAD
ENTER FT OR MI

TAX MAP: _____ BLK: _____ PARCEL _____

B 2 WELL INFORMATION

APPROX. PUMPING RATE (GAL. PER MIN.)

5

AVERAGE DAILY QUANTITY NEEDED (GAL. PER DAY)

500

USE FOR WATER (CIRCLE APPROPRIATE BOX)

- DOMESTIC POTABLE SUPPLY & RESIDENTIAL IRRIGATION
- FARMING (LIVESTOCK WATERING & AGRICULTURAL IRRIGATION)
- INDUSTRIAL, COMMERCIAL, DEWATERING
- PUBLIC WATER SUPPLY WELL
- TEST, OBSERVATION, MONITORING
- GEO-THERMAL

NOT TO BE FILLED IN BY DRILLER HEALTH DEPARTMENT APPROVAL

Howard Co **A56429 A**
COUNTY NAME COUNTY NO.

STATE SIGNATURE _____ INSERT S →

DATE ISSUED **021199** **A McMillen** **021100**
MM DD YY EXP. DATE

NORTH GRID **515 000** EAST GRID **830 000**
50 55 57 63

APPROXIMATE DEPTH OF WELL **200** FEET

APPROXIMATE DIAMETER OF WELL **6** NEAREST INCH

METHOD OF DRILLING (circle one)

- BORED (or Augered)
- JETTED
- Jetted & DRIVEN
- AIR-ROTARY
- AIR-PERCussion
- ROTARY (Hydraulic Rotary)
- CABLE
- REVerse-ROTary
- Drive-POINT

REPLACEMENT OR DEEPEMED WELLS (CIRCLE APPROPRIATE BOX)

- THIS WELL WILL NOT REPLACE AN EXISTING WELL
- THIS WELL WILL REPLACE A WELL THAT WILL BE ABANDONED AND SEALED
- THIS WELL WILL REPLACE A WELL THAT WILL BE USED AS A STANDBY-CONTACT LOCAL APPROVING AUTHORITY FOR POLICY ON STANDBY WELLS
- THIS WELL WILL DEEPEM AN EXISTING WELL

PERMIT NUMBER OF WELL TO BE REPLACED OR DEEPEMED (IF AVAILABLE) _____

Not to be filled in by driller (MDE OR COUNTY USE ONLY)

APPROP. PERMIT NUMBER _____ GAP _____

PERMIT No **HO-94-2085**


SHOW MAJOR FEATURES OF BOX & LOCATE WELL WITH AN X

SOURCES OF DRILLING WATER
1.
2.
3.

WRITE THE BOX NUMBER FROM THE MAP HERE

E **830**
N **515**


DRAW A SKETCH BELOW SHOWING LOCATION OF WELL IN RELATION TO NEARBY TOWNS AND ROADS AND GIVE DISTANCE FROM WELL TO NEAREST ROAD JUNCTION

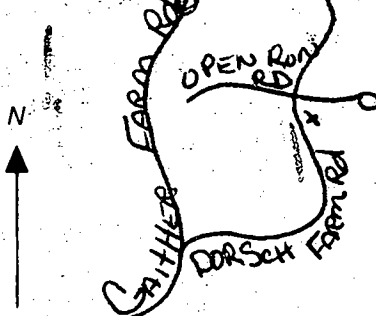

SPECIAL CONDITIONS

NOTE - APPROVING AUTHORITIES SHOULD USE SEPARATE SHEET IF NEEDED

DORSCH FARM ROAD

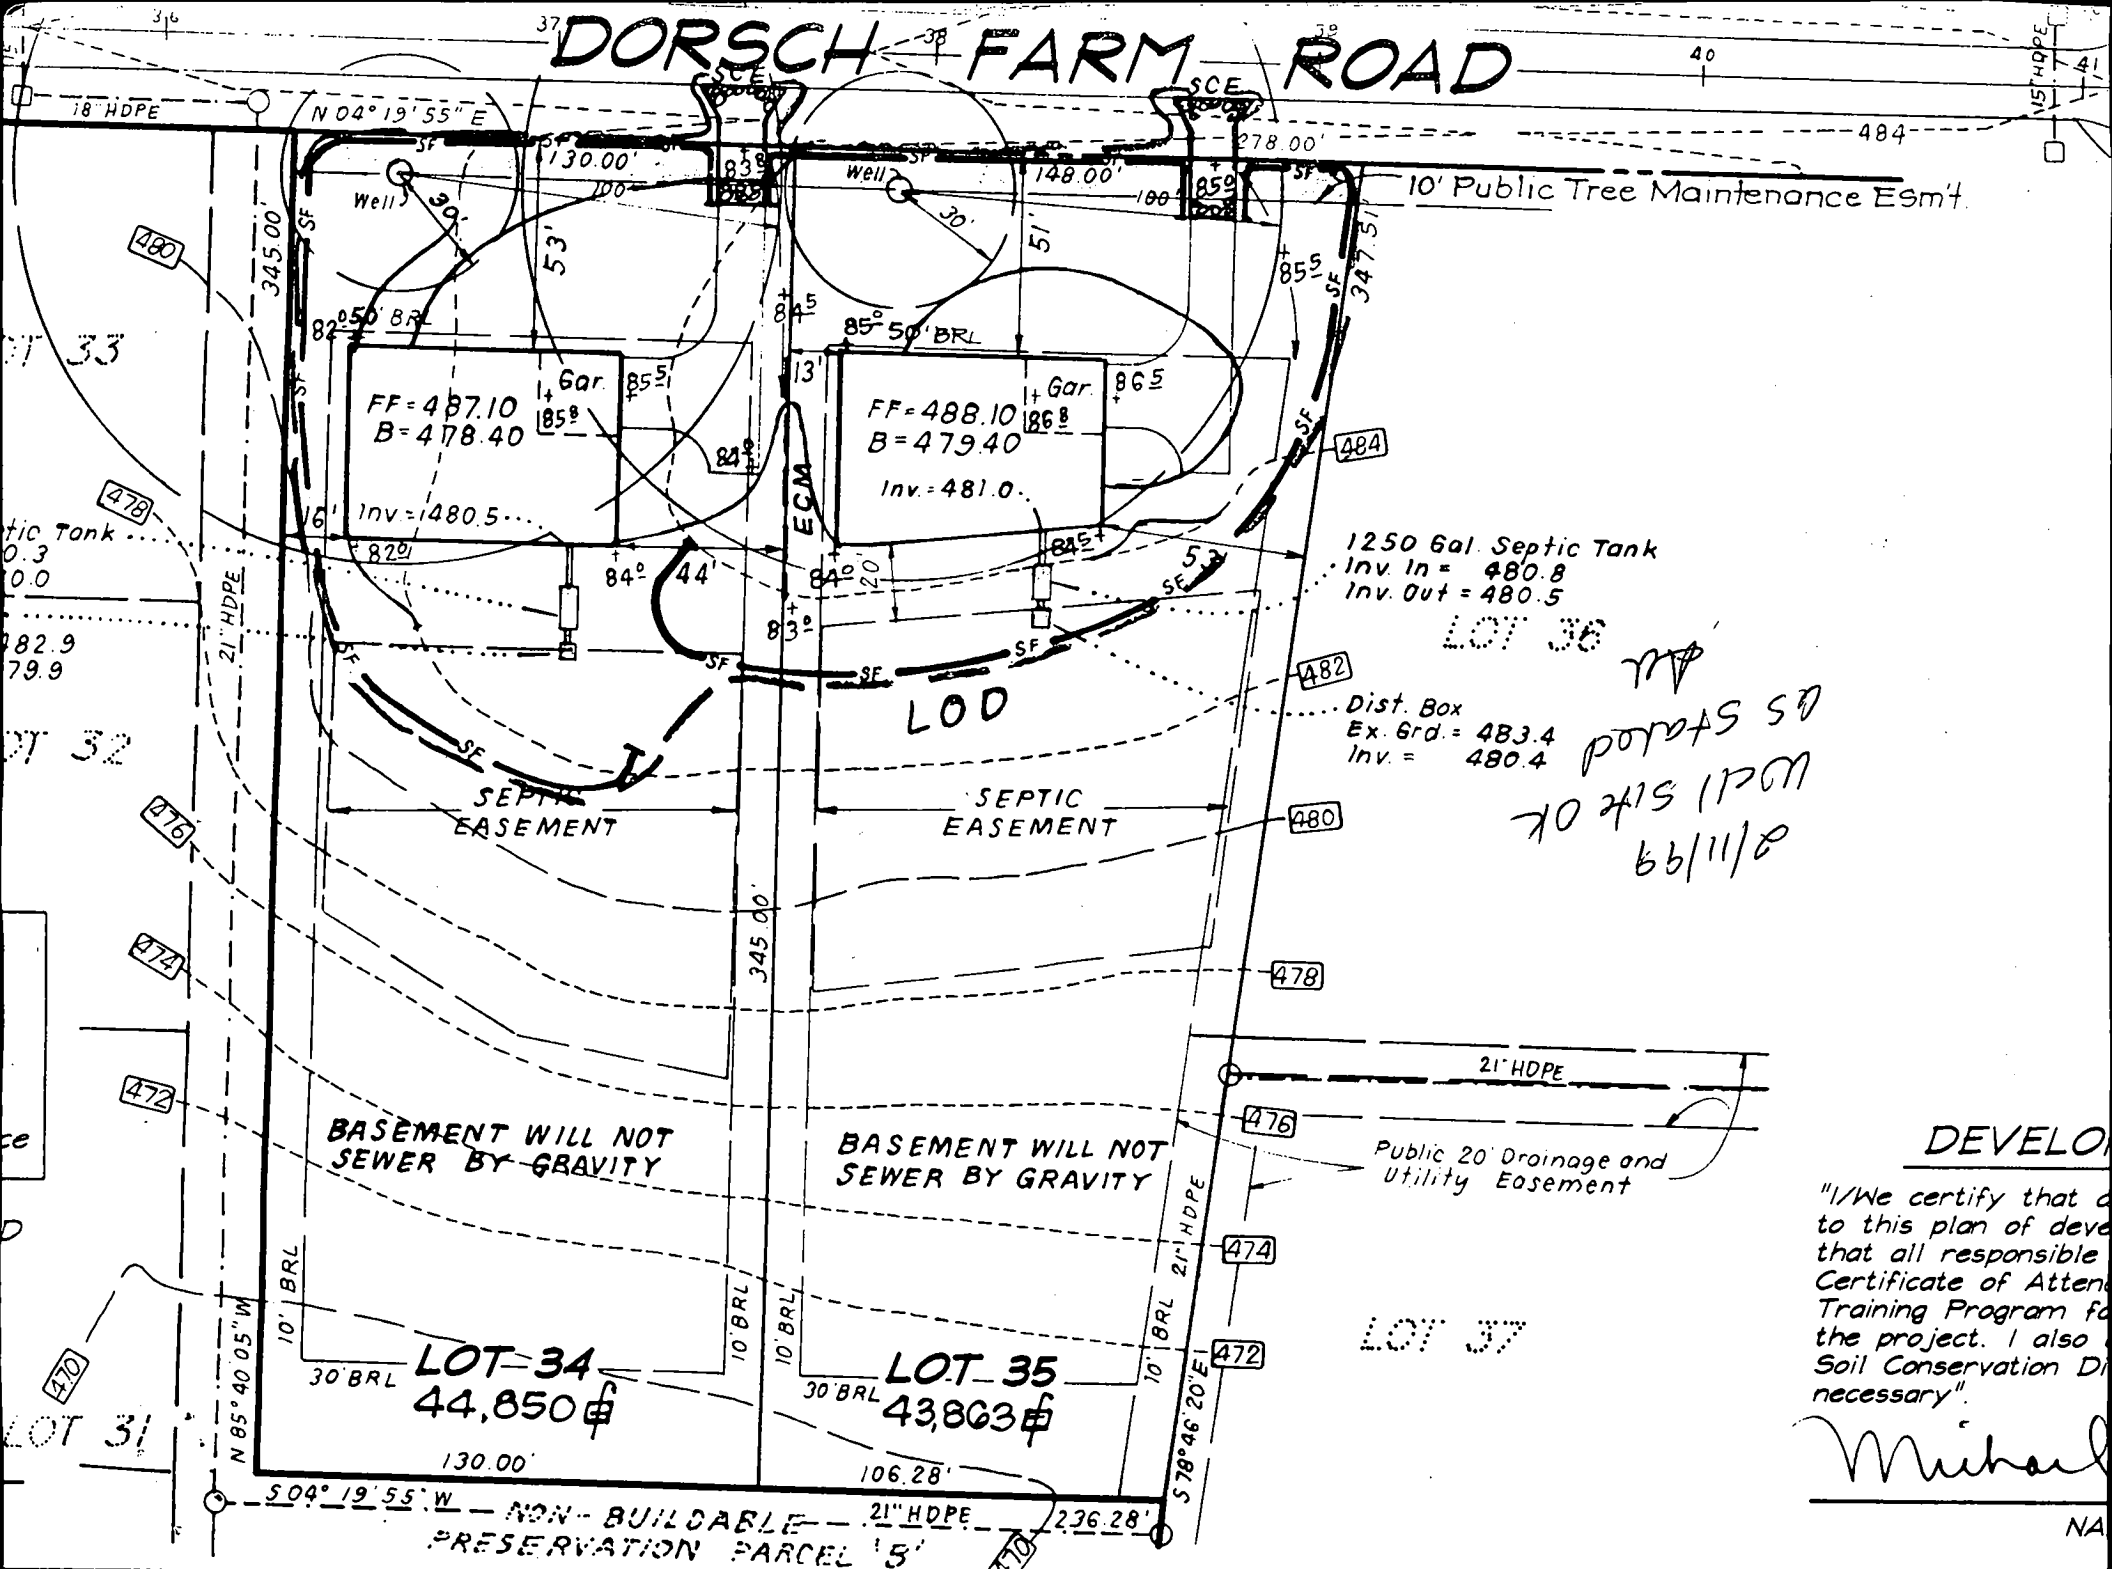

DEVELOPER

"I/We certify that to this plan of development that all responsible Certificate of Attendance Training Program for the project. I also Soil Conservation District necessary".

Michael

NA