

B 1 9172 SEQUENCE NO. (DP USE ONLY)
1 2 3 4 5 6
(THIS NUMBER IS TO BE PUNCHED IN COLS. 3-6 ON ALL CARDS)


STATE OF MARYLAND
PERMIT TO DRILL WELL
please print or type

STATE PERMIT NUMBER
40-88-0882
70 fill in this form completely 79

Date Received (APA) 06/3/89
OWNER INFORMATION
15 Last Name SPRING HILL ASSOC
34 First Name
36 Street or RFD 1423 RT 32
55
57 Town W FRIENDSHIP MD 21794
70 State 72 Zip 76

B 3 LOCATION OF WELL
1 2 HOWARD
8 COUNTY
21 MEADOWOOD
23 SUBDIVISION
SECTION 2 LOT 39
44 46 48 50
52 NEAREST TOWN SYKESVILLE
71
MILES FROM TOWN (enter 0 if in town) 4 MI
73 76 77 78

DRILLER INFORMATION
George F. Easterday
Driller's Name
L. Franklin Easterday, Inc.
77 License No. 80
Firm Name
9265 Brown Church Rd., Mt. Airy, Md. 21771
Address
George F. Easterday 6/8/89
Signature Date

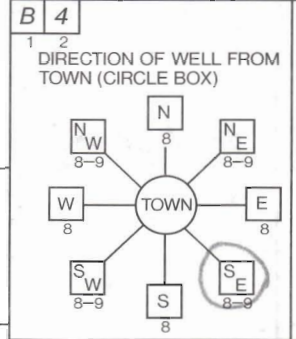

CROWS FOOT RD
11 NEAR WHAT ROAD 30
ON WHICH SIDE OF ROAD (CIRCLE APPROPRIATE BOX)
NORTH
WEST 32 EAST
SOUTH
34 300 37 DISTANCE FROM ROAD
ENTER FT or MI FT
38 39

B 2 WELL INFORMATION
1 2 APPROX. PUMPING RATE (GAL. PER MIN.) 5
8 12
AVERAGE DAILY QUANTITY NEEDED (GAL. PER DAY) 500
14 20

NOT TO BE FILLED IN BY DRILLER HEALTH DEPARTMENT APPROVAL
Howard 38127
COUNTY NAME COUNTY NO.
STATE SIGNATURE DATE ISSUED 7/16/90
07/17/89 Edmy Awe
43 48 CO SIGNATURE EXP. DATE
NORTH GRID 548000 EAST GRID 0818000
50 55 57 63
EXTENDED MR 12/5/89


USE FOR WATER (CIRCLE APPROPRIATE BOX)
 D HOME (SINGLE OR DOUBLE HOUSEHOLD UNIT ONLY)
 F FARMING (LIVESTOCK WATERING & AGRICULTURAL IRRIGATION)
22 I INDUSTRIAL, COMMERCIAL, STATE AND FEDERAL GOV. OTHER (REQUIRES APPROPRIATION PERMIT)
 P PUBLIC OR PRIVATE WATER COMPANY (REQUIRES APPROPRIATION PERMIT AND STATE HEALTH DEPARTMENT APPROVAL)
 T TEST, OBSERVATION, MONITORING (MAY REQUIRE APPROPRIATION PERMIT)

APPROXIMATE DEPTH OF WELL 300 FEET
24 28

SHOW MAJOR FEATURES OF BOX & LOCATE WELL WITH AN X
SOURCES OF DRILLING WATER
1. well
2.
3.
WRITE THE BOX NUMBER FROM THE MAP HERE
E 8018
N 5408
000
000

APPROXIMATE DIAMETER OF WELL 6 INCH
NEAREST INCH
METHOD OF DRILLING (circle one)
BORED (or Augered) JETTED Jetted & DRIVEN
30 AIR-ROtary AIR-PERcussion ROTARY (Hydraulic Rotary)
37 CABLE REVerse-ROtary DRive-POINT
other

REPLACEMENT OR DEEPEMED WELLS (CIRCLE APPROPRIATE BOX)
 N THIS WELL WILL NOT REPLACE AN EXISTING WELL
 Y THIS WELL WILL REPLACE A WELL THAT WILL BE ABANDONED AND SEALED
39 S THIS WELL WILL REPLACE A WELL THAT WILL BE USED AS A STANDBY
 D THIS WELL WILL DEEPEMED AN EXISTING WELL
PERMIT NUMBER OF WELL TO BE REPLACED OR DEEPEMED (IF AVAILABLE) 41 52

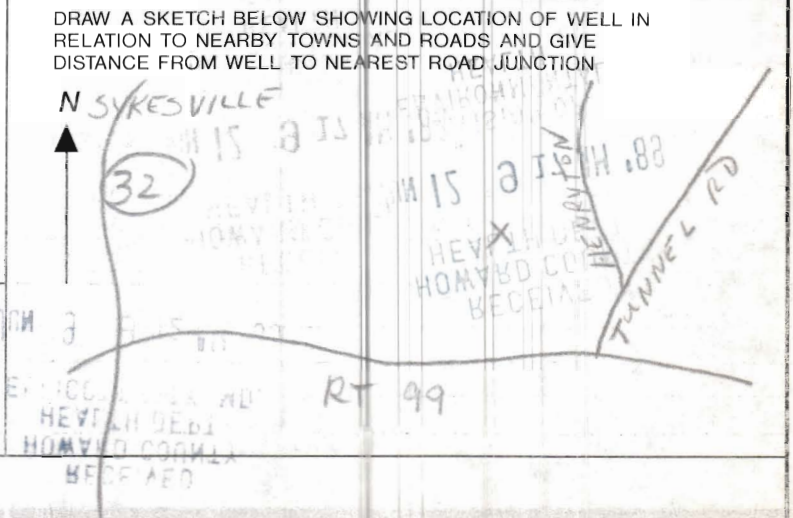

Not to be filled in by driller (OEP USE ONLY)
APPROP. PERMIT NUMBER GAP
54 63
FORCE STA WRITE INITIALS IN BOX PERMIT No. 40-88-0882
67 68 70 71 72 73 74 75 76 77 78 79

SPECIAL CONDITIONS

550

N.E. STATE GRID

520

510

17

19

LIMIT OF SUBMISSION

S 49°04'26"E 401.10

38

37

S 58°11'31"E 331.03

215.75

50.00

50.00

75' P.R.L.

500

B.R.L.

38

B.R.L.

39

520

530

37

510

33

2100.75

LIMIT OF SUBMISSION

N 34°21'36"E 806.62

WELL

WELL

S 44°35'51"E 270.00

100' P.R.L.

95.75

147.40

N 09°42'35"W 300.81

N 09°42'50"W 31.00

S 54°21'04"E 233.40

122.27

S 43°24'22"E

120.80

147.45

250.25

L=234.44

L=600.128

R=1975.00

R=2025.00

1785

59

41

375.55

WELL

530

51

520

40

3.022

50

L=71.10

580

B.R.L.

52

180' P.R.L.

180' P.R.L.

R=2025.00

R=2025.00

R=2025.00

2



L. FRANKLIN EASTERDAY, INC.

WELL DRILLING - TRENCHING - PUMPS & SERVICE

9265 Brown Church Rd., Mt. Airy, Maryland 21771

PHONE 829-1640

December 1, 1989

Craig Williams
Howard County Health Department
Box 476
Ellicott City, Md. 21043

Re: Meadowood Subdivision

Dear Mr. Williams:

Please renew the following well permits for another six months.

Lot 38	HO-88-0881 ✓
Lot 39	HO-88-0882 ✓
Lot 40	HO-88-0883 ✓
Lot 41	HO-88-0884 ✓
Lot 42	HO-88-0885 ✓
Lot 43	HO-88-0886 ✓
Lot 44	HO-88-0887 ✓
Lot 45	HO-88-0888 ✓
Lot 46	HO-88-0889 ✓
Lot 47	HO 88-0890 ✓
Lot 48	HO 88-0891 ✓
Lot 49	HO 88-0892 ✓
Lot 50	HO-88-0893 ✓

ALL OK
MR 12/5/89
EXT. TO 7/16/90

Thank you for your cooperation in this matter.

Very truly yours,

George F. Easterday
George F. Easterday, CWD/PI
Vice President

GFE/se