

10/16/78

File

# PERMIT

P 28161

A 26188

SEWAGE DISPOSAL SYSTEM

MARYLAND STATE DEPARTMENT OF HEALTH\*

HOWARD COUNTY

03-284735

ELLICOTT CITY

DISTRICT 3rd

## INDEXED

DATE 6/7/78

Edward Weston IS PERMITTED TO INSTALL X ALTER

ADDRESS 502 Seminole Ave., Balto., Md. 21228 PHONE 747-6368

SUBDIVISION Roy Emory prop. ROAD 1348 Crows Foot Rd LOT 13B  
~~1427 Route 32~~

PROPERTY OWNER Edward Weston

ADDRESS same as above

SPECIFICATIONS 3 bedrooms

SEPTIC TANK CAPACITY 1000 GALLONS

DRAIN FIELD \_\_\_\_\_ DEPTH \_\_\_\_\_ FEET, BOTTOM AREA \_\_\_\_\_ SQ. FT.

DEEP TRENCH \_\_\_\_\_ DEPTH \_\_\_\_\_ FEET, BOTTOM AREA \_\_\_\_\_ SQ. FT.

SEEPAGE PITS \_\_\_\_\_ ABSORBENT SIDE-WALL AREA 120 SQ. FT. per bedroom

INLET PIPE 4 FT. BELOW ORIGINAL GRADE. MAXIMUM DEPTH 12 FT. BELOW ORIGINAL GRADE

EFFECTIVE DEPTH AT \_\_\_\_\_ FT. BELOW ORIGINAL GRADE.

LOCATE DISPOSAL AREA 195 FT. FROM left LOT LINE AND 170 FT. FROM back LOT LINE AS SEEN WHEN FACING LOT FROM the front lot line.

NOTE: the front lot line is 813.42' long and runs N 50° 36' 55". The back lot line is 460.23' long and runs S 58° 23' 06E.

PLANS APPROVED BY Raymond Hodges DATE \_\_\_\_\_

COVER NO WORK UNTIL INSPECTED AND APPROVED.

NEITHER THE HOWARD COUNTY COUNCIL NOR THE HEALTH DEPARTMENT IS RESPONSIBLE FOR THE SUCCESSFUL OPERATION OF ANY SYSTEM.

NOTE: IF TRENCH IS USED CALL FOR INSPECTION BEFORE PLACING GRAVEL IN TRENCH.

NOTE: NO DRY WELL SHALL EXCEED 15 FOOT IN DIAMETER.


NOTE: ALL PIPE FROM HOUSE TO DISPOSAL AREA MUST BE CAST IRON.

PERMIT VOID AFTER THREE YEARS.

NOTE: INSTALL STAND PIPE ON SEPTIC TANK AND DRY WELL. STAND PIPES MUST BE 6 INCHES IN DIAMETER. CAST IRON, CONCRETE OR TERRA COTTA ACCEPTED.

**\*INSTALLER IS RESPONSIBLE FOR OBTAINING FINAL APPROVAL ON THIS PERMIT.**

26188

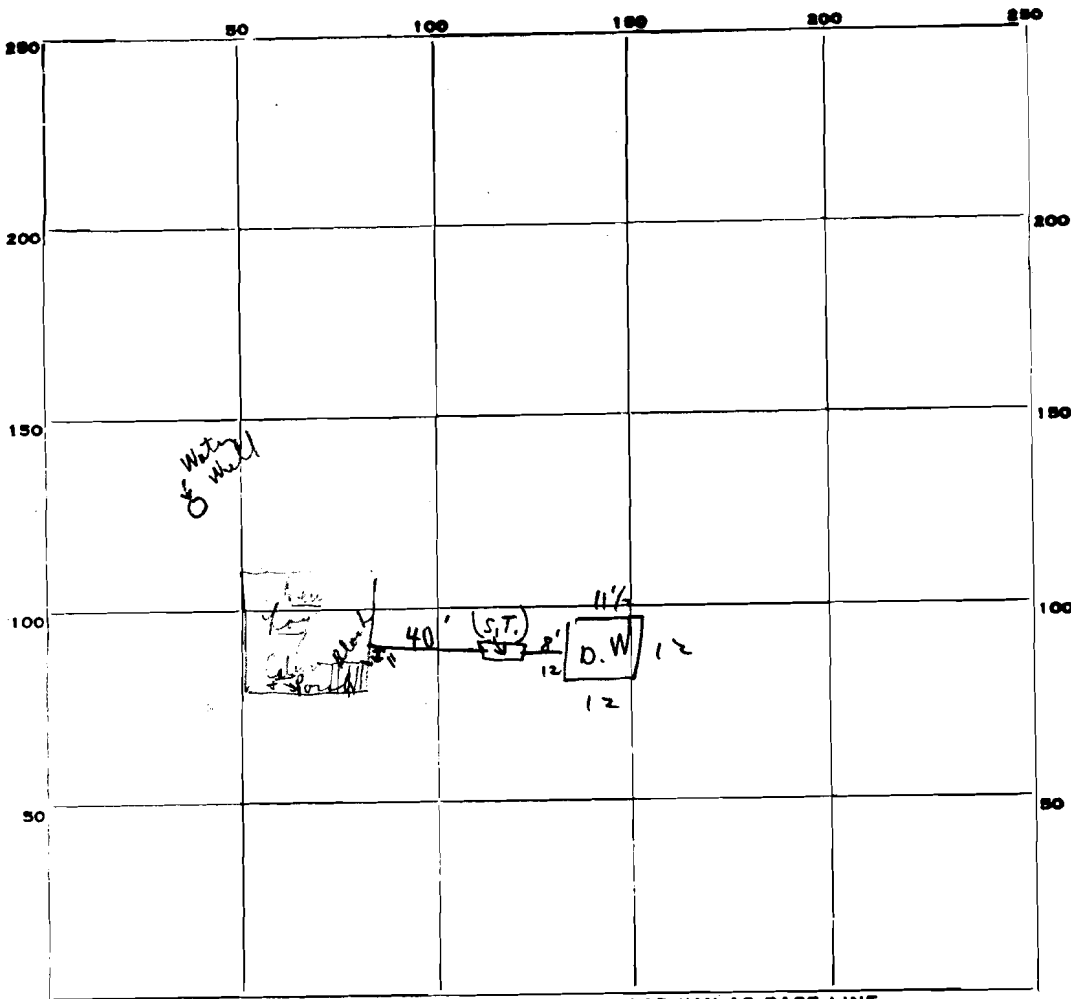

12' 3"  
3' 0"  
8'

PERMIT CARD Yes on these

SEPTIC TANK, LEVEL ok CLEANOUTS 

S.T.	D.W.
C.I.	C.I.
ok	ok

DISTRIBUTION BOX, LEVEL N/A

TILE FIELD, DEPTH      FT. TRENCH WIDTH      FT.

GRAVEL DEPTH      IN. TOTAL LENGTH      FT.

NUMBER OF TRENCHES      TOTAL BOTTOM AREA     

SEEPAGE PITS, INSIDE DIAMETER 47.5 FT. DEPTH BELOW INLET 8 FT. 380'

ABSORBENT AREA 380 ± SQ. FT.

REMARKS 10/16/78 Area between house and Tanks covered over  
the stop - uncovered while present at joints. C.I. ok  
water level all year drain to S.T. C.B.S.

DATE SYSTEM APPROVED 10/16/78 INSPECTOR C. B. Stecker