

APPLICATION

PERCOLATION TESTING

A 38137

P _____

HOWARD COUNTY HEALTH DEPARTMENT
BUREAU OF ENVIRONMENTAL HEALTH
P.O. BOX 476 ELLICOTT CITY, MARYLAND 21043
TELEPHONE: 461-9933

DISTRICT _____

DATE 11/28/86

TO: THE COUNTY HEALTH OFFICER
ELLICOTT CITY, MARYLAND

I, HEREBY, APPLY FOR THE NECESSARY TEST IN ORDER TO CONSTRUCT (OR RECONSTRUCT) A SEWAGE DISPOSAL SYSTEM.

PROPERTY OWNER (Deborah Snouell) Springhill Associates - c/o D.S. Thaler & Associates, Inc.

ADDRESS 11 Warren Road, Baltimore, MD 21208 PHONE 461-5308 (301) 484-4100

PROSPECTIVE BUYER N/A

ADDRESS _____ PHONE _____

PROPERTY LOCATION:

SUBDIVISION Meadowood SEC. 2 AREA 3 LOT NO. 30 LOT 59

ROAD AND DESCRIPTION Henryton Road - approximately 4000' north of Tunnel Road
Howard County, Maryland (1352 Cross Foot Road)

TAX MAP 10 PARCEL # 139

SIZE OF LOT 3+ Acres TYPE BLDG. Single Family
(SINGLE FAMILY DWELLING OR COMMERCIAL)

THE SYSTEM INSTALLED UNDER THIS APPLICATION IS ACCEPTABLE ONLY UNTIL PUBLIC FACILITIES BECOME AVAILABLE. I FULLY UNDERSTAND THE FEE CONNECTED WITH THE FILING OF THIS PERC TEST APPLICATION IS NON-REFUNDABLE UNDER ANY CIRCUMSTANCES. I ALSO AGREE TO COMPLY WITH ALL M.O.S.H.A. REQUIREMENTS IN TESTING THIS LOT.

Mike Seiff
(SIGNATURE OF APPLICANT)

APPROVED BY _____ FOR _____ DATE _____


REJECTED BY _____ FOR _____ DATE _____

HOLD PENDING FURTHER TESTS _____ DATE _____

REASONS FOR REJECTION OR HOLDING H1687 Pnc. SATISFACTORY; hold for subdivision PAT. S. Hall

BLDG. PERMIT ~~ISSUED~~
AND RETURNED 11/2/95
Serial # 57836
SFD-4/Bonus

THIS IS NOT A PERMIT

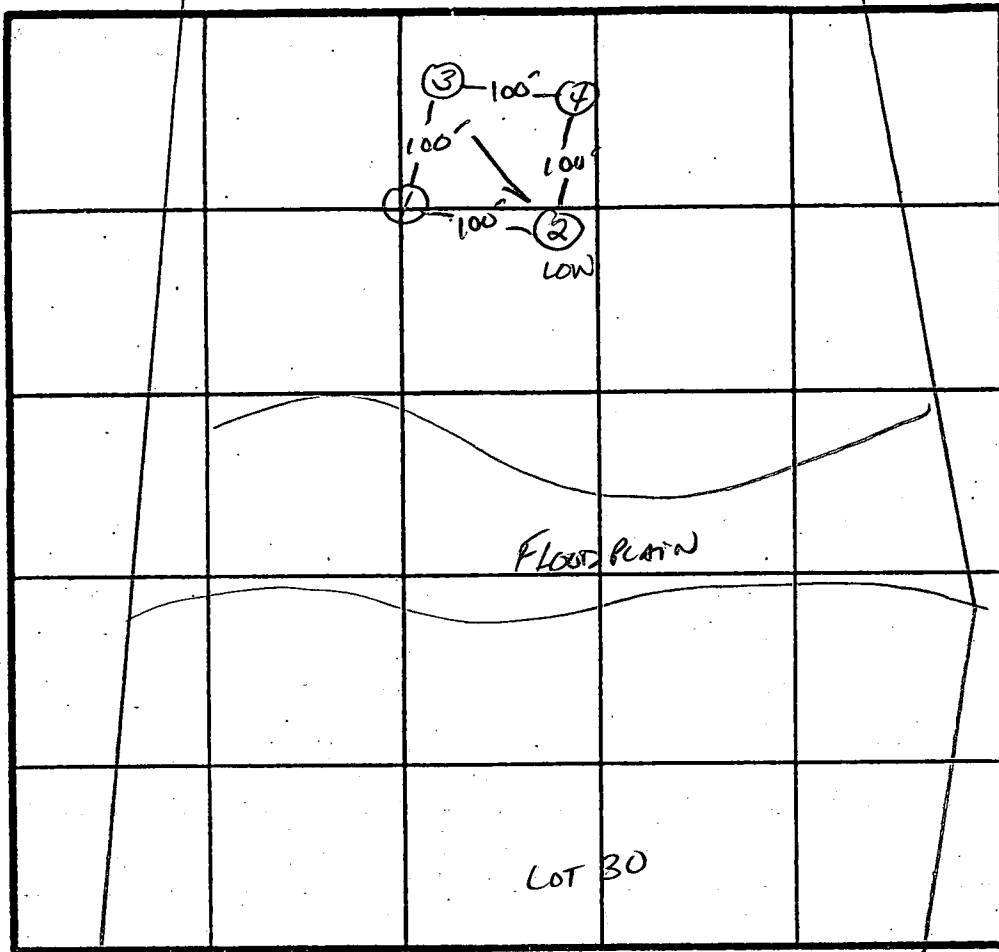

2 PERC
 4 MIN
 160# / BK
 INLET 3.5
 BOTTOM 8.5

SOIL PROFILE
 ① ② ③ ④
 4'-6" AI-3
 Red yellow
 silty clay
 loam; 7-12%
 clay; 10-15%
 frags
 3.5' Yellow BR
 to TAN
 silty loam
 15-20%
 frags
 micaceous
 frags
 increase
 to 25-30%
 at bottom
 13'


INDICATE NORTH - NAME ADJOINING ROADWAY AS BASE LINE.

V. TO 108

DATE	TEST NO.	DEPTH	PRE-WET		TEST - 1" DROP		TIME
			START	STOP	START	STOP	
1/14/87	1 S	4"	10:13	10:14	10:14	10:17	3 min
	1 V	13"	UNIFORM SOIL below		3.5'		
	2 S	4.0"	10:29	10:30	10:30	10:31	1 min
	2 V	13"	SAME AS #1				
	3 S	4.5"	10:18	10:19	10:19	10:21	2 min
	3 V	13"	SAME AS #1 w/ DEEPER CLAY		4.0'	more frags	30-35%
	4 S	3"	10:23	10:27	10:27	10:35	8 min
	4 M	7"	10:23	10:24:30	10:24:30	10:27:30	3 min
	4 V	13"	SAME AS #1 w/ LESS FRAGS		10-15%	Below 3"	

REMARKS Holes Per Plat
 TYPE OF SOIL Chester
 TESTED BY S. Abel ALSO PRESENT Rocky, Ed, Bill

EH-12-1079

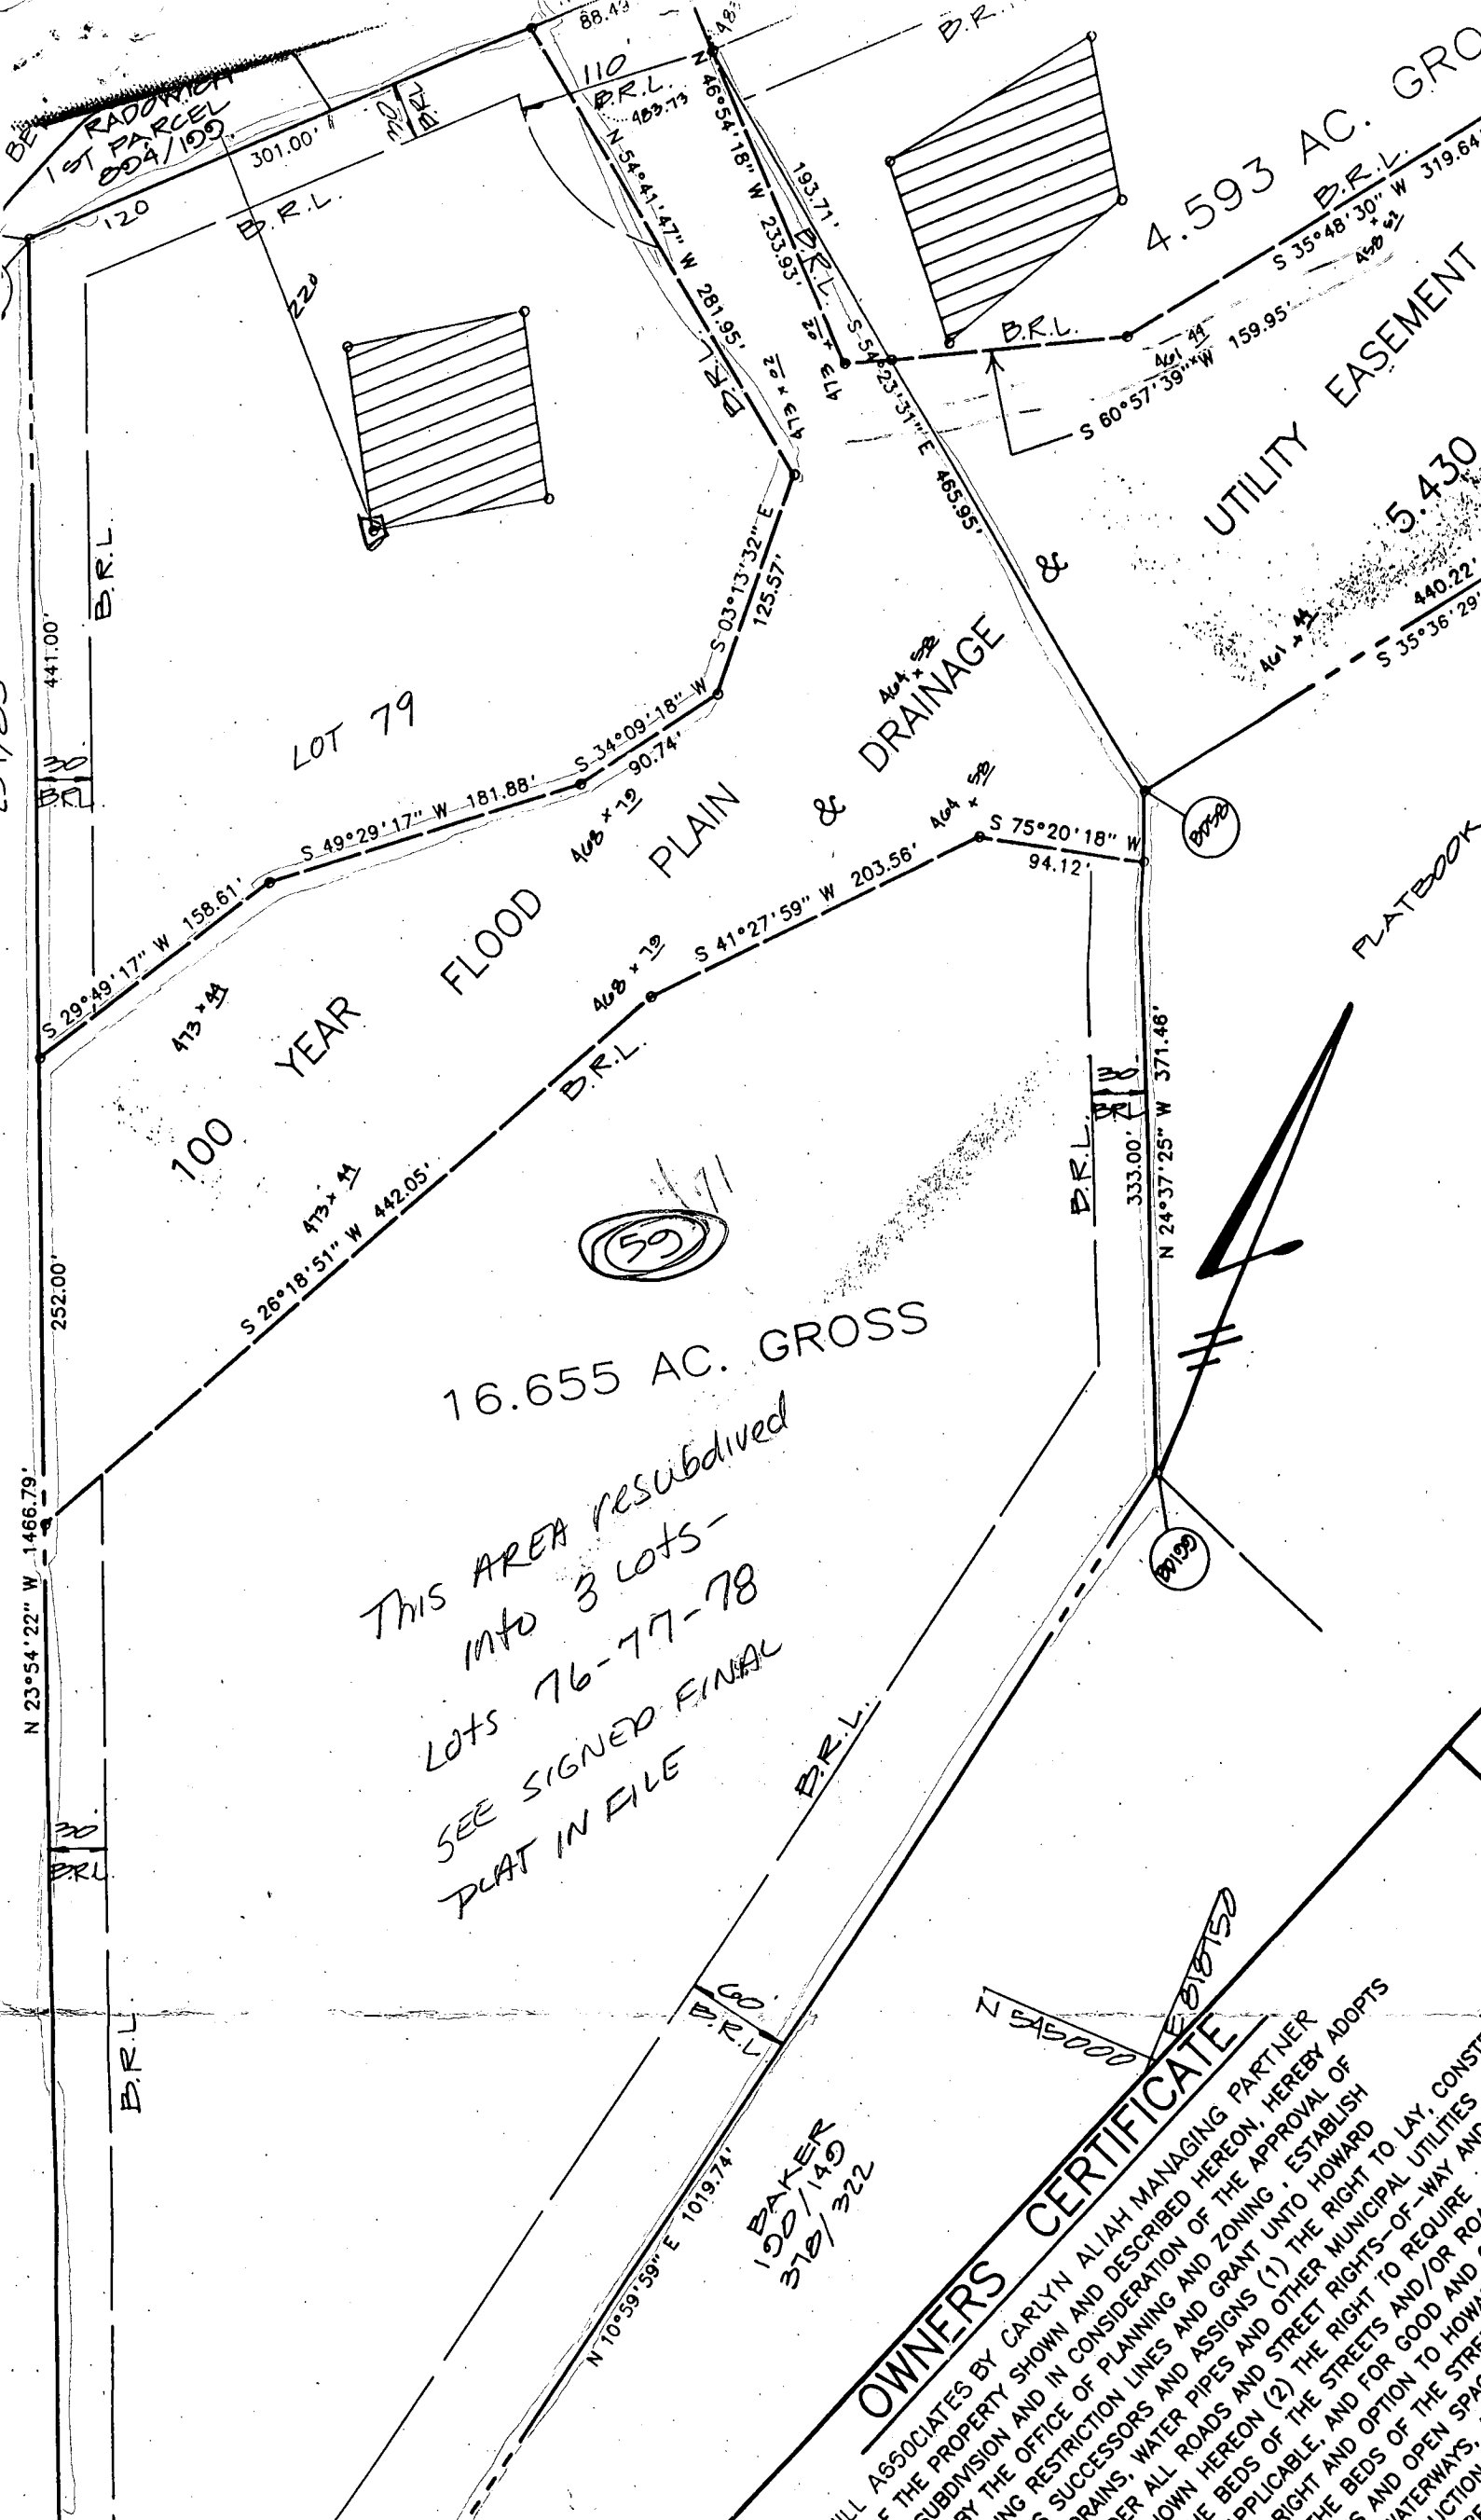

BE RADDON
1ST PARCEL
004/100

4.593 AC. GROSS

LOT 79

100 YEAR FLOOD PLAIN & DRAINAGE

16.655 AC. GROSS

THIS AREA RESUBDIVED
INTO 3 LOTS -
LOTS 76-77-78 -
SEE SIGNED FINAL
PLAT IN FILE

BAKER
100/140
378/322

OWNERS CERTIFICATE

HILL ASSOCIATES BY CARLYN ALIAH MANAGING PARTNER
OF THE PROPERTY SHOWN AND DESCRIBED HEREON, HEREBY CON-
SUBDIVISION AND IN CONSIDERATION OF THE APPROVAL OF
BY THE OFFICE OF PLANNING AND ZONING, HEREBY ADOPTS
ITS RESTRICTION LINES AND GRANT UNTO HOWARD
DRAINS, WATER PIPES AND OTHER MUNICIPAL UTILITIES
UNDER ALL ROADS AND STREET RIGHTS-OF-WAY AND
SHOWN HEREON (2) THE RIGHT TO REQUIRE
THE BEDS OF THE STREETS AND FOR GOOD AND
APPLICABLE, AND OPTION TO HOWARD
RIGHT AND OPTION TO HOWARD
THE BEDS OF THE STREETS
AND OPEN SPAC
WATERWAYS, A
CONSTRUCTION

FLATBOOK

UTILITY EASEMENT

5.430

(59)

(59)

(59)

(59)

1" = 50'

25/100

252.00'

N 23°54'22" W 1466.79'

70

B.R.L.

B.R.L.

B.R.L.

441.00'

70

B.R.L.

473 x 34

473 x 34

120

301.00'

220

88.43

110

B.R.L.

409.73

N 54°41'47" W 281.95'

B.R.L.

473 x 34

473 x 34

LOT 59 was resubdivided into 4 lots -

Lot 76, 77, 78, & 79

Copy of signed final plat

