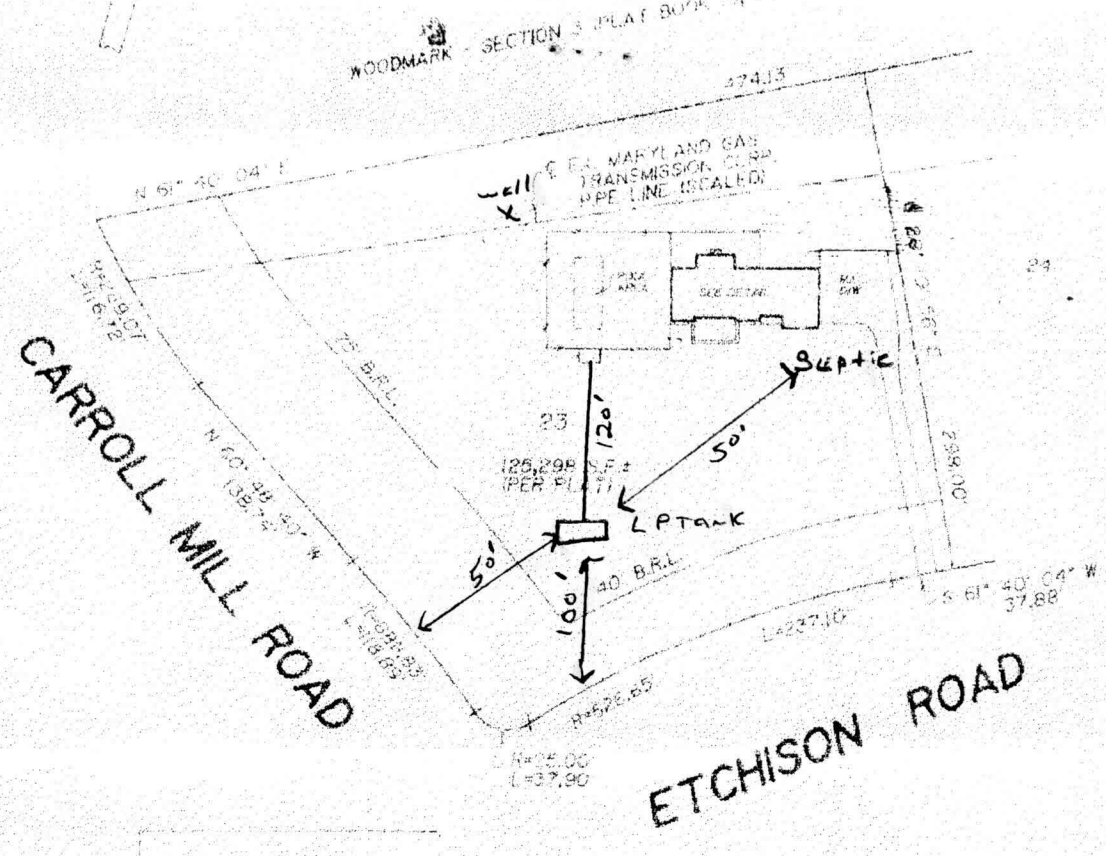

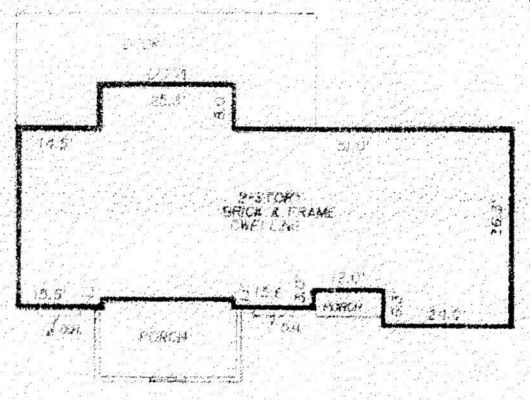

DETAIL SCALE= 1" = 30'

NOTE:

A PROPERTY LINE SURVEY IS RECOMMENDED TO DETERMINE THE EXACT LOCATION OF IMPROVEMENTS AND/OR ENCROACHMENTS, IF ANY.

NOTE: THIS PROPERTY LIES IN FLOOD ZONE C, AN AREA OF MINIMAL FLOODING, AS DELINEATED ON THE MAPS OF THE NATIONAL FLOOD INSURANCE PROGRAM

Install (1) 500 Gallon ASME Underground LP Tank, Per NFPA 58

STATE OF MARYLAND PROPERTY LINE SURVEYOR

12177 ETCHISON ROAD

LOT	23	BLOCK	E
PLAT (SUBDIVISION)	WOODMARK		
ELECTION DISTRICT	HOWARD CO.	SCALE	1" = 100'
PLAT BOOK	29	FOLIO	64
DATE	4-29-2001	CASE NO.	2146
JOB NO.	DH 10005		