BENCHMARK

ENGINEERS △ LAND SURVEYORS △ PLANNERS

ENGINEERING, INC.

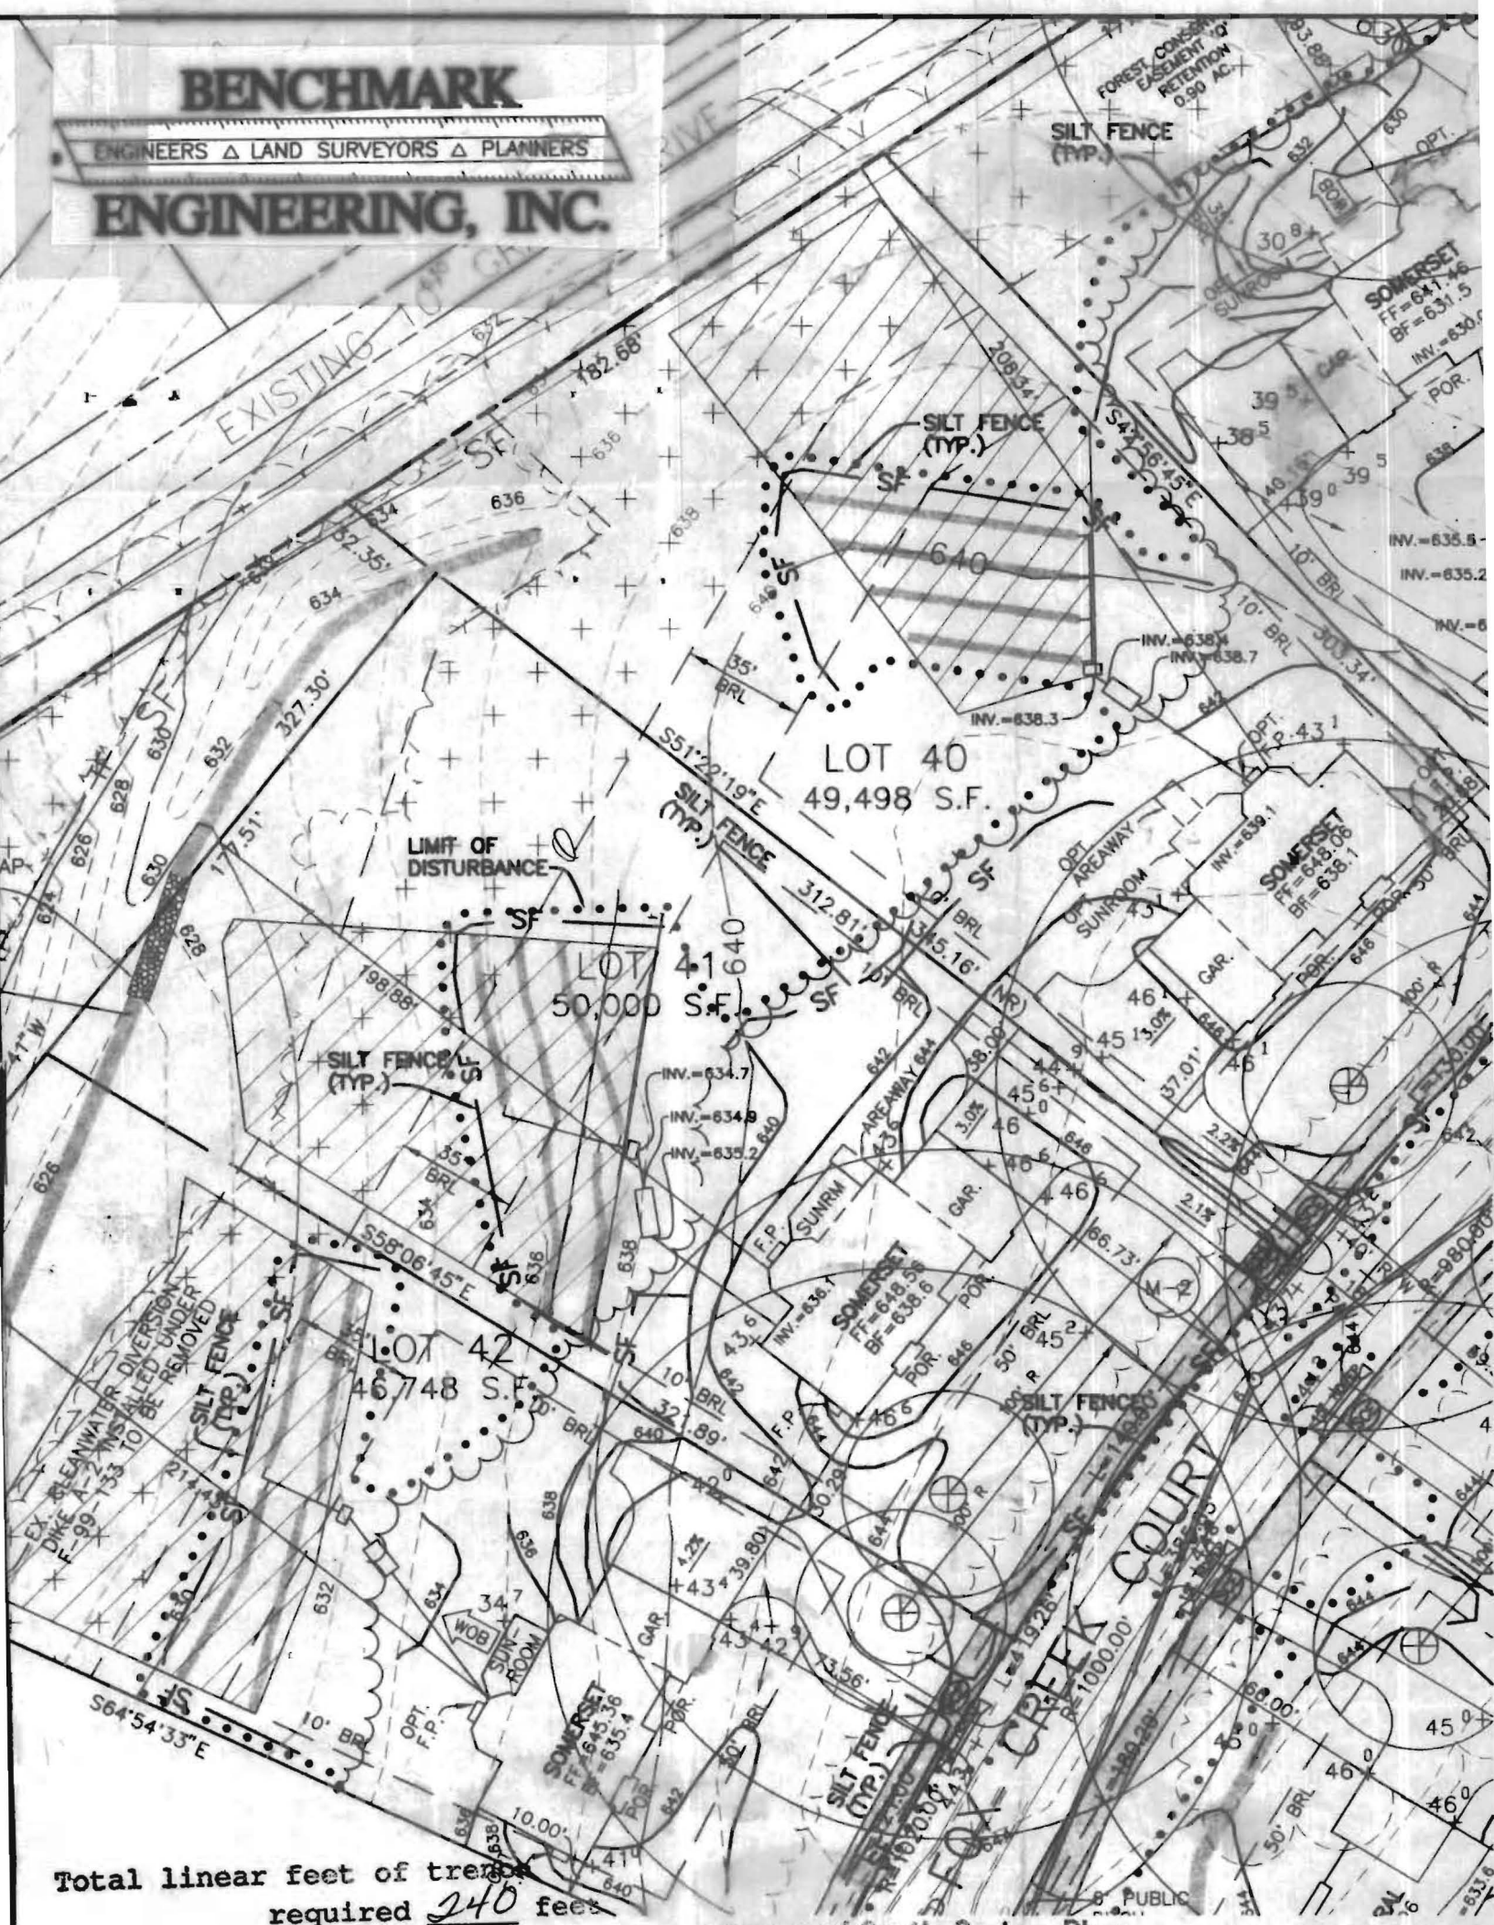

Total linear feet of trench required 240 feet

Width of trench(es) 3.0 feet

Depth of trench(es) 6.0 feet

Depth of stone required below distribution pipe 2.0 feet

Approved Septic System Plan
Howard County Health Department

Signature: Amy M. Mell Date: 6/2/01

12' (14' FOR UIC ACCESS)

RIGHT OF WAY LINE

DITCH FLOW LINE

NOTES:

1. DRIVEWAY MUST BE PAVED FROM EDGE OF PUBLIC ROAD TO RIGHT OF WAY LINE USING STANDARD PAVING SECTION P-1 AS SHOWN ON ST'D NO. R-2.01