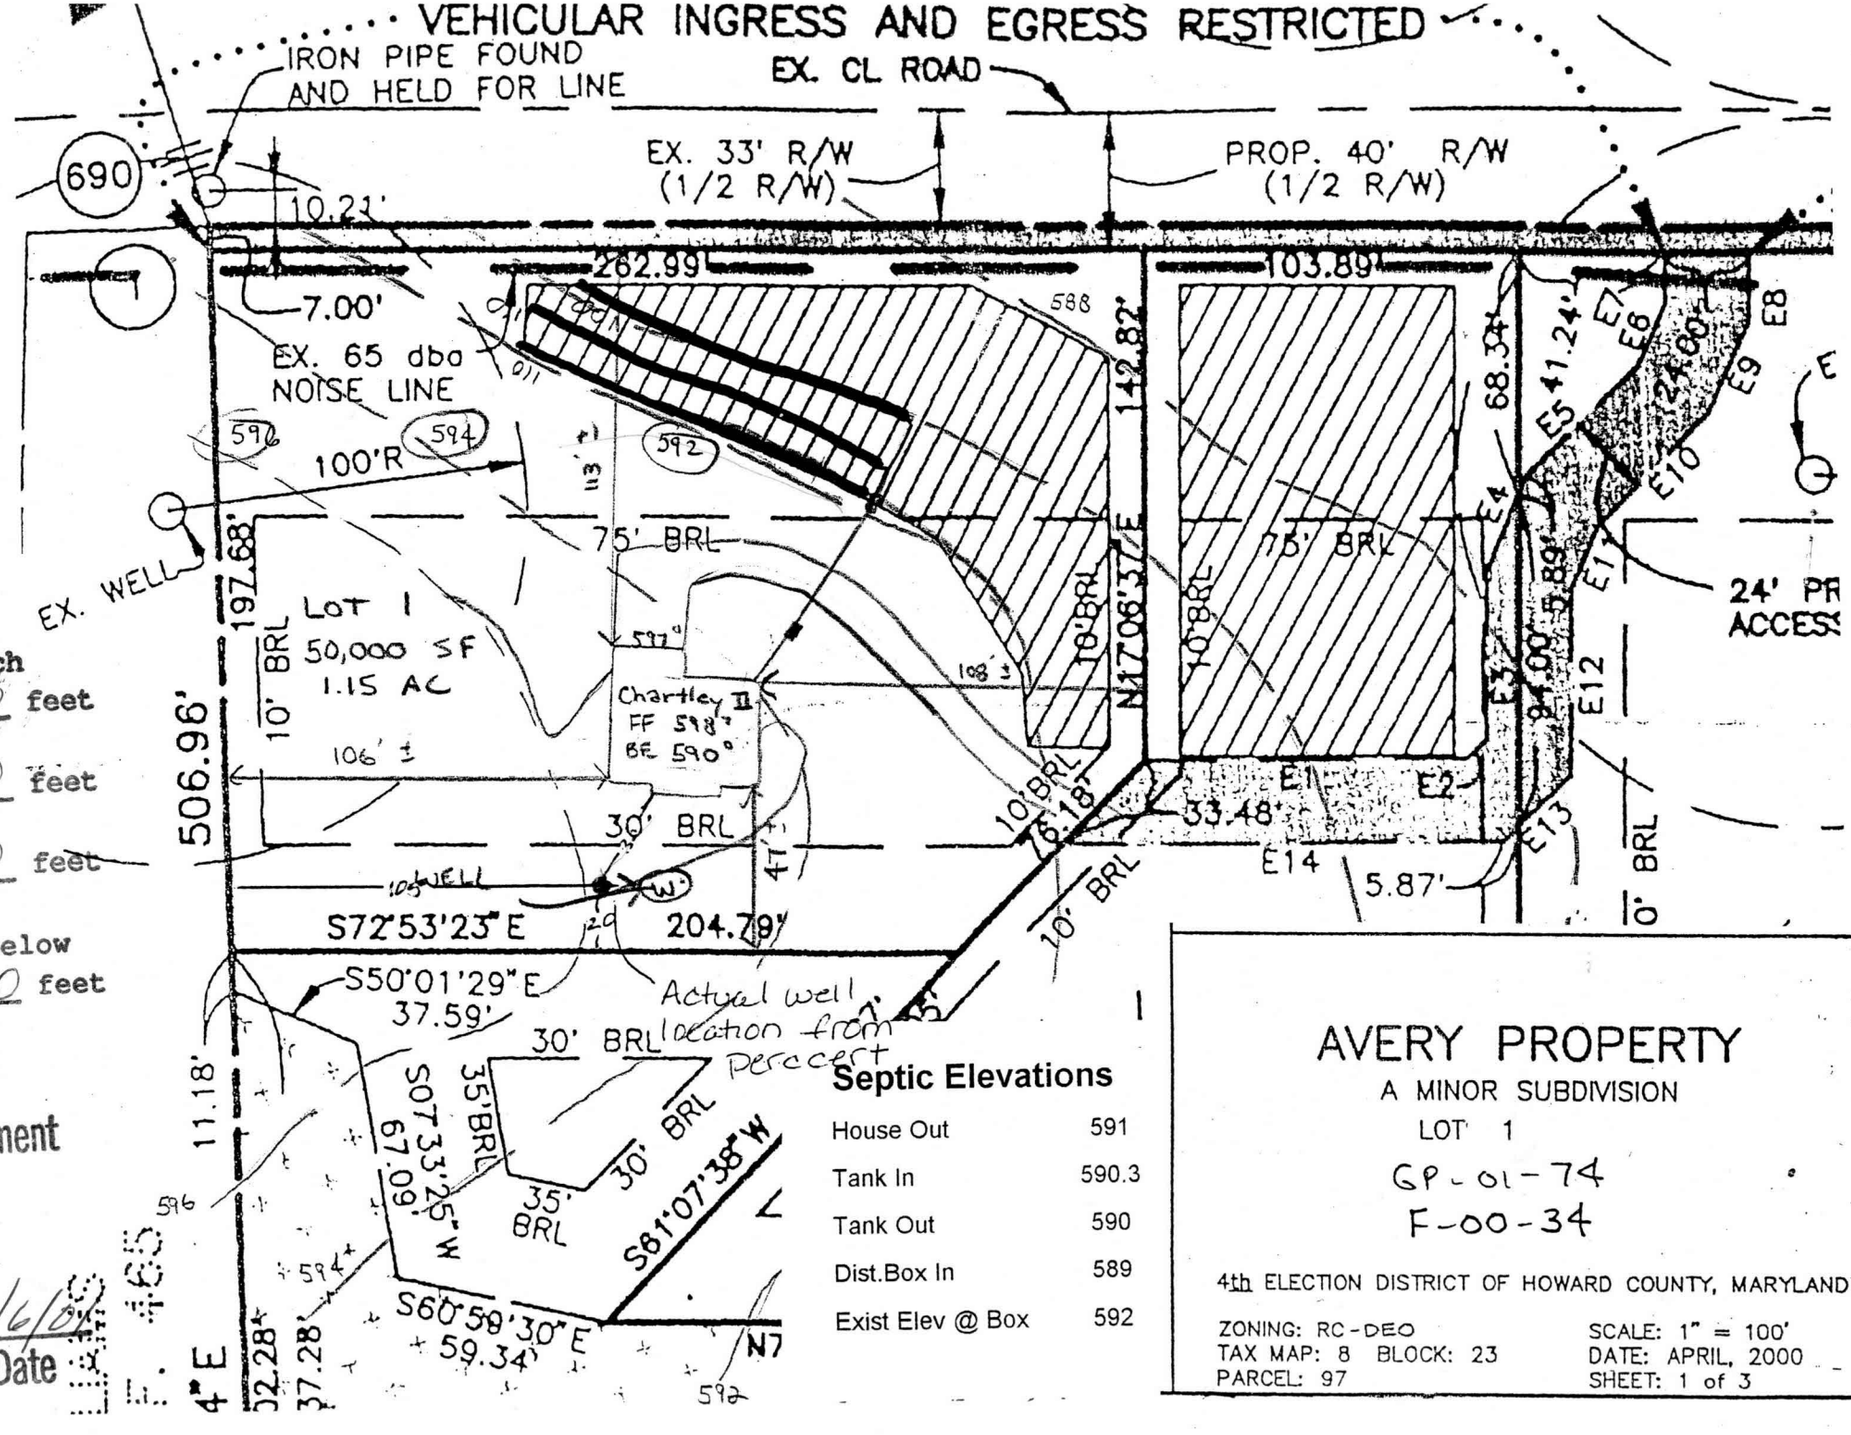

Septic Elevations

House Out	591
Tank In	590.3
Tank Out	590
Dist.Box In	589
Exist Elev @ Box	592

AVERY PROPERTY

A MINOR SUBDIVISION

LOT 1

GP-01-74

F-00-34

4th ELECTION DISTRICT OF HOWARD COUNTY, MARYLAND

ZONING: RC-DEO
TAX MAP: 8 BLOCK: 23
PARCEL: 97

SCALE: 1" = 100'
DATE: APRIL, 2000
SHEET: 1 of 3

Total linear feet of trench required 320 **feet**

Width of trench(es) 2.0 **feet**

Depth of trench(es) 6.0 **feet**

Depth of stone required below distribution pipe 3.0 **feet**

Approved Septic System Plan
Howard County Health Department

Signature

4/6/00
Date

E OF HOWARD COUNTY
D LEGIBLY. **
NLY -

BACK INFORMATION

um setbacks met? YES ☐ NO ☐
Permit required? YES ☐ NO ☐
strict? O ☐
ge for NewTown Zone
ne approval date

PROPERTY ID#: 5105

Filing fee	$
Permit fee	$
Excise tax	$
Add'l per. fee	$
TOTAL FEES	$
Sub-total paid	$
Balance due	$
Check #	
Validation #	

Accepted by