11/30/64

# PERMIT

SEWAGE DISPOSAL SYSTEM

MARYLAND STATE DEPARTMENT OF HEALTH

HOWARD COUNTY

INDEXED

ELLICOTT CITY

DISTRICT 6

DATE 11/2/64

A 46012

Howard Septic Service, Inc. IS PERMITTED TO INSTALL X ALTER

ADDRESS Box 4th, Sandy Springs, Maryland PHONE [illegible]

A SEWAGE DISPOSAL SYSTEM LOCATED AT

SUBDIVISION Cabin River Farms ROAD Hipsley Mill Rd. LOT [illegible]

PROPERTY OWNER Kenneth Miller

ADDRESS Brookeville, Maryland

SPECIFICATIONS 3 bedrooms

DRAIN FIELD ____ DEPTH ____ FEET, BOTTOM AREA ____ SQ. FT.

SEEPAGE PITS ____ ABSORBENT SIDE-WALL AREA ____ SQ. FT.

SEPTIC TANK CAPACITY 750 GALLONS

FOR GARBAGE GRINDER, INCREASE DISPOSAL AREA 22% & TANK CAPACITY 50%

OTHER Dry well = 438 sq. ft. sidewall area below the inlet pipe. Inlet pipe must be 4 ft. below grade.
Place dry well about 205 ft. from Hipsley Mill Rd. and about 73 ft. from left side line as seen when facing lot from Hipsley Mill Rd.

PLANS APPROVED BY R. W. Monaghan DATE 9/23/64

FILL SEPTIC TANK AND DISTRIBUTION BOX WITH WATER BEFORE CALLING FOR AN INSPECTION. COVER NO WORK UNTIL INSPECTED AND APPROVED.

NEITHER THE HOWARD COUNTY COMMISSIONERS NOR THE HEALTH DEPARTMENT IS RESPONSIBLE FOR THE SUCCESSFUL OPERATION OF ANY SYSTEM.

0416

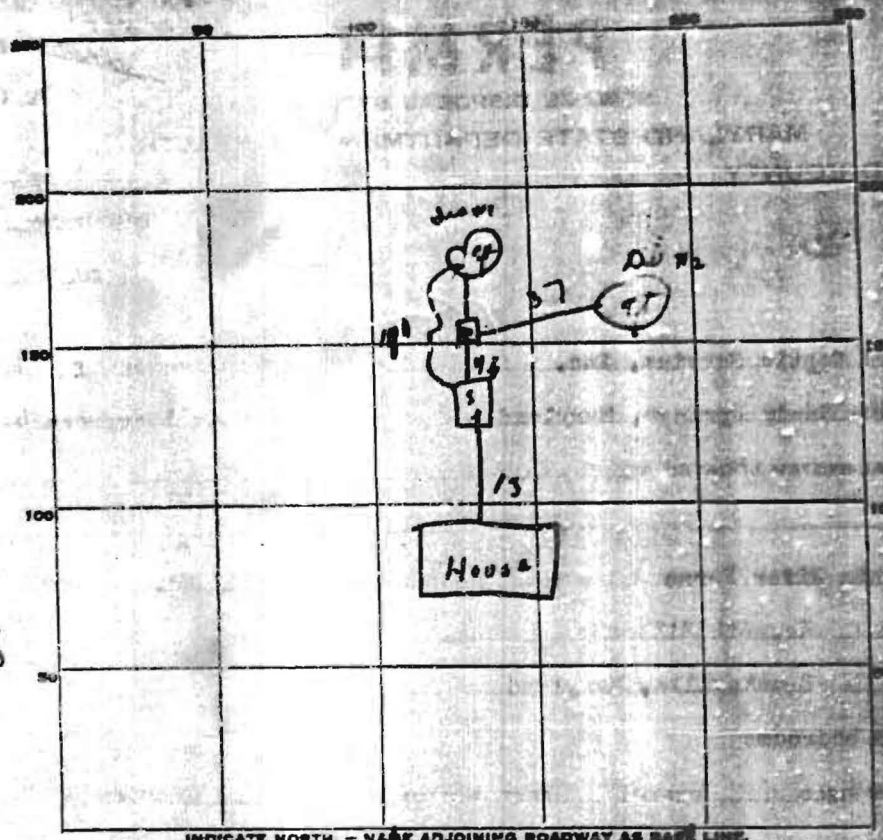


INDICATE NORTH. — NAME ADJOINING ROADWAY AS BASE LINE.

Hepsly's mill Rd.

PERMIT CARD O K

SEPTIC TANK, LEVEL O K CLEANOUTS O K

DISTRIBUTION BOX, LEVEL O K

TILE FIELD, DEPTH _____ FT. TRENCH WIDTH _____ FT.

GRAVEL DEPTH _____ IN. TOTAL LENGTH _____ FT.

NUMBER OF TRENCHES _____ TOTAL BOTTOM AREA _____

SEEPAGE PITS, INSIDE DIAMETER _____ FT. DEPTH BELOW INLET _____ FT.

ABSORBENT AREA _____ SQ FT.

REMARKS Permit Dia = 19 ft Wall to wall diameter - 20 ft depth = 226 sqft / 452 sqft - 226 sqft / [illegible]

DATE SYSTEM APPROVED 11/30/64 INSPECTOR [illegible]