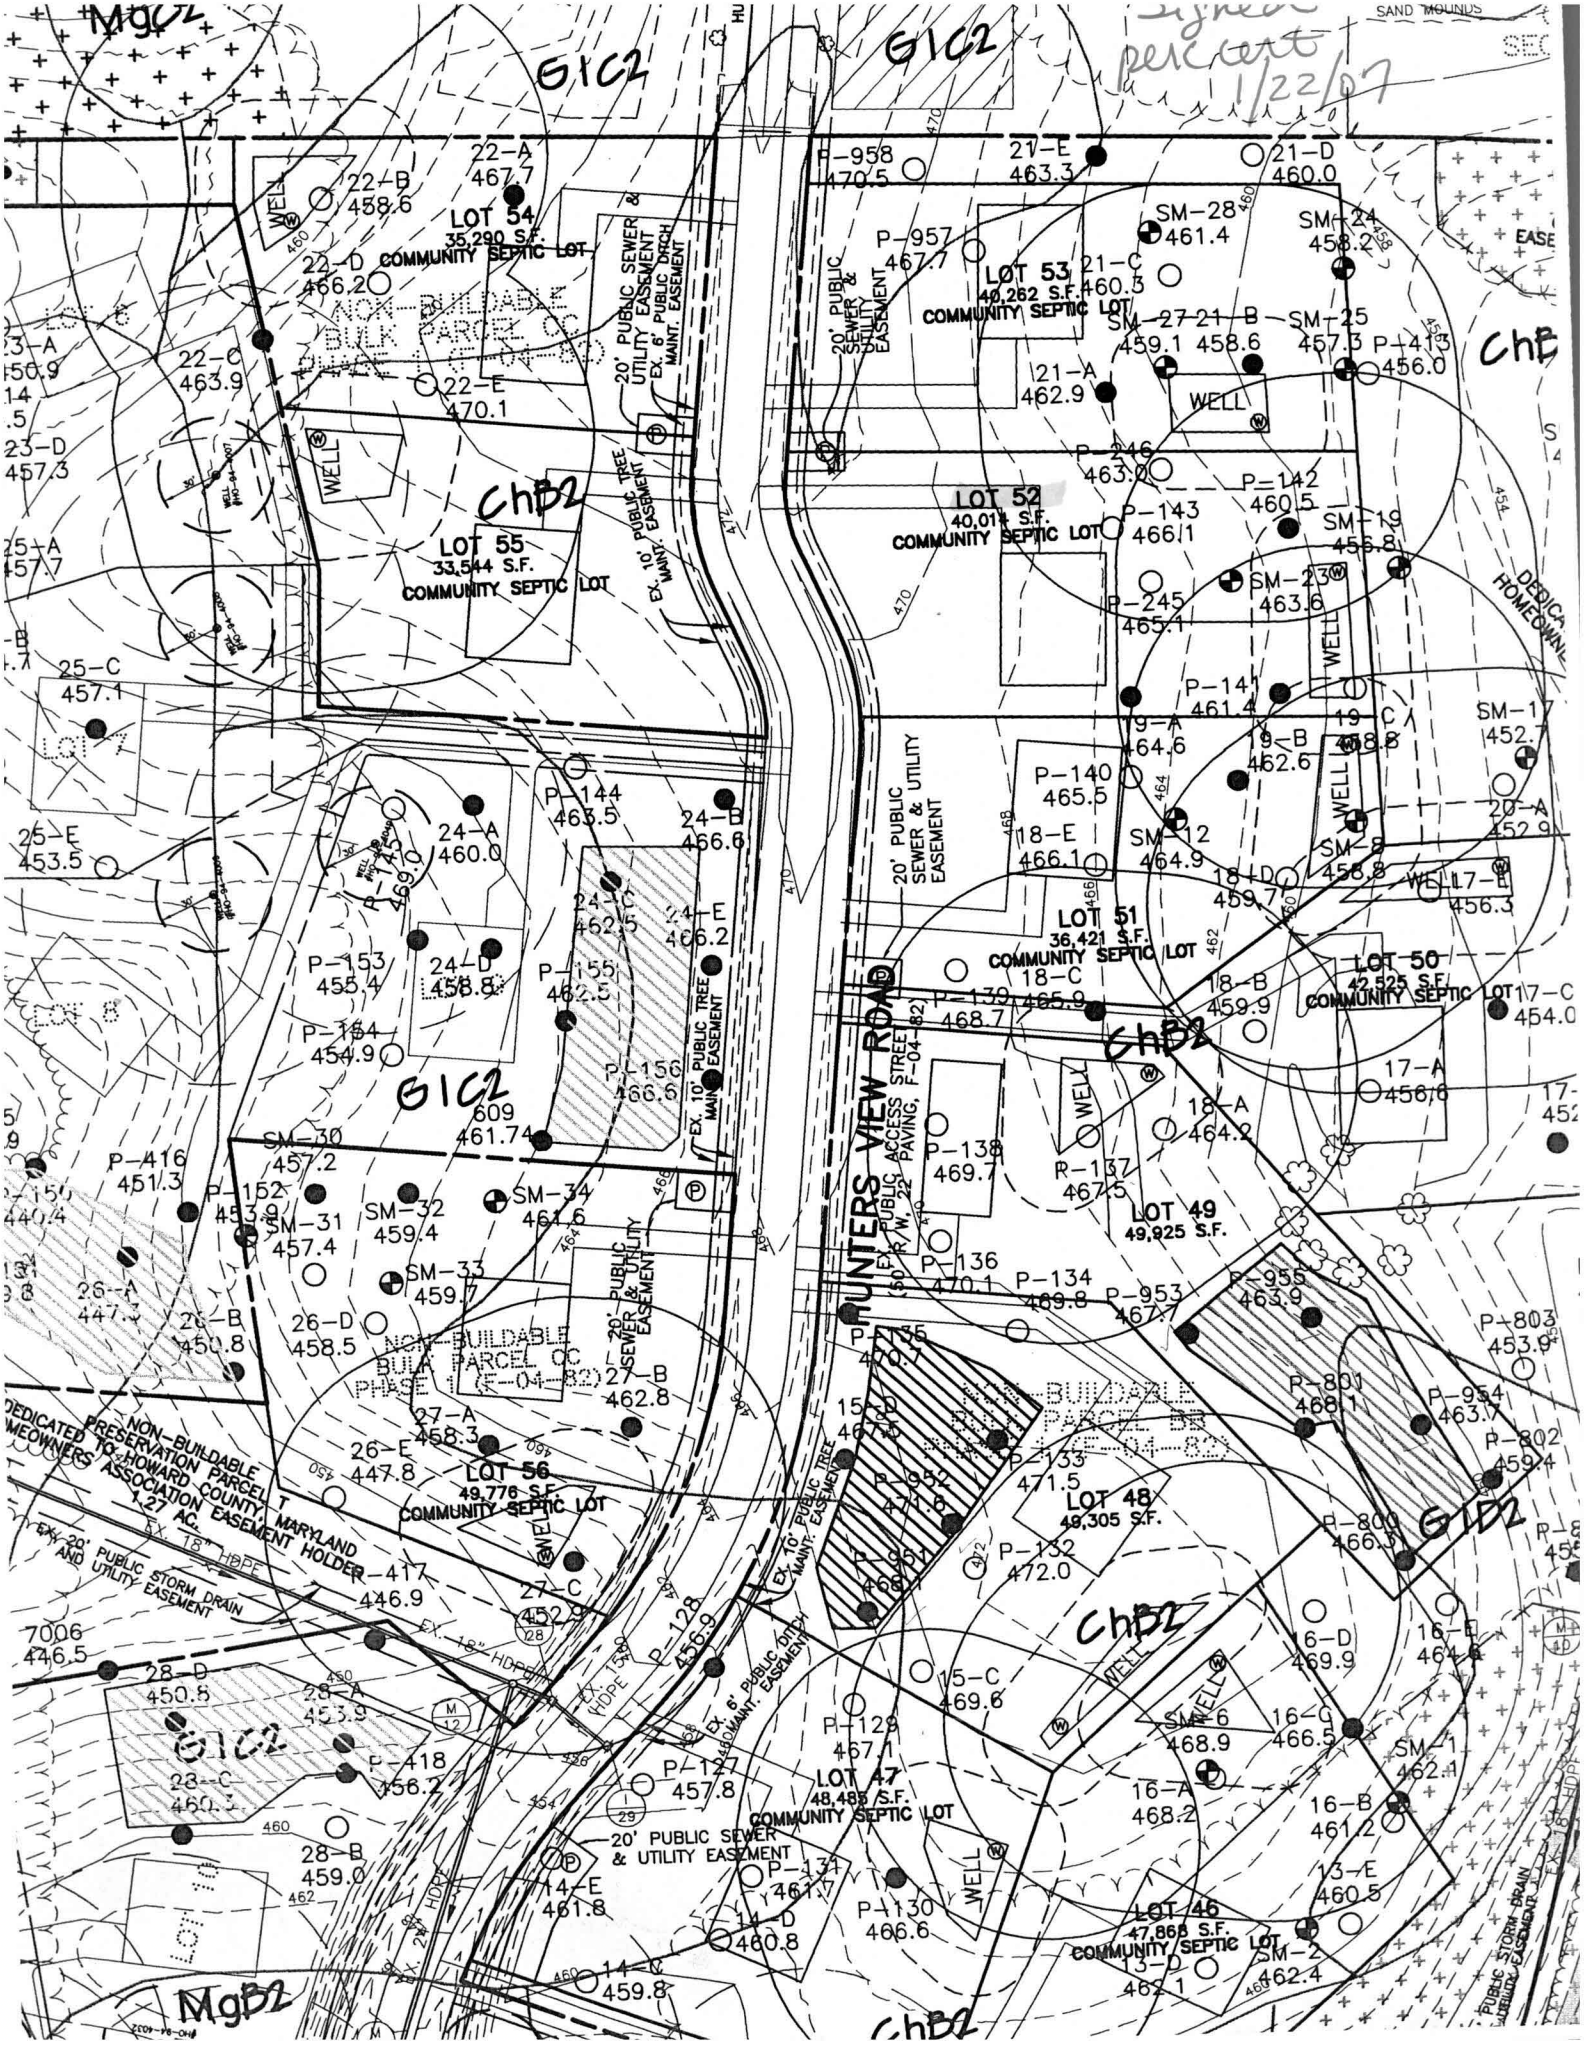
Signed percent 1/22/07
SAND MOUNDS
LOT 54
35,290 S.F.
COMMUNITY SEPTIC LOT
LOT 55
33,544 S.F.
COMMUNITY SEPTIC LOT
LOT 53
40,262 S.F.
COMMUNITY SEPTIC LOT
LOT 52
40,014 S.F.
COMMUNITY SEPTIC LOT
LOT 51
36,421 S.F.
COMMUNITY SEPTIC LOT
LOT 50
42,525 S.F.
COMMUNITY SEPTIC LOT
LOT 49
49,925 S.F.
LOT 48
49,305 S.F.
LOT 47
48,485 S.F.
COMMUNITY SEPTIC LOT
LOT 46
47,868 S.F.
COMMUNITY SEPTIC LOT
LOT 56
49,776 S.F.
COMMUNITY SEPTIC LOT
NON-BUILDABLE BULK PARCEL CC PHASE 1 (F-04-82)
NON-BUILDABLE BULK PARCEL BB PHASE 1 (F-04-82)
NON-BUILDABLE PRESERVATION PARCEL T DEDICATED TO HOWARD COUNTY, MARYLAND HOMEOWNERS ASSOCIATION EASEMENT HOLDER 1.27 AC.
HUNTERS VIEW ROAD
EX. PUBLIC ACCESS STREET PAVING, F-04-82
20' PUBLIC SEWER & UTILITY EASEMENT
20' PUBLIC TREE MAINT. EASEMENT
EX. 10' PUBLIC TREE MAINT. EASEMENT
EX. 6' PUBLIC DITCH MAINT. EASEMENT
EX. 20' PUBLIC STORM DRAIN AND UTILITY EASEMENT
EX. 18" HDPE
WELL
GIC2
GID2
ChB2
MgB2