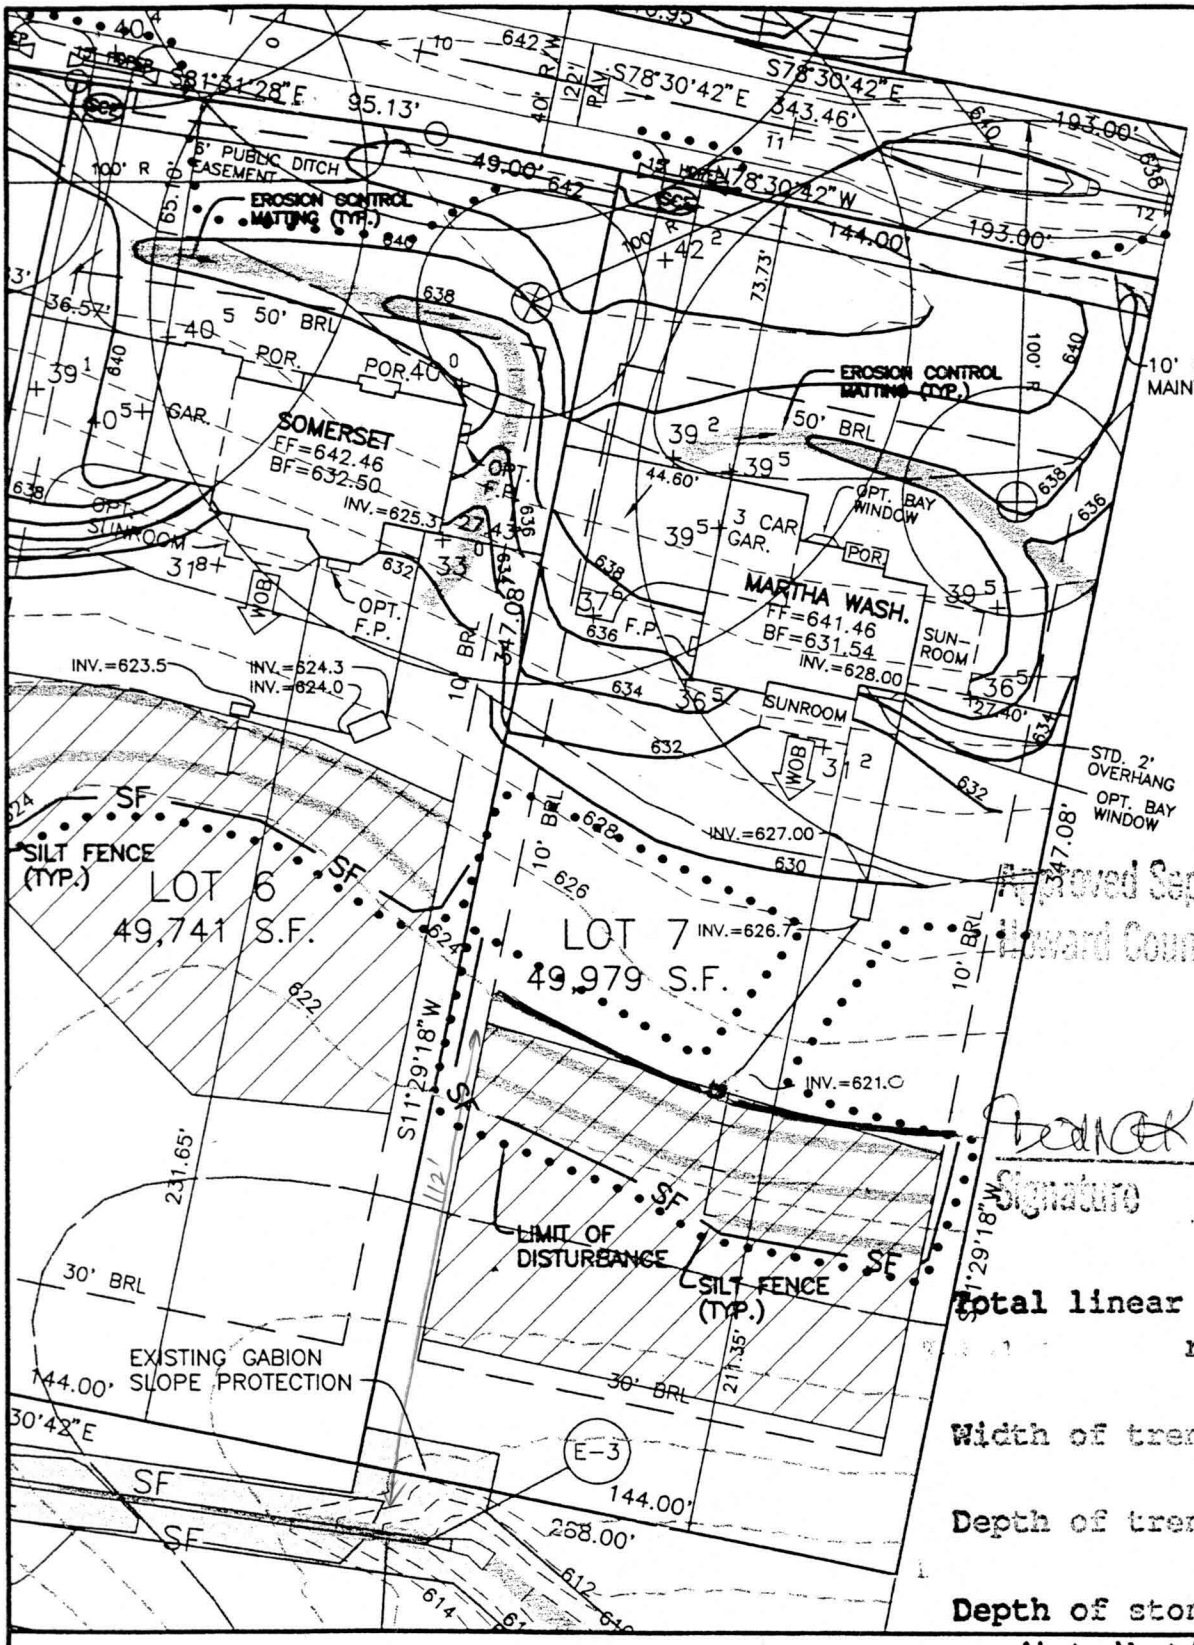

Approved Septic System Plan
Howard County Health Department

Signature

1/7/01
Date

Total linear feet of trench required 240 fee

Width of trench(es) 3 fee

Depth of trench(es) 5 fee

Depth of stone required below distribution pipe 2 fee

FIRST FLOOR ELEVATION = 641.46
BASEMENT ELEVATION = 631.5
SPOT ELEVATION AT GARAGE = 639.5

SLOPE OF DRIVEWAY = 3%
NUMBER OF RISERS IN GAR. = 3
NUMBER OF RISERS ON LEAD WALK = 3

BENCHMARK
ENGINEERS • LAND SURVEYORS • PLANNERS
ENGINEERING, INC.
8480 BALTIMORE NATIONAL PIKE • SUITE 418 • ELLICOTT CITY, MD 21043
PHONE: 410-465-6105 FAX: 410-465-6644

MONTICELLO
LOT 7 – REVISED

FOURTH ELECTION DISTRICT
HOWARD COUNTY, MARYLAND
SCALE: 1" = 50' DATE: 1/23/01