Approved Septic System Plan
Howard County Health Department

Signature 7/02/02 Date

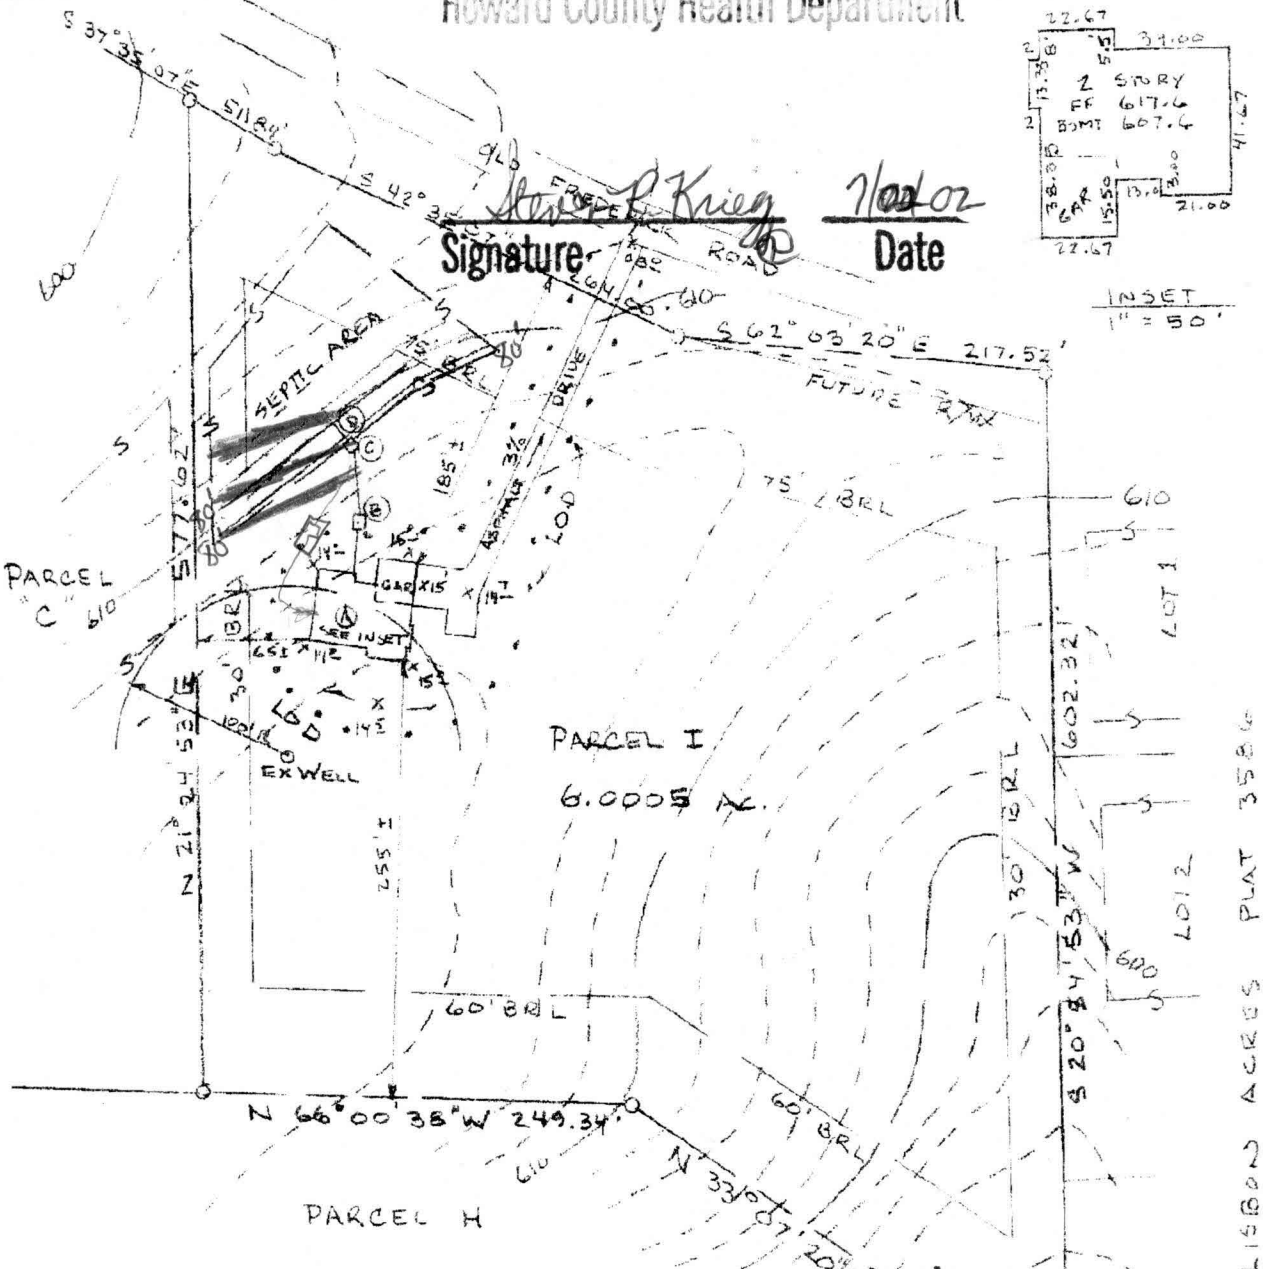

PROPOSED ELEVATIONS

A PROP 2 STORY HOUSE
GAR ELEV 615.6
FF ELEV 617.6
** BSMT ELEV 607.6
INV ELEV 609.5

B PROP SEPTIC TANK
EX GRD ELEV 612.5
INV IN 609.0
INV OUT 608.7

C PROP DIST BOX
EX GRD ELEV 610.5
INV ELEV 608.0

D * PROP TRENCHES
INV. ELEV 608.0

* LENGTH TO BE DETERMINED AT TIME OF SEPTIC PERMIT ISSUANCE

** NO GRAVITY SEWER TO BSMT.

Total linear feet of trench required 240 feet

Width of trench(es) 3 feet

Depth of trench(es) 5 feet

Depth of stone required below distribution pipe 2 feet

NOTES: • TOPOGRAPHY BASED ON HOWARD COUNTY TOPO.
• PROVIDE SEDIMENT CONTROL MEASURES AS REQUIRED.

PLOT PLAN
PARCEL I
HARBIN PROPERTY
TM 8, GRID 8, PAR. 9
4TH ELECTION DISTRICT
HOWARD COUNTY, MD.
SCALE: 1" = 100' JUNE, 2002