

APPLICATION

PERCOLATION TESTING

A _____

P _____

DISTRICT _____

DATE _____

HOWARD COUNTY HEALTH DEPARTMENT
BUREAU OF ENVIRONMENTAL HEALTH
3525-H ELLICOTT MILLS DRIVE/ELLICOTT CITY, MARYLAND 21043
TELEPHONE: 410-313-2640

TO: THE COUNTY HEALTH OFFICER
ELLICOTT CITY, MARYLAND

I HEREBY APPLY FOR THE NECESSARY TEST PRIOR TO APPLICATION FOR PERMIT TO CONSTRUCT (OR RECONSTRUCT) A SEWAGE DISPOSAL SYSTEM.

PROPERTY OWNER Clifford and Betty Harrison

ADDRESS 3155 Route 32, West Friendship, MD 21794 PHONE 410-442-2196

AGENT OR PROSPECTIVE BUYER Heritage Land Development

ADDRESS 3060 Washington Rd., Suite 220, Glenwood, MD 21738 PHONE 410-489-7900

PROPERTY LOCATION:

SUBDIVISION _____ LOT NO. 8 2

ROAD AND DESCRIPTION Off of Route 32, South of Rosemary Lane 3/4 of a mile

TAX MAP NO. 22 PARCEL # 17

SIZE OF LOT 1 Acre TYPE OF BLDG. SFD
(SINGLE FAMILY DWELLING OR COMMERCIAL)

THE SYSTEM INSTALLED UNDER THIS APPLICATION IS ACCEPTABLE ONLY UNTIL PUBLIC FACILITIES BECOME AVAILABLE. I FULLY UNDERSTAND THE FEE CONNECTED WITH THE FILING OF THIS PERC TEST APPLICATION IS NON-REFUNDABLE UNDER ANY CIRCUMSTANCES. I ALSO AGREE TO COMPLY WITH ALL M.O.S.H.A. REQUIREMENTS IN TESTING THIS LOT.

[Signature]
(SIGNATURE OF APPLICANT)

APPROVED BY _____ FOR _____ DATE _____

DISAPPROVED BY _____ FOR _____ DATE _____

HOLD PENDING FURTHER TESTS _____

REASONS FOR REJECTION OR HOLDING _____

PERCOLATION TEST PLAT/PRELIMINARY PLAT - TITLE OR I.D. # _____ DATE _____

SITE DEVELOPMENT PLAN/FINAL PLAT - TITLE OR I.D. # _____ DATE _____

THIS IS NOT A PERMIT


COUNTY #

SOIL PROFILE


0' 100A
 6" topsoil
 4' d/c
 red brn
 cl lo
 4' 1+
 org brn
 si mica
 Lm
 30%+
 sapr
 sh

101
 6" topsoil
 4' red brn
 cl lo
 4' med
 fcr brn
 si mica
 Lm
 20%+
 sapr
 sh

109
 6" topsoil
 3.5' red org
 brn
 cl lo
 4' 1+
 brn
 si mica
 Lm
 20%
 25%
 sapr
 sh

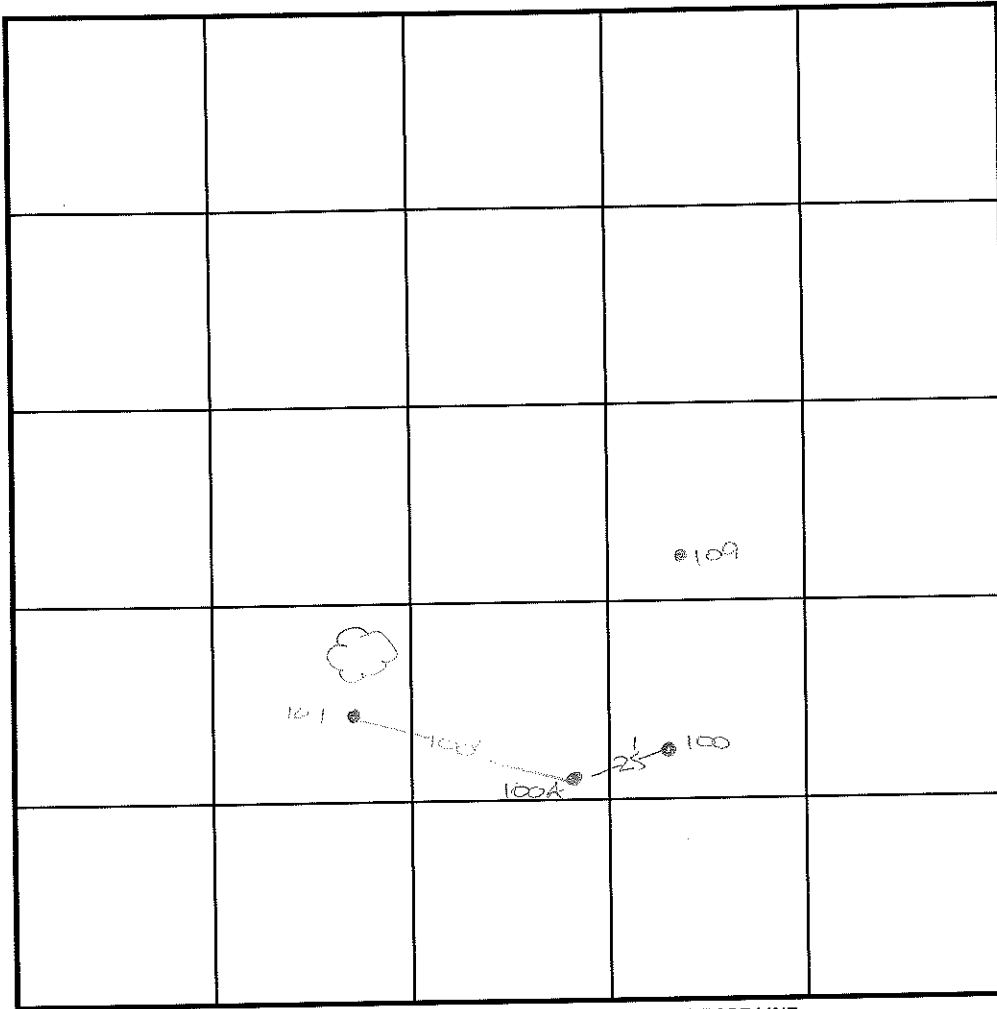

SOIL PROFILE

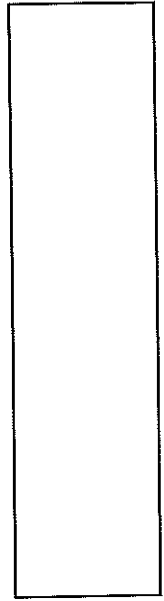

INDICATE NORTH - NAME ADJOINING ROADWAY AS BASE LINE.

Route 32

DATE	TEST NO.	DEPTH	PRE-WET		TEST - 1" DROP		TIME
			START	STOP	START	STOP	
6-22-01	100A	3.5' S	11:09	slow-test stopped			-
		4.0' M	11:36	11:46	11:46	11:56	10
		13.0' D	visual	see profile			OK
	100	5.5' D	refusal				FAIL
	101	13.5' D	visual	see profile			OK
	109	13.0' D	visual	see profile			OK

REMARKS

TYPE OF SOIL

TESTED BY DICE

TRENCH DESIGN DATA: AVG. PERCOLATION TIME

INLET DEPTH

MAXIMUM BOTTOM DEPTH

ALSO PRESENT C. Zepp, T. Feag

TRENCH WIDTH

SQ. FT./BEDROOM

COUNTY #

SOIL PROFILE

115/116

0' 6" topsoil
 org bn
 cl Lm

3' pale
 org bn
 si mica
 Lm

15%+
 sapr
 sh

0' 6" 117/111
 topsoil
 red bn
 cl Lm

4' pale
 red bn
 si mica

10-15%
 sh

0' 6" 118
 topsoil
 red org
 bn
 cl Lm

4' tan
 si mica
 Lm

15%+
 sh


3' 5"

SOIL PROFILE

110

0' like
 117
 w/20%+
 sapr
 sh

4'

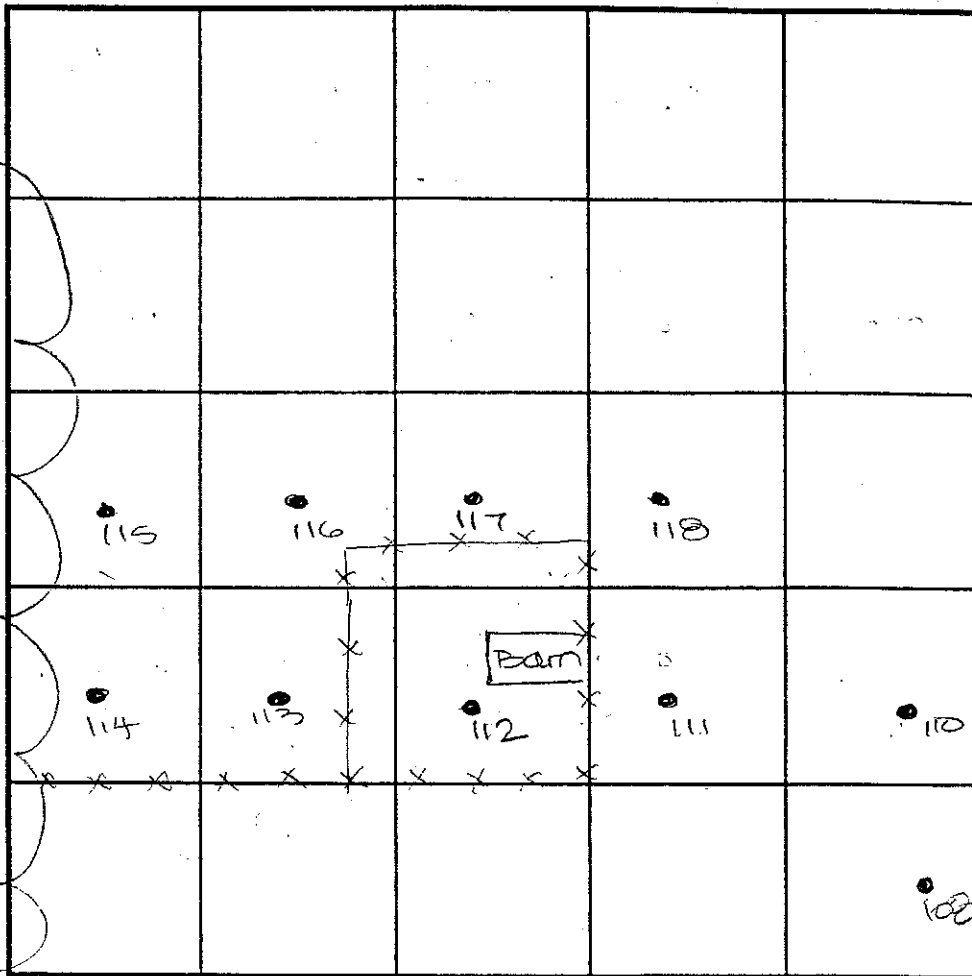

INDICATE NORTH - NAME ADJOINING ROADWAY AS BASE LINE.

Route 32

DATE	TEST NO.	DEPTH	PRE-WET		TEST - 1" DROP		TIME
			START	STOP	START	STOP	
6-21-01	115	3.5' S	11:57 ₃	11:58	11:58	12:00 ₃	3
		12.5' D	visual	-see	profile		OK
	117	4.5' S	12:03 ₃	12:05 ₃	12:05 ₃	12:09 ₃	4
		13'10" D	visual	-see	profile		OK
	116	13.5' D	visual	-see	profile		OK
	118	13.5' D	visual	-see	profile		OK
	111	4.0' S	11:56 ₃	11:57 ₃	11:57 ₃	11:59 ₃	2
		13'10" D	visual	-see	profile		OK
	110	14.0' D	visual	-see	profile		OK

REMARKS _____


TYPE OF SOIL _____

TESTED BY DKC ALSO PRESENT C. Zepp, T. Feagge

TRENCH DESIGN DATA: AVERAGE PERCOLATION TIME _____ TRENCH WIDTH _____

INLET DEPTH _____ MAXIMUM BOTTOM DEPTH _____ SQ. FT./BEDROOM _____

PRINCIPAL ROUTE 32

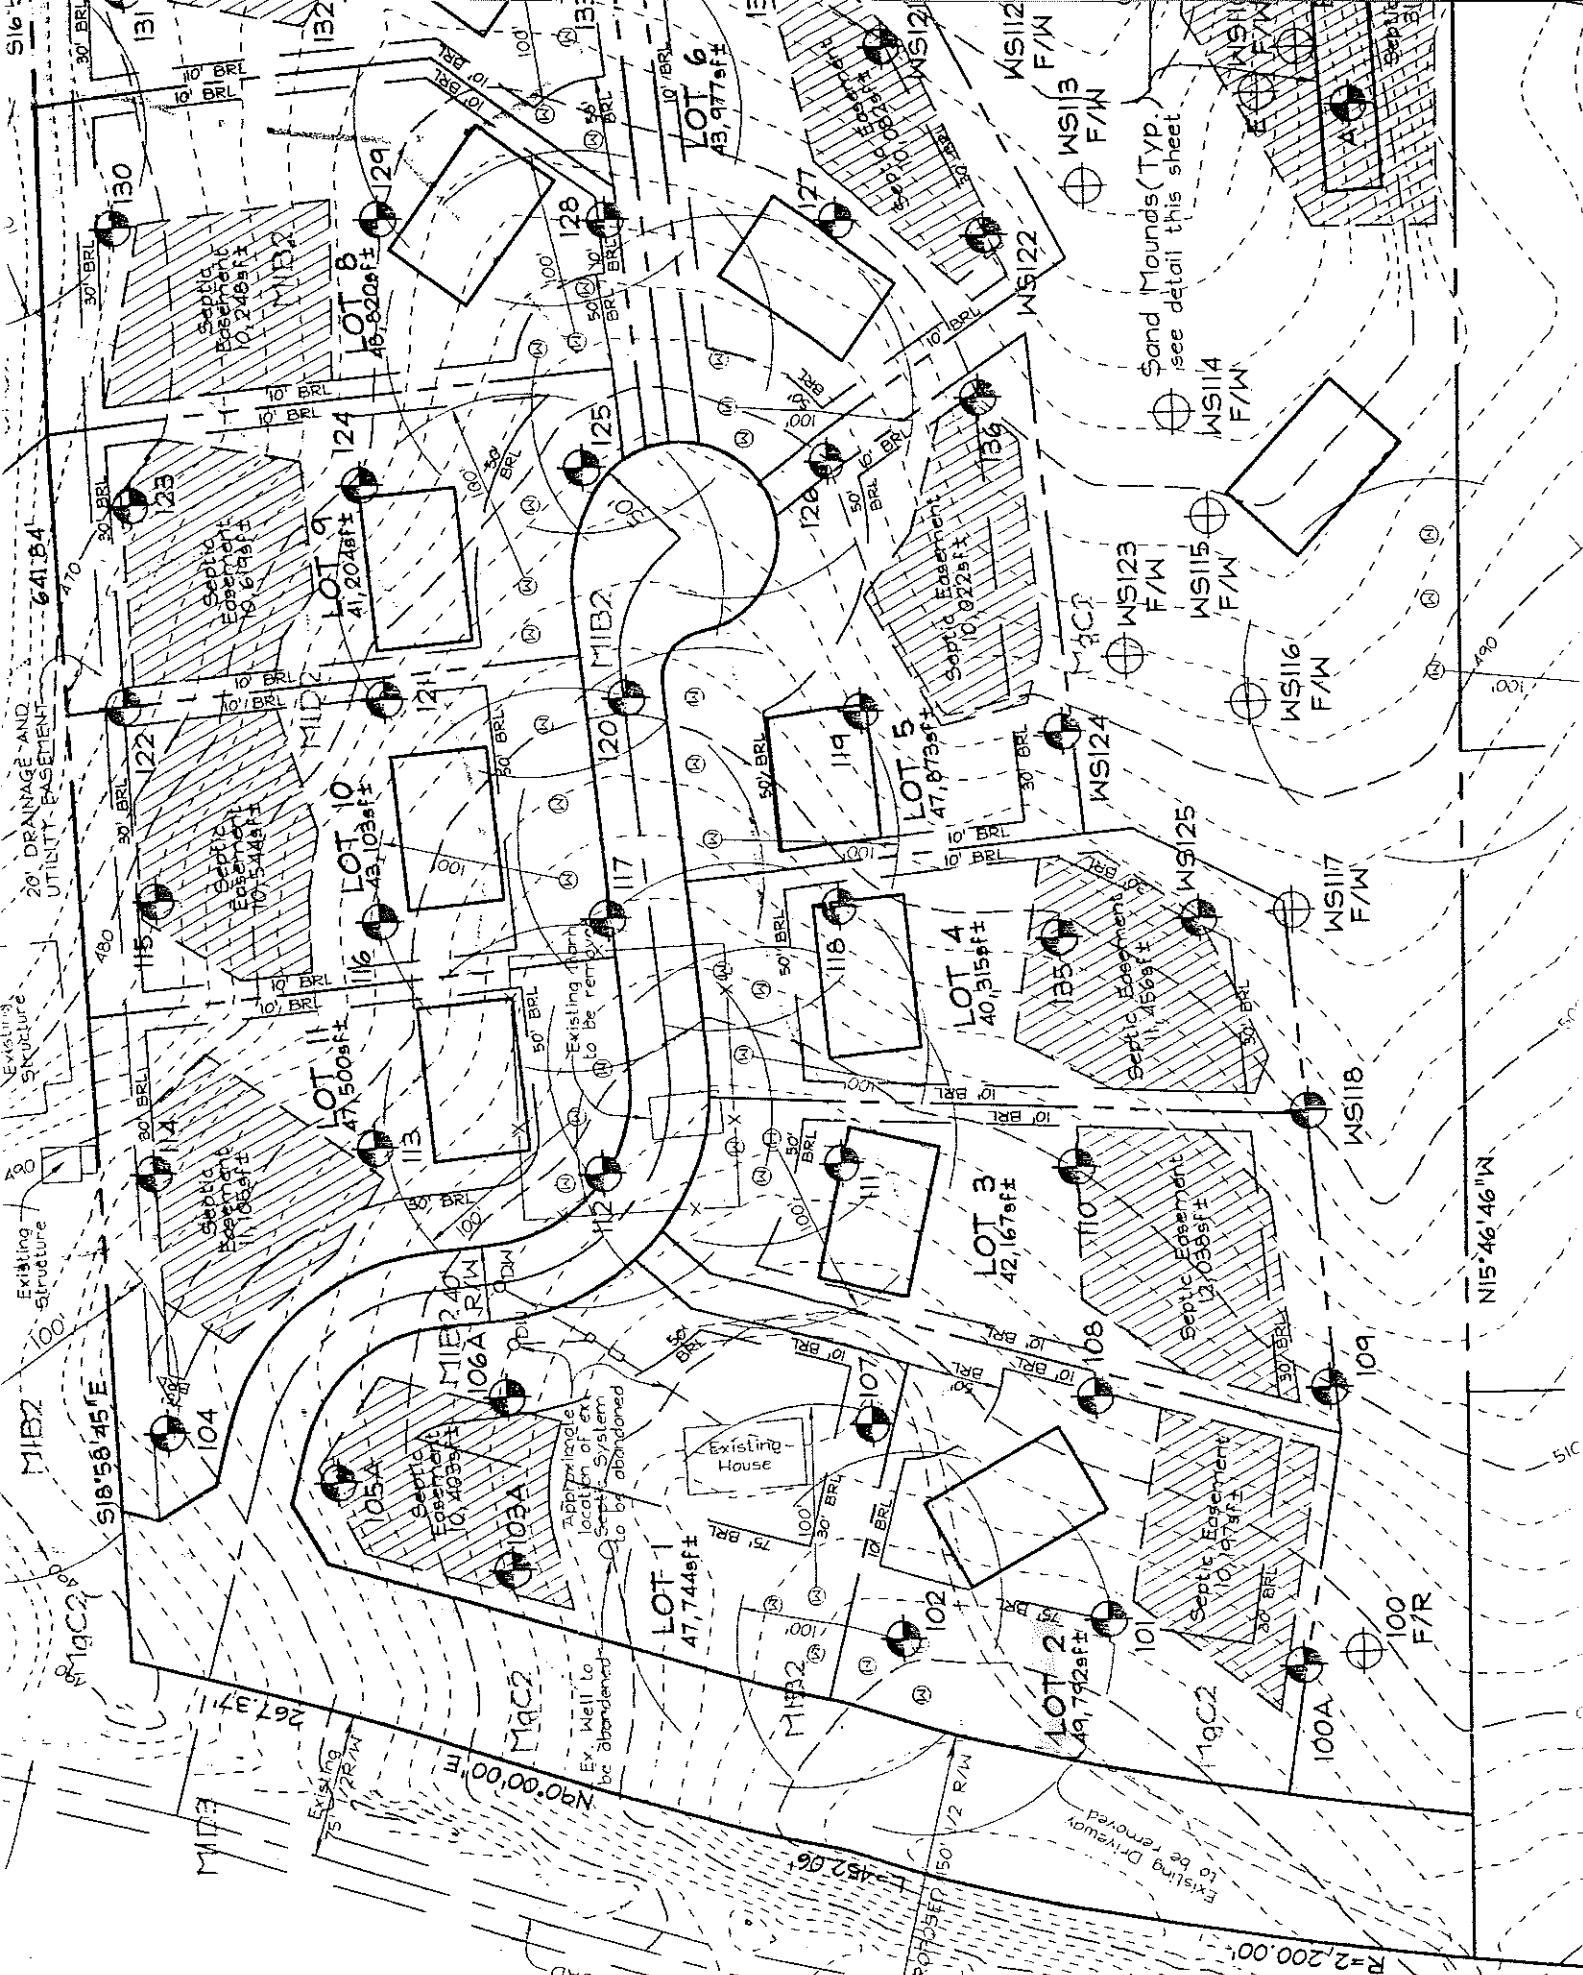

S16

20' DRAINAGE AND UTILITY EASEMENT

Existing Structure

Existing Structure







LOT 1
47,744sf±

LOT 2
49,792sf±

LOT 3
42,167sf±

LOT 4
40,315sf±

LOT 5
47,873sf±

LOT 6
43,977sf±

LOT 8
45,820sf±

LOT 9
41,204sf±

LOT 10
43,103sf±

LOT 11
47,500sf±

Septic Easement
10,248sf±

Septic Easement
10,619sf±

Septic Easement
10,544sf±

Septic Easement
10,403sf±

Septic Easement
10,477sf±

Septic Easement
2,038sf±






























































































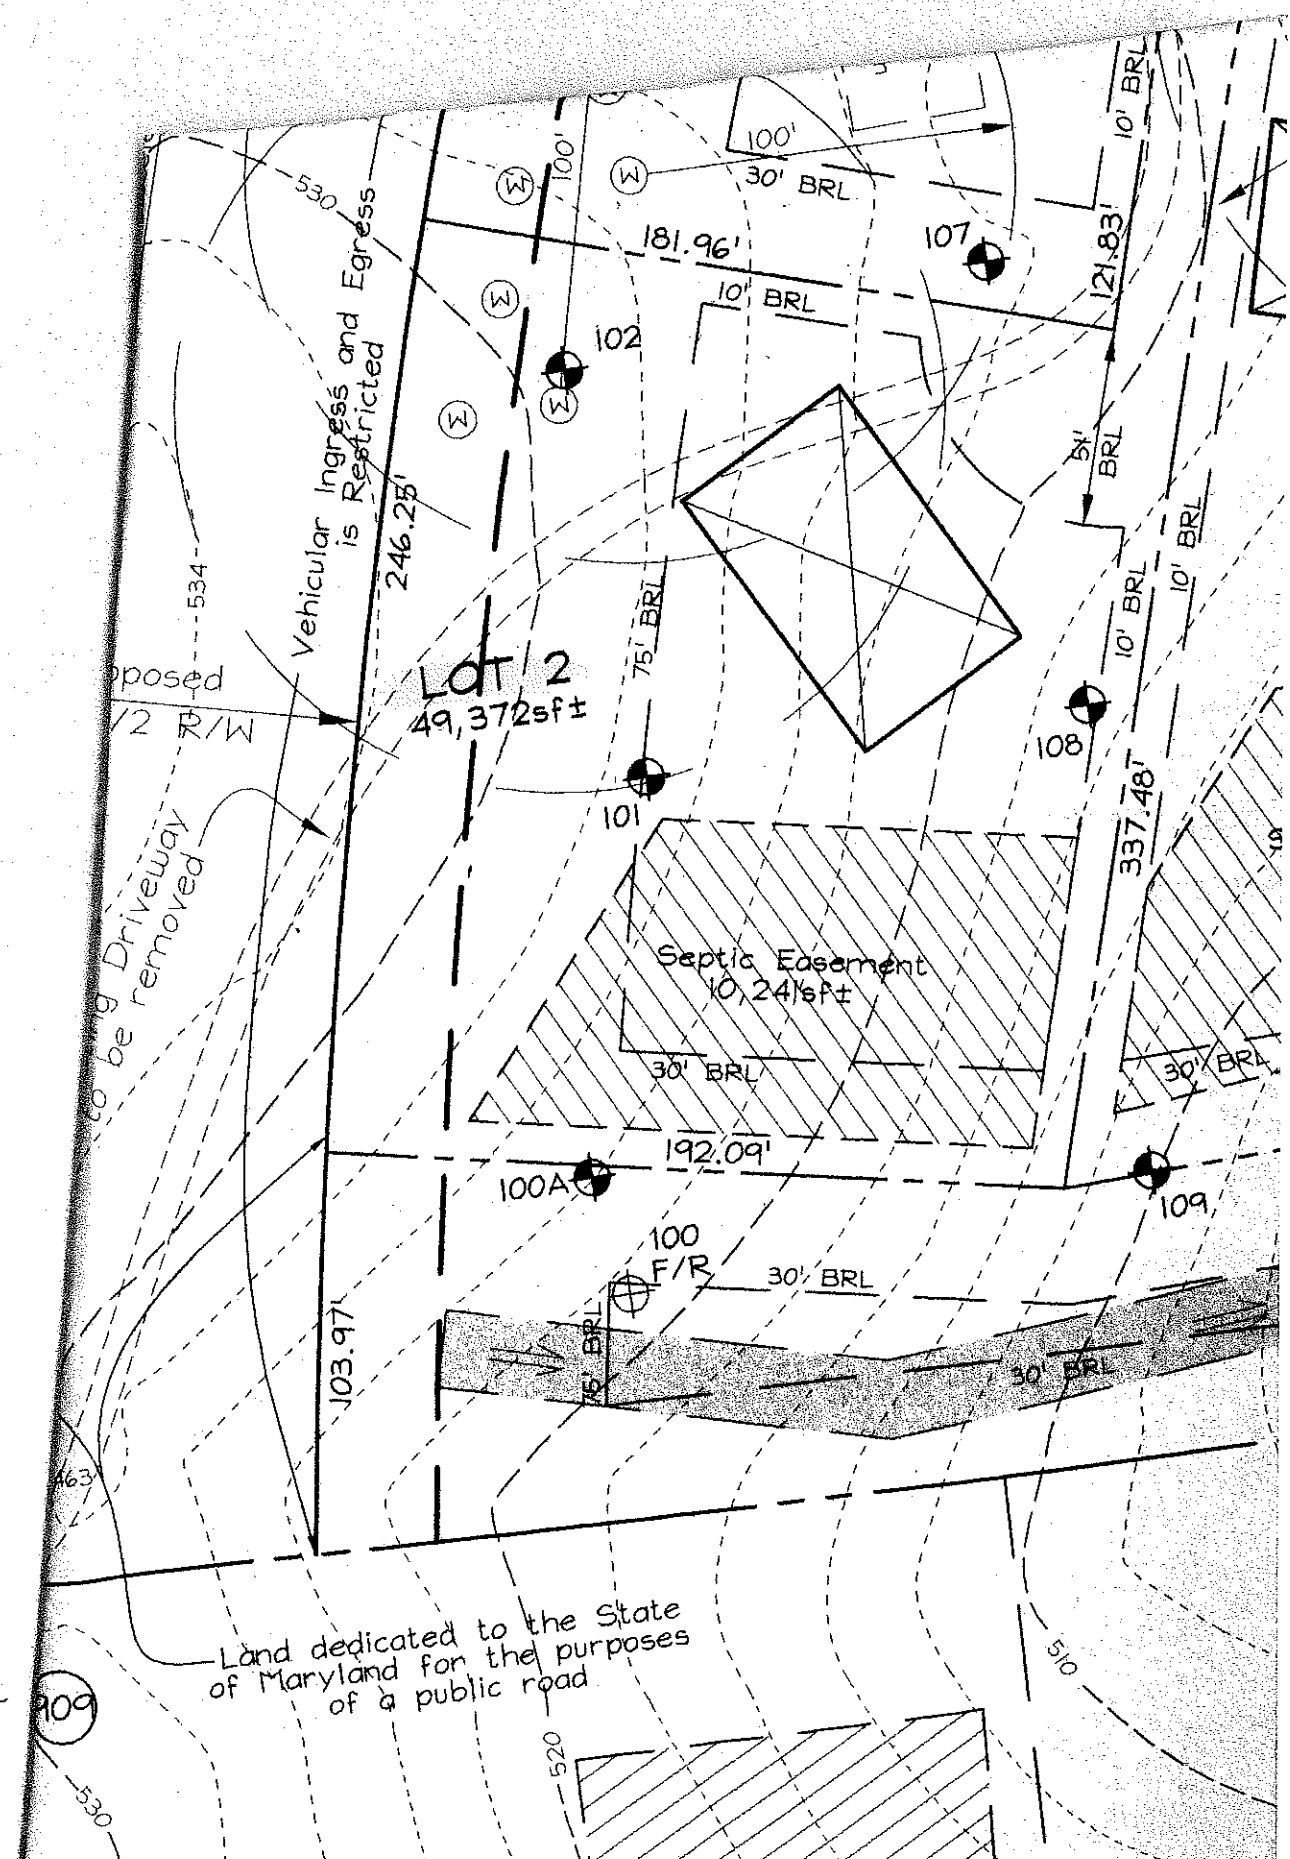

Signed
prelim

109