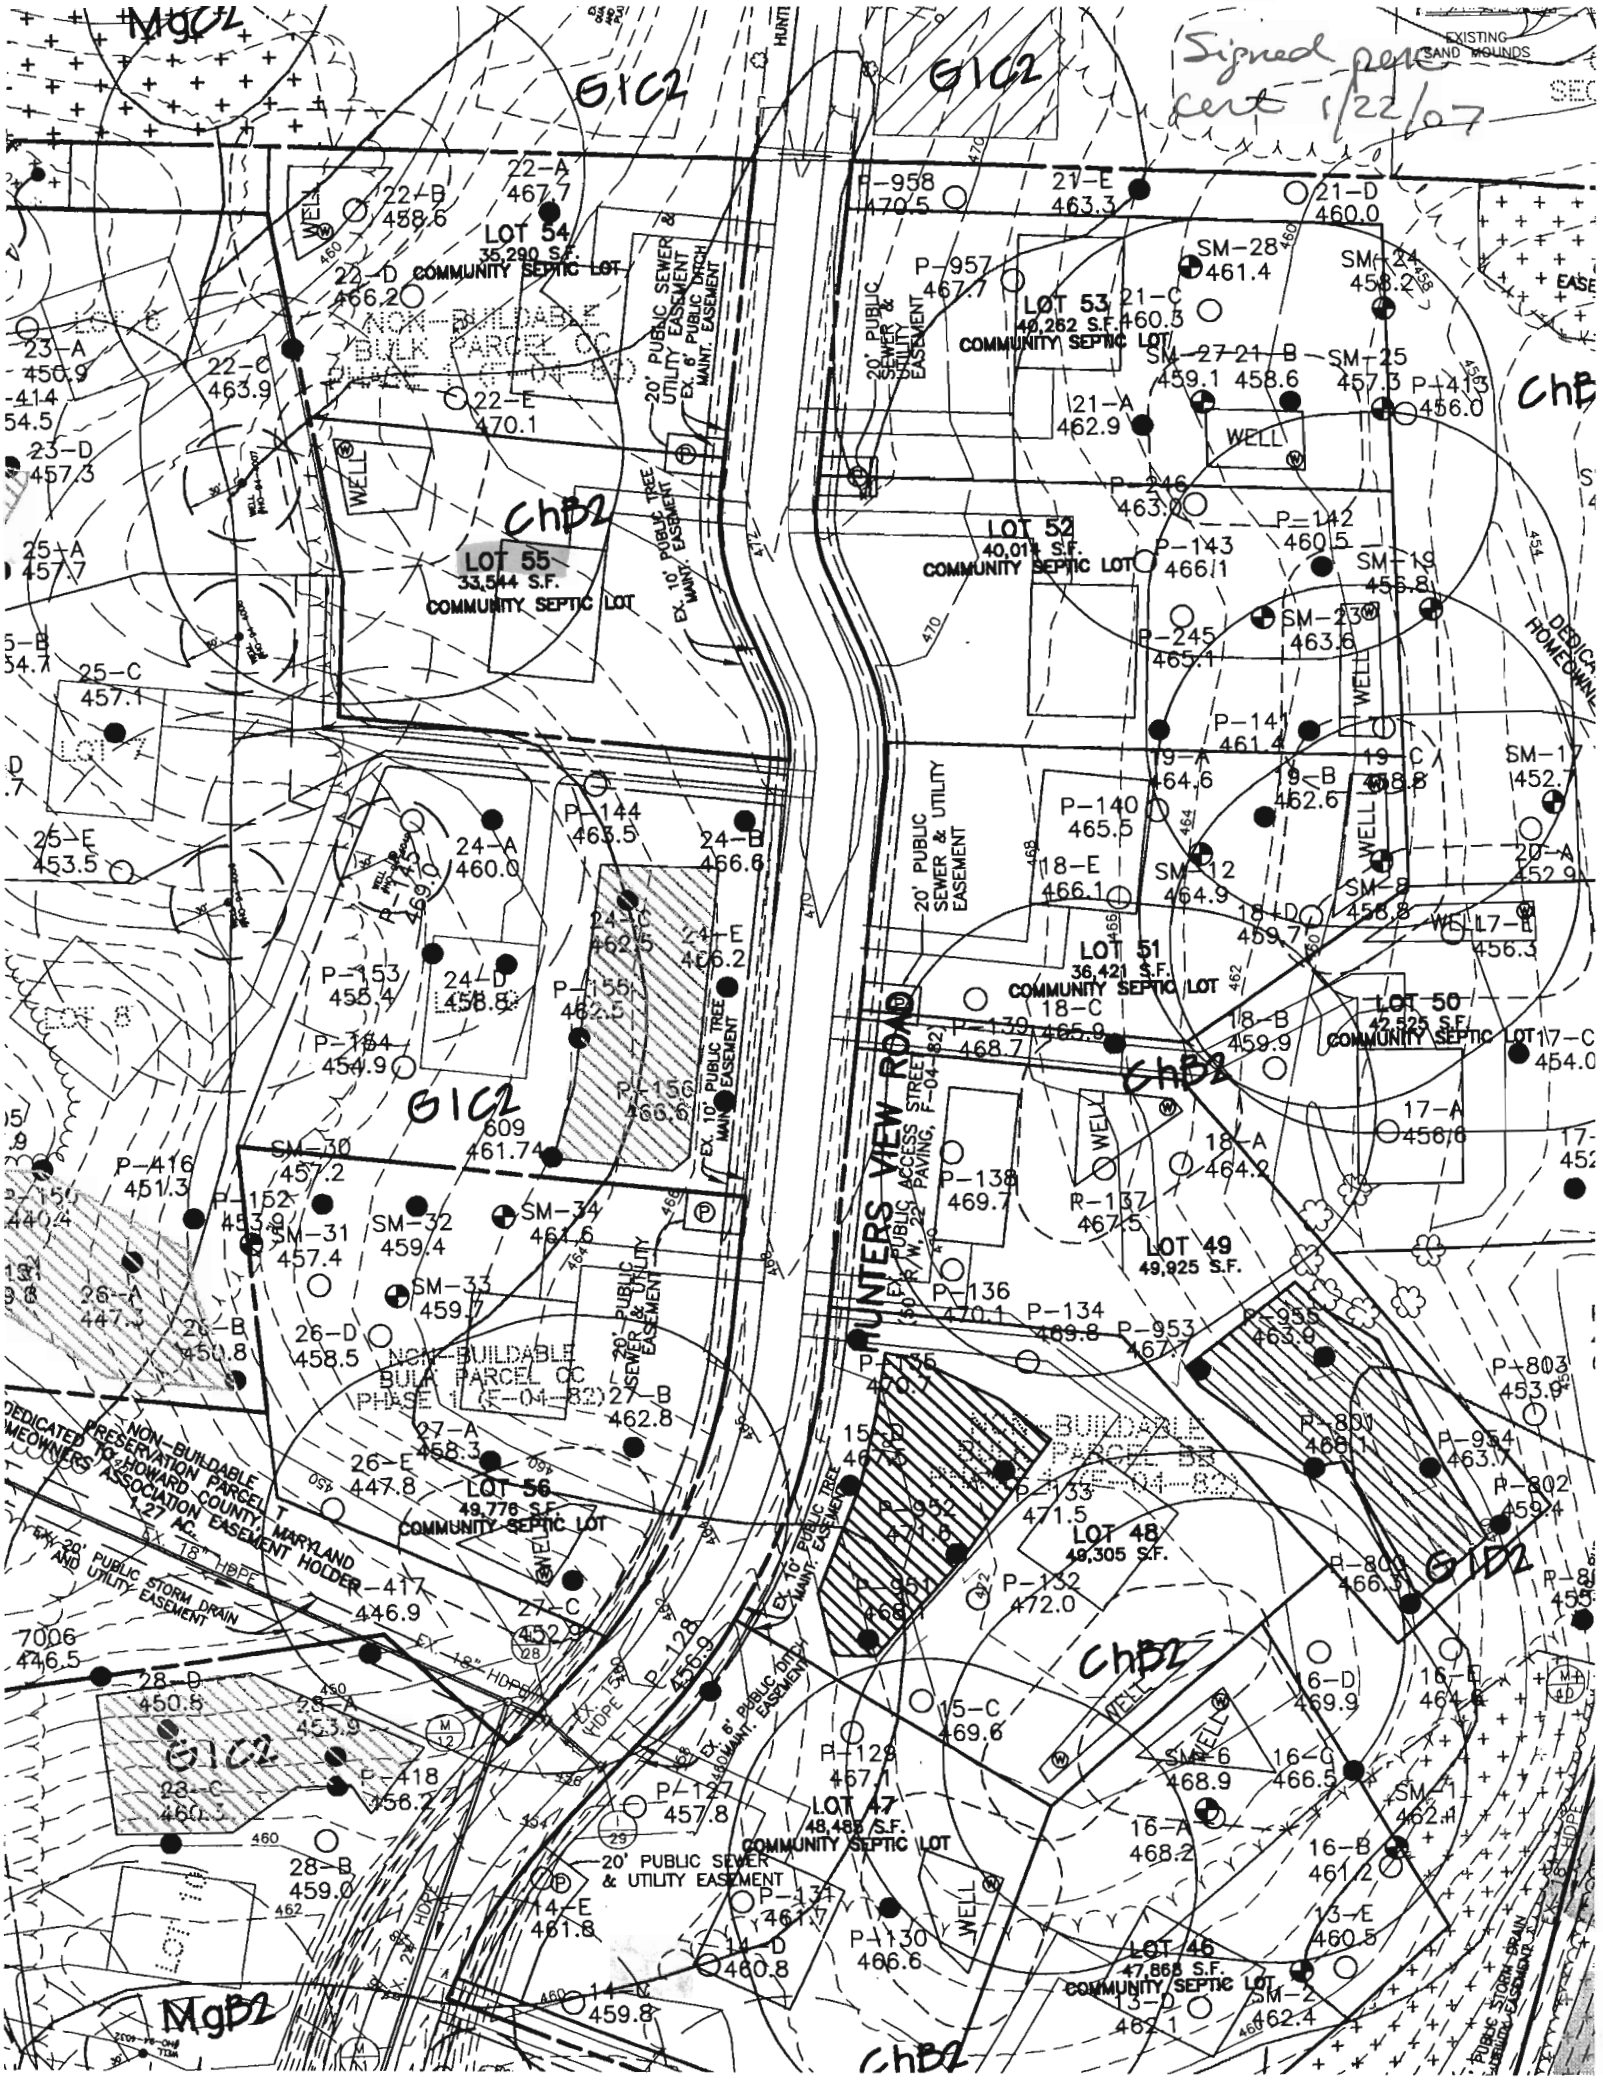Signed perc cert 1/22/07