Walk Thru

Permits: 410-313-2455
Inspections: 410-313-1810
Automated Line: 410-313-3800

Howard County Building/Fire Permit Application

Department of Inspections, Licenses & Permits
3430 Court House Drive
Ellicott City, MD 21043

Permit Number:

Building Address: 1801 Mount Denali Dr. Woodstock, MD 21163
Suite/Apt. #: ____ SDP/WP/BA #: ____
Census Tract: ____ Subdivision: 0000
Section: ____ Area: 1.33 ac. Lot: 18
Tax Map: ____ Parcel: 0330 Grid: ____
Zoning: ____ Map Coordinates: ____ Lot Size: 1.33 ac

Existing Use: Residence
Proposed Use: Residence
Estimated Construction Cost: $ 141,542.00
Description of Work: Install in-ground swimming pool

Occupant or Tenant: Preston and Elizabeth Kim
Was tenant space previously occupied? ☒ Yes ☐ No
Contact Name: Preston and Elizabeth Kim
Address: 1801 Mount Denali Dr.
City: Woodstock State: MD Zip Code: 21163
Phone: 410-707-3315 Fax: ____
Email: prestonkim@verizon.net

Property Owner's Name: Preston and Elizabeth Kim
Address: 1801 Mount Denali Dr.
City: Woodstock State: MD Zip Code: 21163
Home Phone: 410-707-3315 Work Phone: —
Applicant's Name & Mailing Address, (If other than stated herein):
Browning Construction – Tim Harold
23731 Ridge Rd, Germantown, MD 20876
Phone: 301-972-3800 Fax: 301-540-9646
Email: timh@browningpools.com

Contractor Company: Browning Construction
Contact Person: Tim Harold
Address: 23731 Ridge Rd
City: Germantown State: MD Zip Code: 21163
License No.: 1377
Phone: 301-972-3800 Fax: 301-540-9646
Email: timh@browningpools.com

Engineer/Architect Company: ____
Responsible Design Prof.: ____
Address: ____
City: ____ State: ____ Zip Code: ____
Phone: ____ Fax: ____
Email: ____

BUILDING DESCRIPTION - COMMERCIAL

Building Characteristics	Utilities
Height:	***Water Supply***
No. of stories:	☐ Public
Gross area, sq. ft./floor:	☐ Private
	Sewage Disposal
Area of construction (sq. ft.):	☐ Public
	☐ Private
Use group:	Electric: ☐ Yes ☐ No
	Gas: ☐ Yes ☐ No
Construction type:	***Heating System***
☐ Reinforced Concrete	☐ Electric ☐ Oil
☐ Structural Steel	☐ Natural Gas ☐ Propane Gas
☐ Masonry	***Sprinkler System:***
☐ Wood Frame	☐ N/A
☐ State Certified Modular	☐ Full
➢ **Roadside Tree Project Permit**	☐ Partial
☐ **Yes** ☐ **No**	☐ Other Suppression
Roadside Tree Project Permit #	No. of Heads:

BUILDING DESCRIPTION – RESIDENTIAL

Building Characteristics	Utilities
☐ SF Dwelling ☐ SF Townhouse	***Water Supply***
Depth **Width**	☐ Public
1st floor:	☒ Private
2nd floor:	***Sewage Disposal***
Basement:	☐ Public
☐ Finished Basement	☒ Private
☐ Unfinished Basement	Electric: ☒ Yes ☐ No
☐ Crawl Space	Gas: ☒ Yes ☐ No
☐ Slab on Grade	***Heating System***
No. of Bedrooms:	☐ Electric
Multi-family Dwelling	☐ Oil
No. of efficiency units:	☐ Natural Gas
No. of 1 BR units:	☐ Propane Gas
No. of 2 BR units:	
No. of 3 BR units:	
Other Structure: Swimming Pool	
Dimensions: 21×42	
Footings:	➢ **Roadside Tree Project Permit**
Roof:	☐ **Yes** ☒ **No**
☐ State Certified Modular	**Roadside Tree Project Permit #**
☐ Manufactured Home	

THE UNDERSIGNED HEREBY CERTIFIES AND AGREES AS FOLLOWS: (1) THAT HE/SHE IS AUTHORIZED TO MAKE THIS APPLICATION; (2) THAT THE INFORMATION IS CORRECT; (3) THAT HE/SHE WILL COMPLY WITH ALL REGULATIONS OF HOWARD COUNTY WHICH ARE APPLICABLE THERETO; (4) THAT HE/SHE WILL PERFORM NO WORK ON THE ABOVE REFERENCED PROPERTY NOT SPECIFICALLY DESCRIBED IN THIS APPLICATION; (5) THAT HE/SHE GRANTS COUNTY OFFICIALS THE RIGHT TO ENTER ONTO THIS PROPERTY FOR THE PURPOSE OF INSPECTING THE WORK PERMITTED AND POSTING NOTICES.

Applicant's Signature Preston Kim
Print Name Tim Harold Preston Kim
Email Address timh@browningpools.com
Date 9/12/13
Title/Company Browning Construction

Checks Payable to: DIRECTOR OF FINANCE OF HOWARD COUNTY
PLEASE WRITE NEATLY & LEGIBLY

-FOR OFFICE USE ONLY-

AGENCY	DATE	SIGNATURE OF APPROVAL
State Highways		
Building Officials		
PSZA (Zoning)		
PSZA (Engineering)		
Health	9-12-13	Dana Bernard
Fire Protection		

Is Sediment Control approval required for issuance? ☐ Yes ☐ No
☐ CONTINGENCY CONSTRUCTION START
☐ ONE STOP SHOP

DPZ SETBACK INFORMATION
Front:
Rear:
Side:
Side St.:
All minimum setbacks met? ☐ Yes ☐ No
Is Entrance Permit Required? ☐ Yes ☐ No
Historic District? ☐ Yes ☐ No
Lot Coverage for New Town Zone:
SDP/Red-line approval date:

Filing Fee	$
Permit Fee	$
Tech Fee	$
Excise Tax	$
PSFS	$
Guaranty Fund	$
Add'l per Fee	$
Total Fees	$
Sub- Total Paid	$
Balance Due	$

Distribution of Copies: **White: Building Officials** **Green: PSZA,Zoning** **Yellow: PSZA,Engineering** **Pink: Health** **Gold: SHA**
T:\Operations\Updated Forms\New building app 11.10.2010.docx

40
Scale

Preston Kim
1801 Mount Denali Dr.
Woodstock, MD 21163

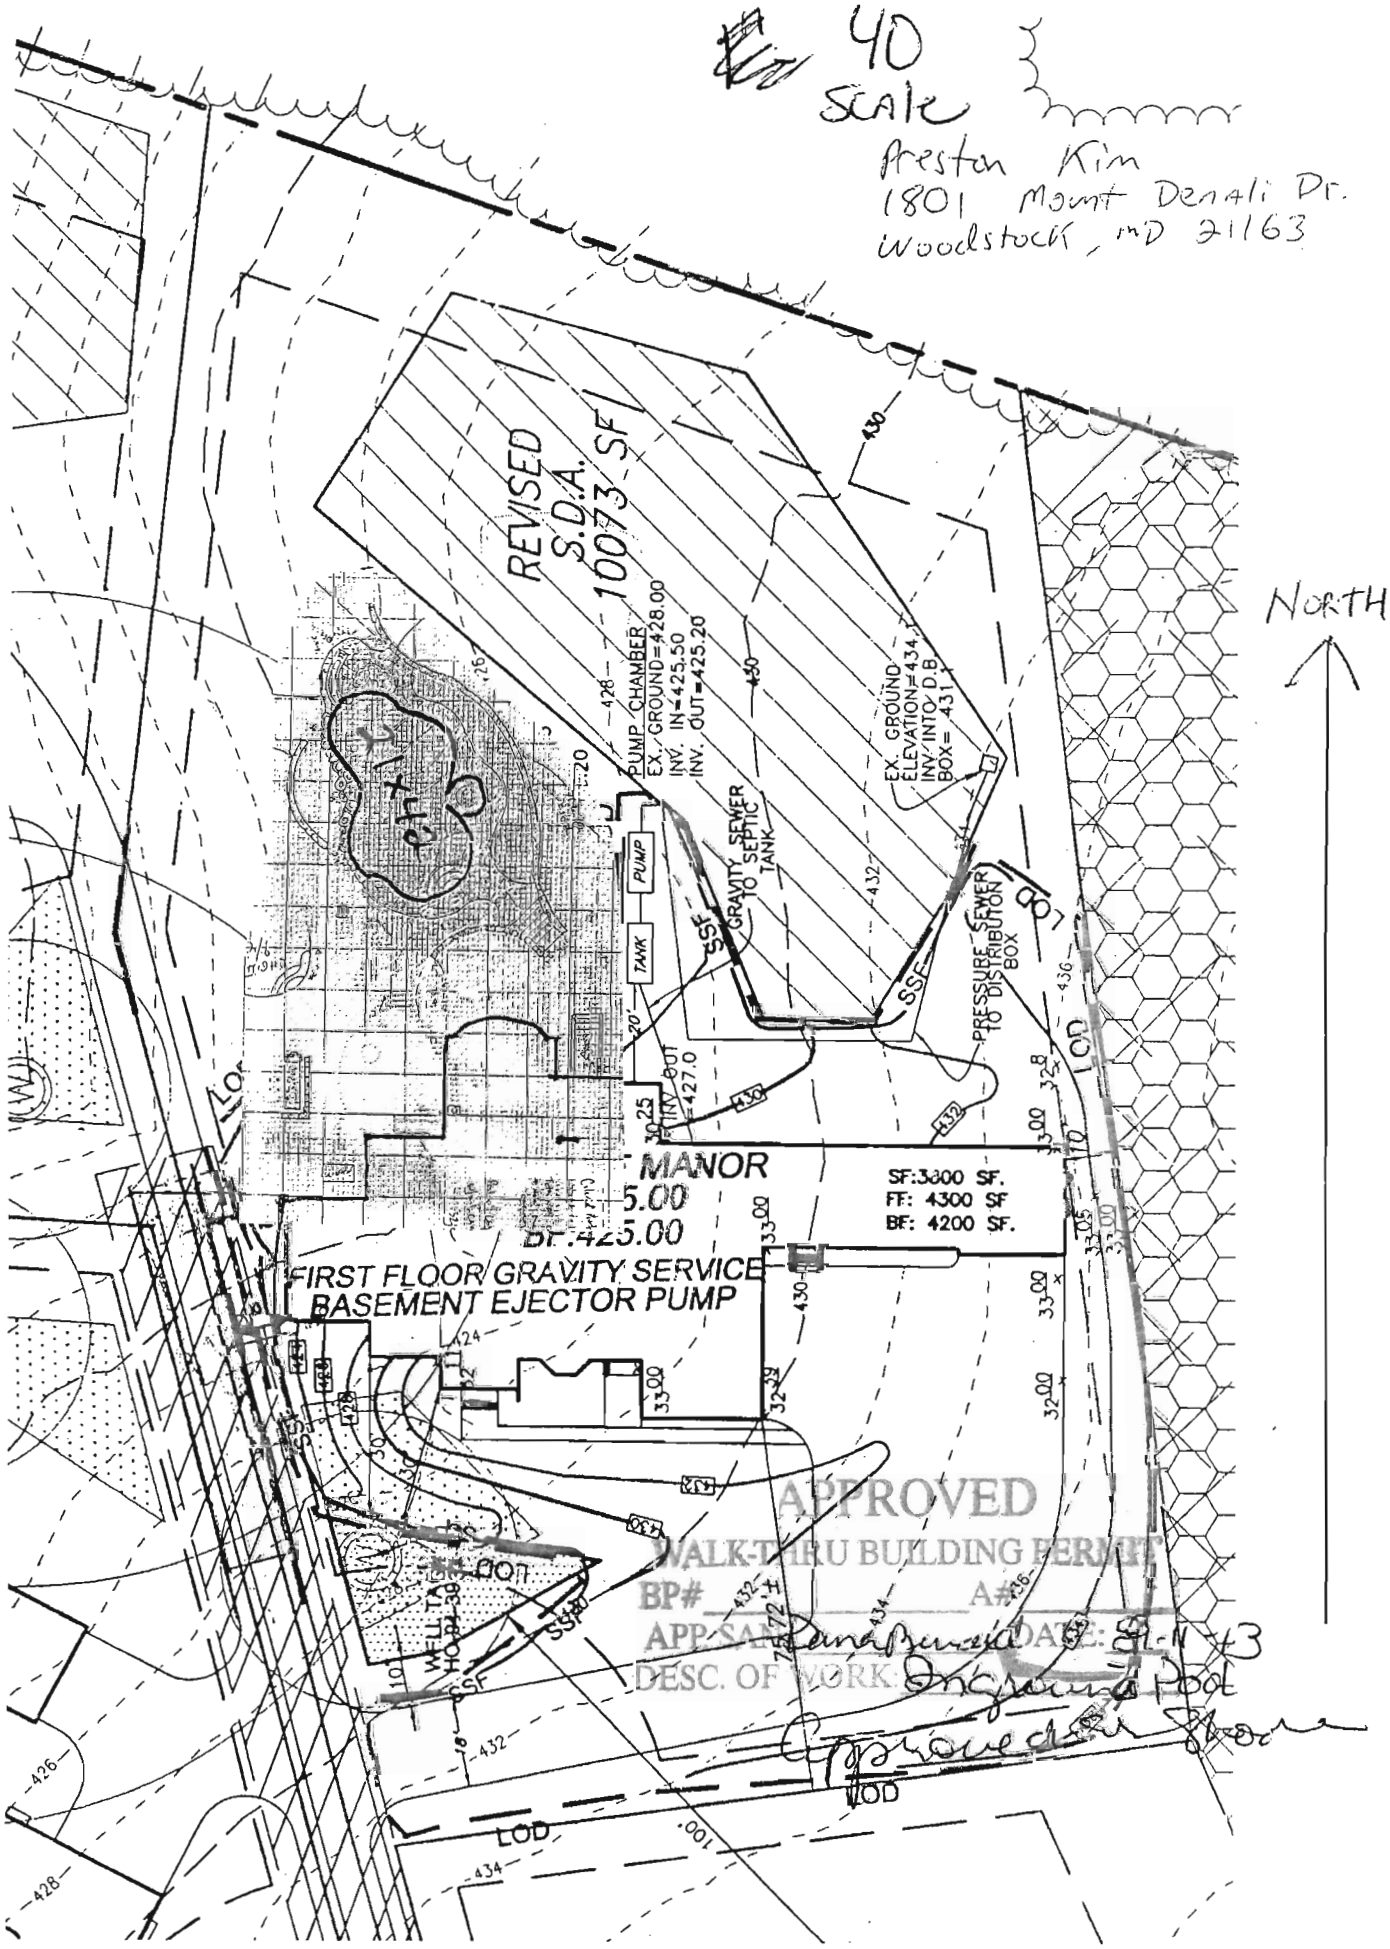

APPROVED
WALK-THRU BUILDING PERMIT
BP# _____ A# _____
APP. SAN. Dana Bennett DATE: 9-11-13
DESC. OF WORK: Inground Pool
Approved for Shore