2/15/2002 10AM
PUBLIC SEWER NOT AVAILABLE
2/20/02 AM

03-
RPS# 285553

ISSUE DATE: 02/11/02

APPROVAL DATE: 2/20/02

PERMIT

INDEXED

P 516511

A REPAIR

ON-SITE SEWAGE DISPOSAL SYSTEM
HOWARD COUNTY HEALTH DEPARTMENT
BUREAU OF ENVIRONMENTAL HEALTH

Fogles Septic Clean, Inc IS PERMITTED TO INSTALL ☐ ALTER ☒

ADDRESS: 580 Obrecht Road, Sykesville PHONE NUMBER: 410-795-5670

SUBDIVISION: LOT NUMBER:

ADDRESS: 2185 Mount View Road PROPERTY OWNER: Klebba

SEPTIC TANK CAPACITY (GALLONS): EX.

PUMP CHAMBER CAPACITY (GALLONS): —

NUMBER OF BEDROOMS: 3

SQUARE FEET PER BEDROOM:

LINEAR FEET OF TRENCH REQUIRED: 100± HOUSE ON PUB H_2O

TRENCHES:	Trench to be 2 feet wide. Inlet 6 feet below original grade. Bottom maximum depth 11½ feet below original grade. Effective area begins at 6 feet below original grade. 5½ feet of stone below distribution pipe.
LOCATION:	TRENCH 25' DOWNHILL OF EX. WELL WELL IS FEED @ SYSTEM INSTALLATION
PURPOSE:	Existing septic system has failed. Call for inspection when ground is opened so sanitarian can recommend repair.

PLANS APPROVED: MR DATE: 2/15/02

NOTE: PERMIT VOID AFTER 2 YEARS
NOTE: CONTRACTOR RESPONSIBLE FOR SCHEDULING A PRE-CONSTRUCTION INSPECTION FOR ALL INSTALLATIONS
NOTE: WATERTIGHT SEPTIC TANKS REQUIRED
NOTE: ALL PARTS OF SEPTIC SYSTMEM SHALL BE 100 FEET FROM ANY WATER WELL
NOTE: MANHOLE RISERS REQUIRED ON ALL SEPTIC TANKS AND PUMP CHAMBERS

NEITHER THE HOWARD COUNTY COUNCIL NOR THE HEALTH DEPARTMENT IS RESPONSIBLE FOR THE SUCCESSFUL OPERATION OF ANY SYSTEM
PERMITTEE RESPONSIBLE FOR OBTAINING FINAL APPROVAL ON THIS PERMIT
CALL 410-313-2640 FOR INSPECTION OF SEPTIC SYSTEM

P516511

NOT TO SCALE

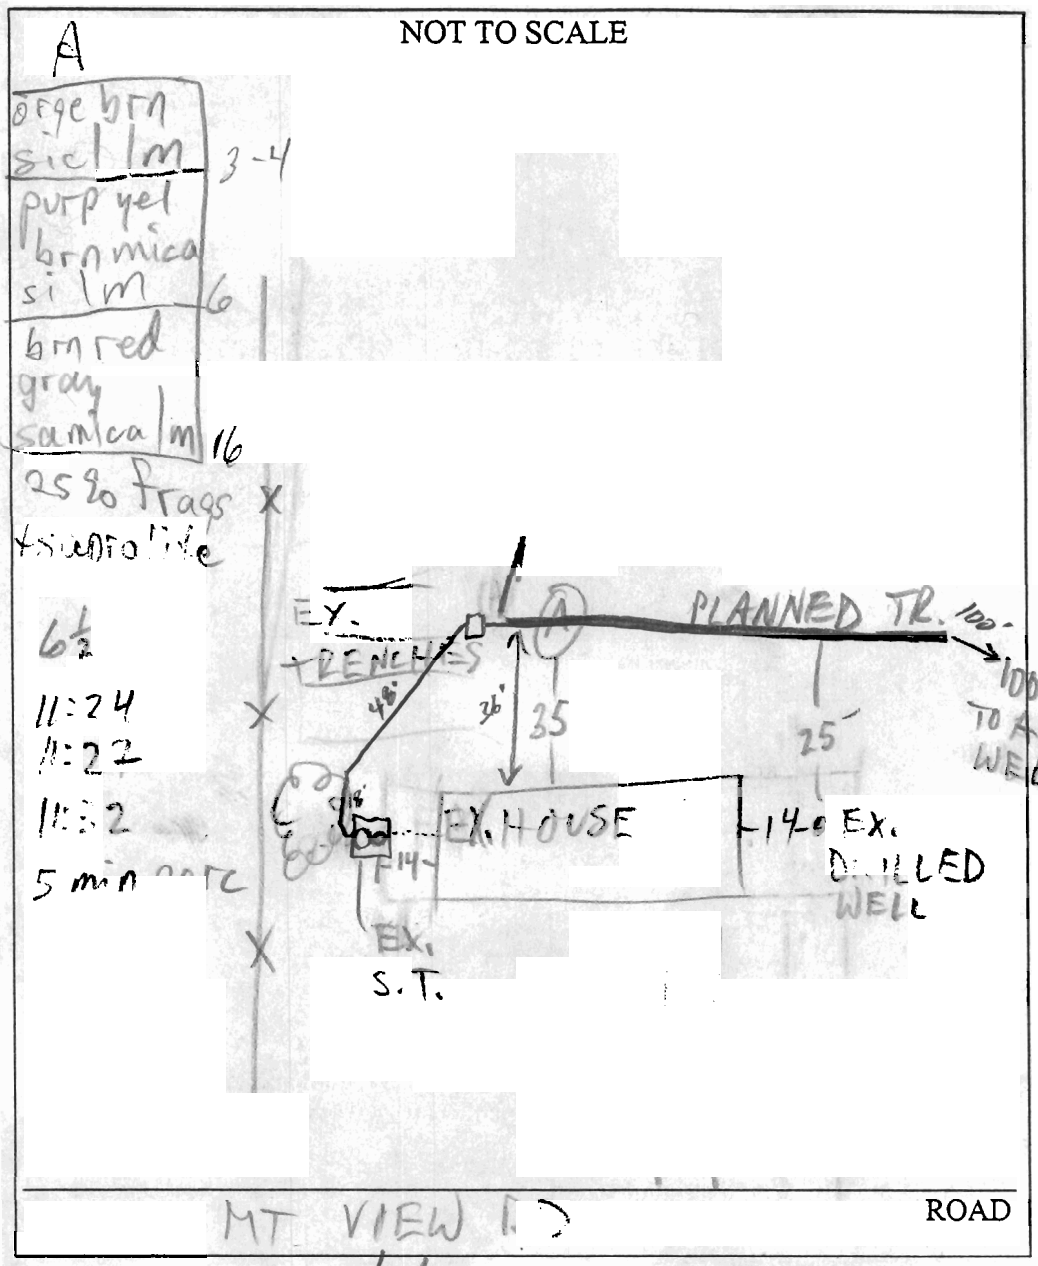

TRENCH/DRAINFIELD DATA

WIDTH	INLET	BOTTOM
2	6'	11.5'

NUMBER OF TRENCHES 1

TOTAL LENGTH 100'

ABSORPTION AREA

DISTRIBUTION BOX LEVEL yes

DISTRIBUTION BOX BAFFLE yes

DISTRIBUTION BOX PORT —

SEPTIC TANK DATA

SEPTIC TANK 1 LEVEL

CAPACITY GAL

SEAM LOC

TANK LID DEPTH

BAFFLES

BAFFLE FILTER

MANHOLE LOC

6" PORT LOC

WATERTIGHT TEST

SEPTIC TANK 2 LEVEL

CAPACITY GAL

SEAM LOC

TANK LID DEPTH

BAFFLES

BAFFLE FILTER

MANHOLE LOC

6" PORT LOC

WATERTIGHT TEST

PRE-CONSTRUCTION 2/15/02 DUE TO DEPTH OF EX S.T. OK TO START NEW TRENCH 6' BELOW GRADE; AB. OF EX. WELL REQ'D FOR TRENCH INST. (MR)

INSTALLATION 2/20/02 T/C TO FOGLES: OK TO PROCEED, WELL AB. EXPECTED TOMORROW (MR) 2/20/02 OK to cover all work. Manhole riser installed on S.T. (CD)

FINAL INSPECTOR [signature] DATE OF APPROVAL 2/20/02

Mount 8/9/61 - 8/10/61 - A.N.

PERMIT

P. 04045

A 03291

SEWAGE DISPOSAL SYSTEM

MARYLAND STATE DEPARTMENT OF HEALTH

HOWARD COUNTY

ELLICOTT CITY

DISTRICT 3

INDEXED

DATE 7/27/61

Carl Williams IS PERMITTED TO INSTALL X, ALTER

ADDRESS West Friendship PHONE HU 9-4891

A SEWAGE DISPOSAL SYSTEM LOCATED AT Mount View Rd. North side 200 ft. west of intersection of Mount View rd and Sand Hill Road

SUBDIVISION ROAD 2185 Sand Hill Road LOT

PROPERTY OWNER Joseph G. Miller

ADDRESS RFD 1 Box 176 Marriottsville

SPECIFICATIONS

DRAIN FIELD ____ DEPTH ____ FEET, BOTTOM AREA ____ SQ. FT.

SEEPAGE PITS ____ ABSORBENT SIDE-WALL AREA ____ SQ. FT.

SEPTIC TANK CAPACITY 750 GALLONS

FOR GARBAGE GRINDER, INCREASE DISPOSAL AREA 25% & TANK CAPACITY 50%

OTHER Tile Field-318 sq. ft. bottom area located in the area 18 ft. to 150 ft. from the side of the lot closest to Sand Hill Rd. and 65 ft. to 140 ft. from the from lot line. Septic tank cannot be installed more than 3 feet below original grade.

PLANS APPROVED BY Raymond Hodges/dma DATE 1/10/61

FILL SEPTIC TANK AND DISTRIBUTION BOX WITH WATER BEFORE CALLING FOR AN INSPECTION. COVER NO WORK UNTIL INSPECTED AND APPROVED.

NEITHER THE HOWARD COUNTY COMMISSIONERS NOR THE HEALTH DEPARTMENT IS RESPONSIBLE FOR THE SUCCESSFUL OPERATION OF ANY SYSTEM.

16220

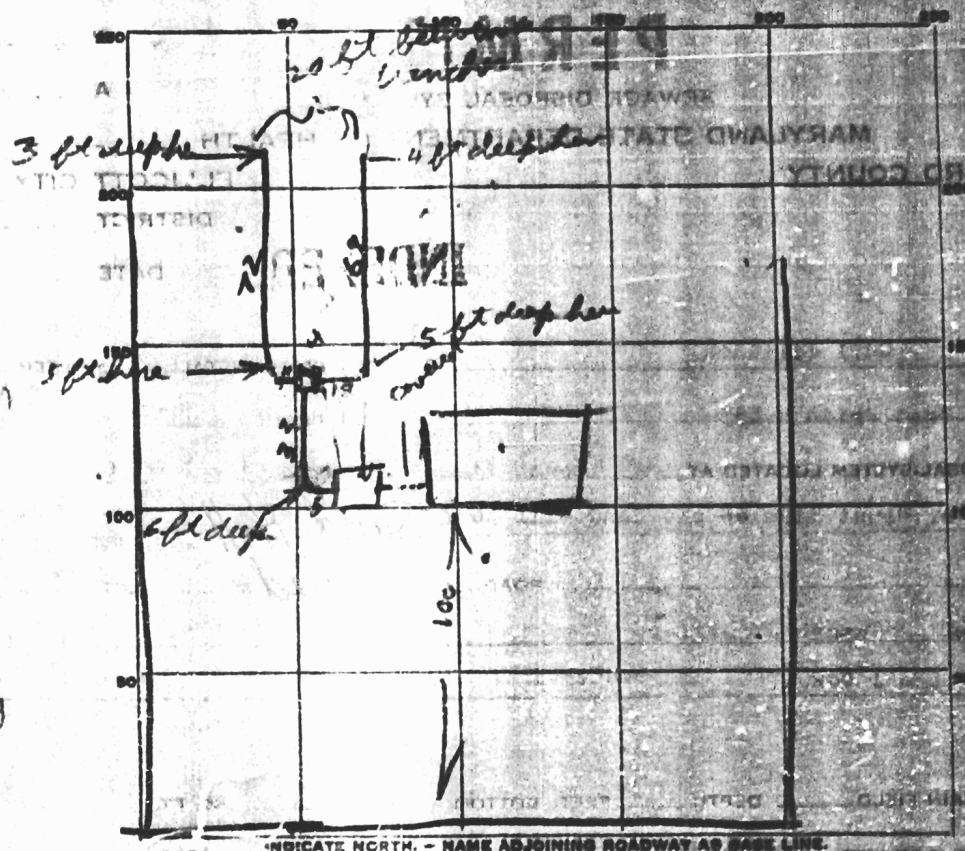

INDICATE NORTH. – NAME ADJOINING ROADWAY AS BASE LINE.

PERMIT CARD Yes

SEPTIC TANK, LEVEL OK 750 gal CLEANOUTS 8" lint

Top in 4 ft to 5 ft below grade

DISTRIBUTION BOX, LEVEL [illegible] level but will be 4 ft below grade

TILE FIELD, DEPTH 36-3 FT. TRENCH WIDTH 2 FT.

GRAVEL DEPTH 12 IN. TOTAL LENGTH ~~159~~ FT.

NUMBER OF TRENCHES 2 TOTAL BOTTOM AREA 318

SEEPAGE PITS, INSIDE DIAMETER _____ FT. DEPTH BELOW INLET _____ FT.

ABSORBENT AREA 310 SQ. FT.

REMARKS Sewer from house to distribution box in 6 ft to 5 ft below grade & of orange berg, unsaturated & unfractured

DATE SYSTEM APPROVED _____ INSPECTOR _____