MARYLAND DEPARTMENT OF THE ENVIRONMENT, WATER MANAGEMENT ADMINISTRATION
2500 BROENING HIGHWAY, BALTIMORE, MARYLAND 21224, (410) 631-3784

****

WATER WELL ABANDONMENT-SEALING REPORT FORM

****

SUBMIT COPIES OF COMPLETED FORM TO:

- COUNTY ENVIRONMENT AGENCY (contact MDE, WMA if address needed)
- WELL OWNER
- MDE, WATER MANAGEMENT ADMINISTRATION, WELL PROGRAM

DATE WELL ABANDONED: 2-22-02 (month/day/year)

★ PERMIT NUMBER OF ABANDONED WELL (if any) NO Tag — —

★ PERMIT NUMBER OF REPLACEMENT WELL — —

★ PERSON ABANDONING WELL: Allen Compton WELL DRILLERS LICENSE NUMBER: 009

CIRCLE: MWD/(MSD)/MGD

★ OWNER'S NAME: John ~~Clay~~ Klehba

★ WELL LOCATION:
COUNTY: Howard
NEAREST TOWN: West Friendship
TAX MAP _____ BLOCK _____ PARCEL _____
SUBDIVISION: _____
SECTION: _____ LOT: _____
NEAREST ROAD: Old Frederick rd.

SITE LOCATION MAP

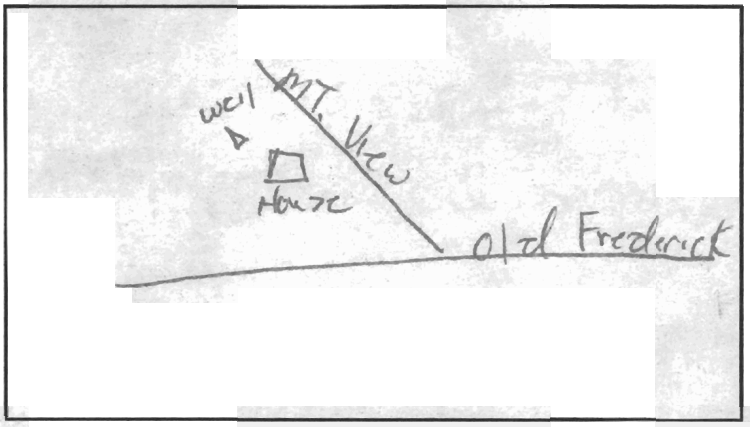

★ TYPE OF WELL BEING ABANDONED:

✓ DRILLED ____ JETTED
____ BORED/AUGERED ____ HAND DUG
____ OTHER (specify) _____

★ USE CODE:

✓ DOMESTIC ____ MUNICIPAL/PUBLIC
____ IRRIGATION ____ INDUSTRIAL
____ TEST/OBSERVATION ____ GEOTHERMAL

★ TYPE OF CASING:

✓ STEEL ____ PLASTIC
____ CONCRETE OTHER (specify) _____

★ SIZE OF CASING: 6" INCHES IN DIAMETER

★ DEPTH OF WELL: 210' FEET DEEP

★ WAS ANY CASING REMOVED? ✓ YES ____ NO
if yes, length removed, in feet: 2'

★ WAS CASING RIPPED OR PERFORATED? ____ YES ✓ NO

LOG OF SEALING MATERIAL

MATERIAL	FEET FROM	FEET TO
Cement	0	210

VOLUME OF MATERIAL USED

3+ yards

Allen Compton 009 MWD/(MSD)/MGD 2-22-02
SIGNATURE-MASTER WELL DRILLER OR SUPERVISING SANITARIAN LICENSE # CIRCLE ONE DATE

DENV 828 JULY 199/ 2) COUNTY ENVIRONMENTAL AGENCY