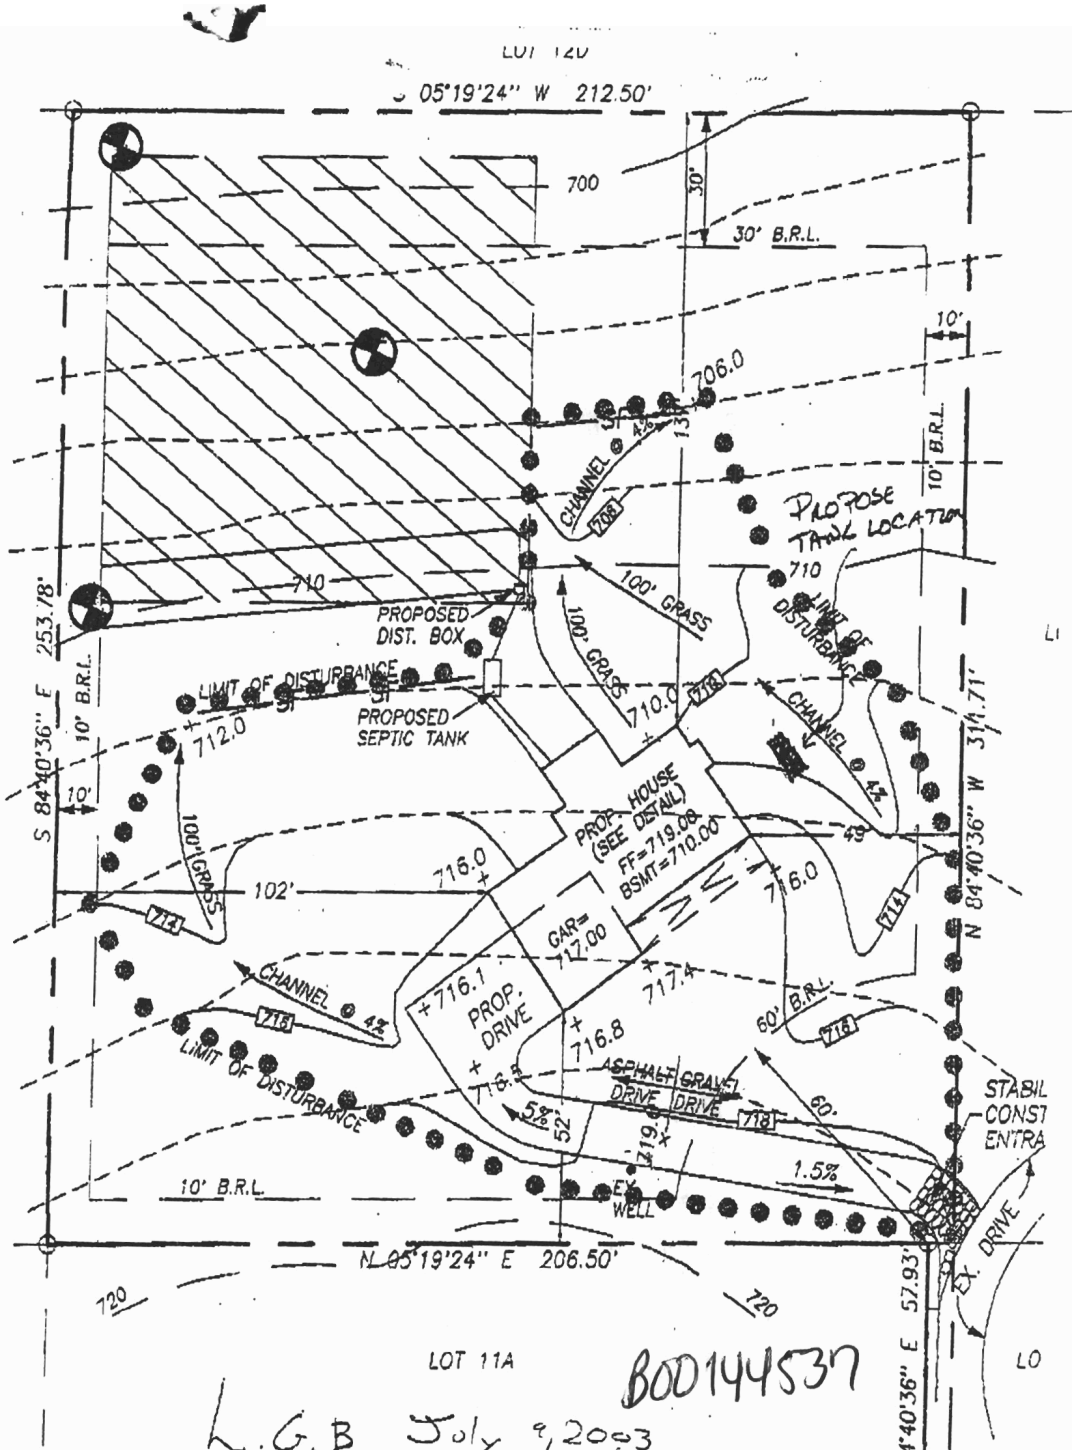

B00144537

L.G.B July 9, 2003

MAB 7/9/03

10/17/03

LP Tank location ok