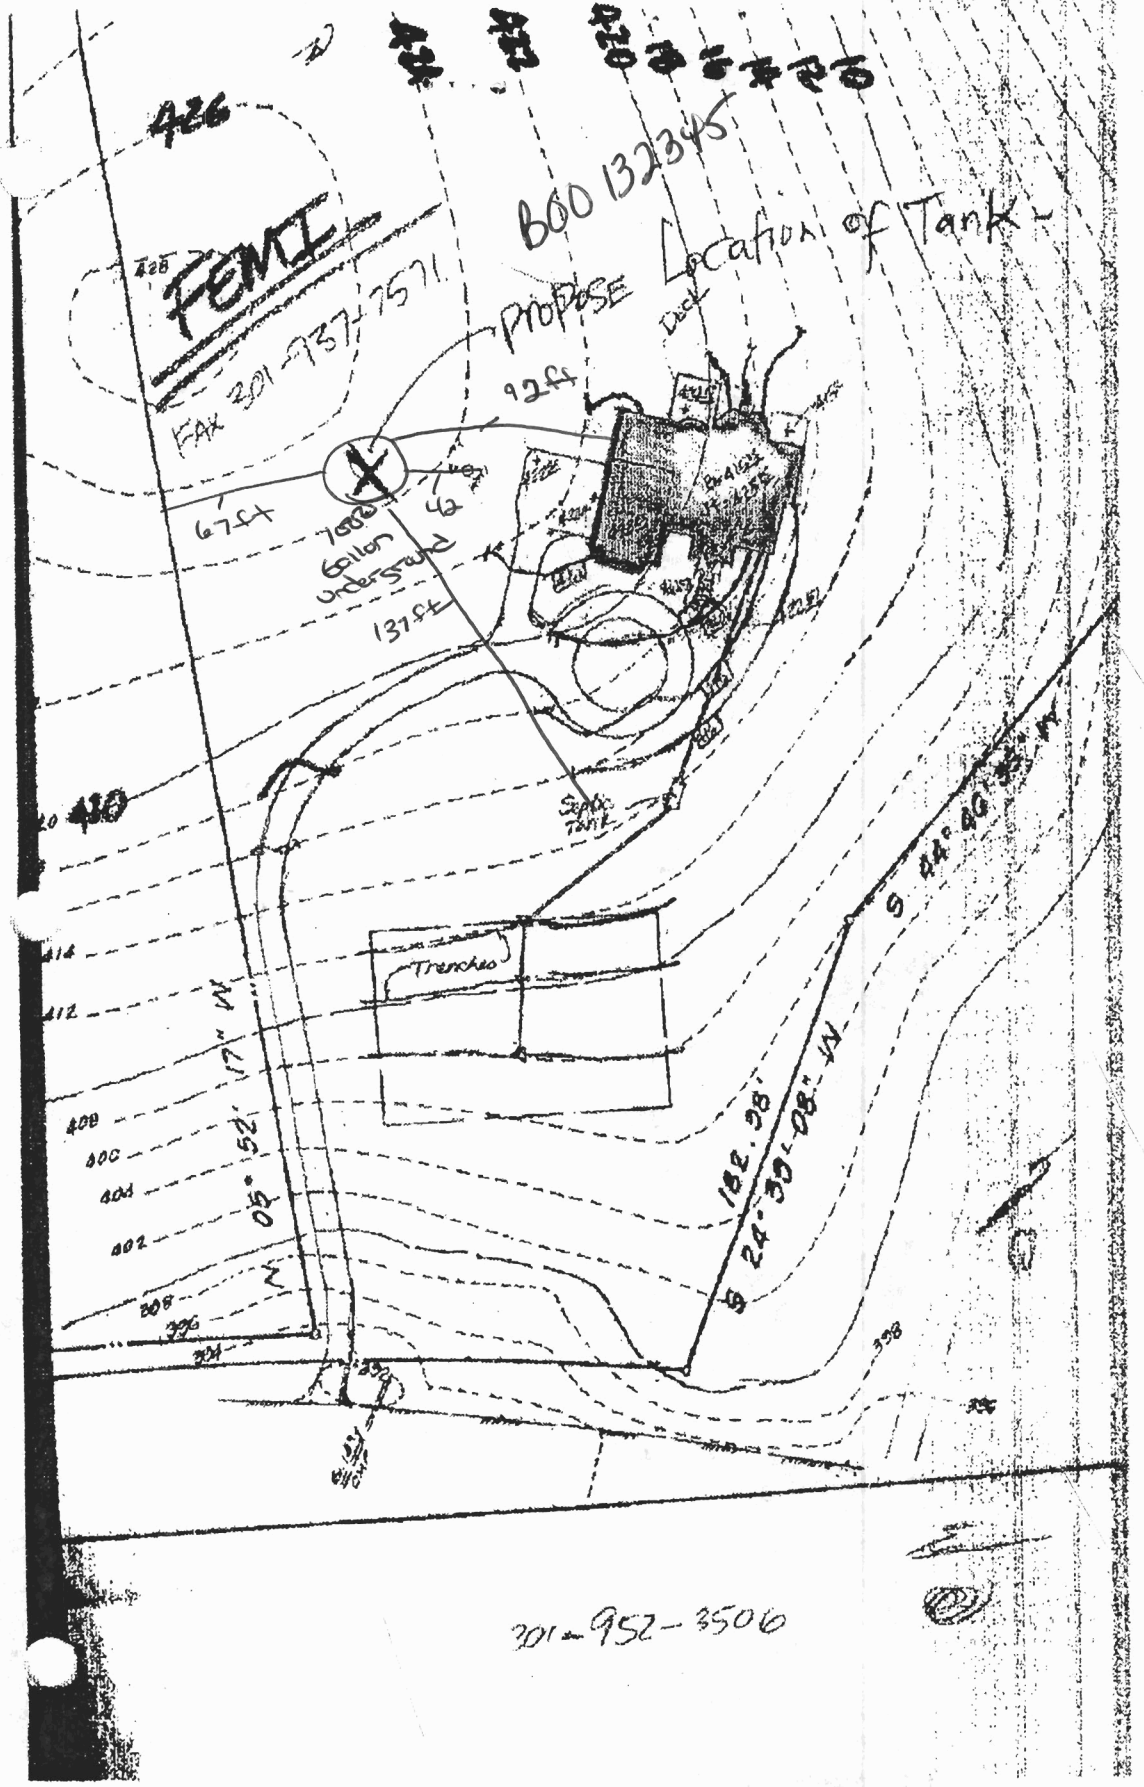
426
FEMI
FAX 301-937-7571
B00 132345
Propose Location of Tank
92ft
67ft
42
1000 Gallon Underground
137ft
Deck
Septic Tank
Trenches
410
414
412
408
406
404
402
398
396
394
392
390
N 05° 52' 17" W
S 24° 39' 08" W
182.38
S 44° 40' 42" W
398
301-952-3506

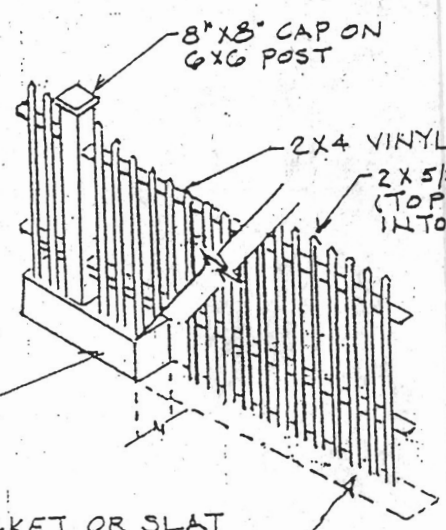

PICKET OR SLAT

N.T.S.

732