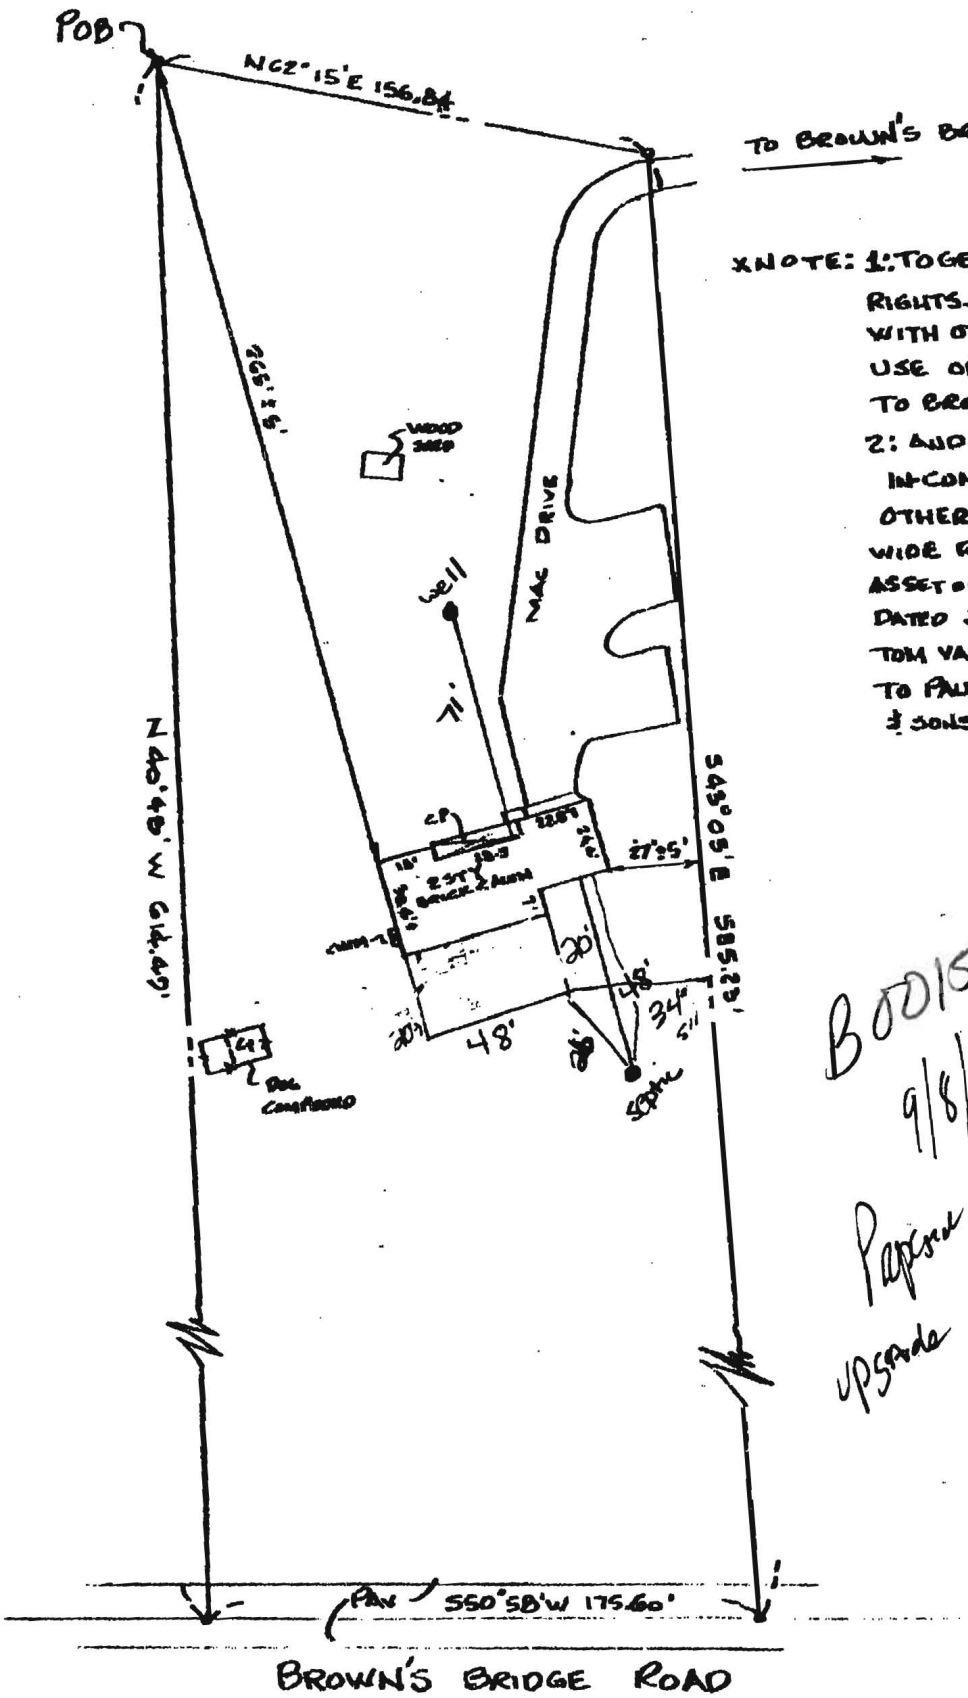

XNOTE: 1: TOGETHER WITH THE RIGHTS-IN-COMMON WITH OTHERS TO THE USE OF A RIGHT OF WAY TO BROWN'S BRIDGE ROAD

2: AND WITH THE USE-IN-COMMON WITH OTHERS OF A 15 FOOT WIDE RIGHT-OF-WAY ASSET OUT IN AN AGREEMENT DATED JUNE 21, 1975 FROM TOM VAN DER ZWET, ET AL TO PAUL C. THOMPSON & SONS, INC.

B00155731
9/8/05
Paperwork Sunrun do
upgrade complete.

plat is of benefit to a consumer only insofar as it is required by a lender or
le insurance company or its agent in connection with contemplated transfer.

*7998 BROWN'S BRIDGE ROAD