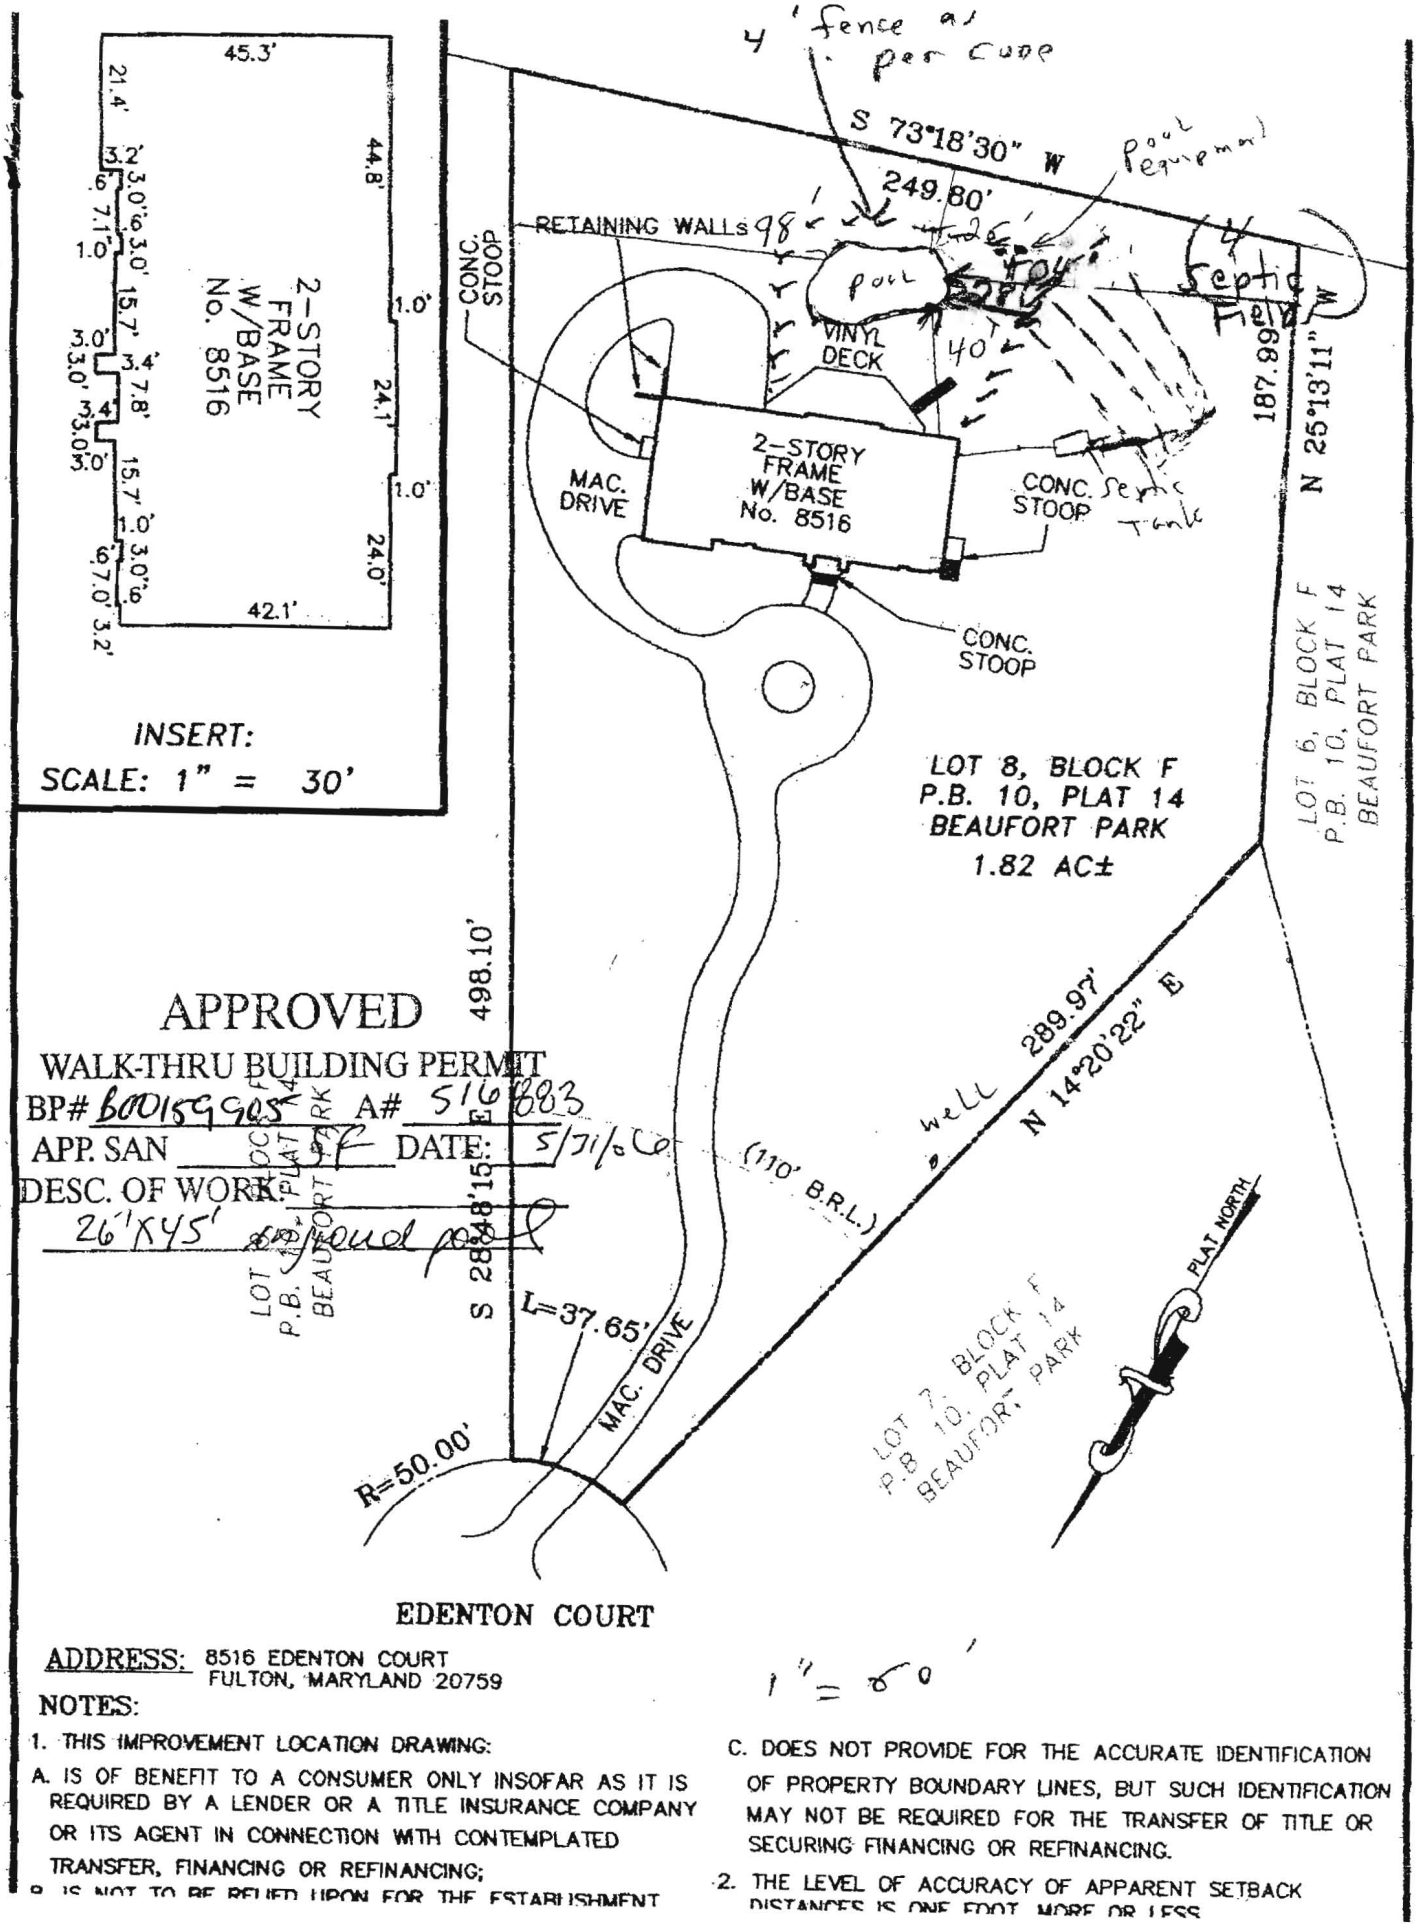

APPROVED

WALK-THRU BUILDING PERMIT

BP# B00159905 A# 516883

APP. SAN _____ DATE: 5/31/06

DESC. OF WORK:

26'X45' above pool

ADDRESS: 8516 EDENTON COURT
FULTON, MARYLAND 20759

NOTES:

1. THIS IMPROVEMENT LOCATION DRAWING:

A. IS OF BENEFIT TO A CONSUMER ONLY INSOFAR AS IT IS REQUIRED BY A LENDER OR A TITLE INSURANCE COMPANY OR ITS AGENT IN CONNECTION WITH CONTEMPLATED TRANSFER, FINANCING OR REFINANCING;

B. IS NOT TO BE RELIED UPON FOR THE ESTABLISHMENT

C. DOES NOT PROVIDE FOR THE ACCURATE IDENTIFICATION OF PROPERTY BOUNDARY LINES, BUT SUCH IDENTIFICATION MAY NOT BE REQUIRED FOR THE TRANSFER OF TITLE OR SECURING FINANCING OR REFINANCING.

2. THE LEVEL OF ACCURACY OF APPARENT SETBACK DISTANCES IS ONE FOOT MORE OR LESS