FRANCIS H. BAER PROPERTY
LOTS 6 & 7 RESUB. LOTS 4 & 5
PLAT 4263
7TH ELECTION DISTRICT
HOWARD COUNTY, MD

PROPERTY LINES OR CORNERS.

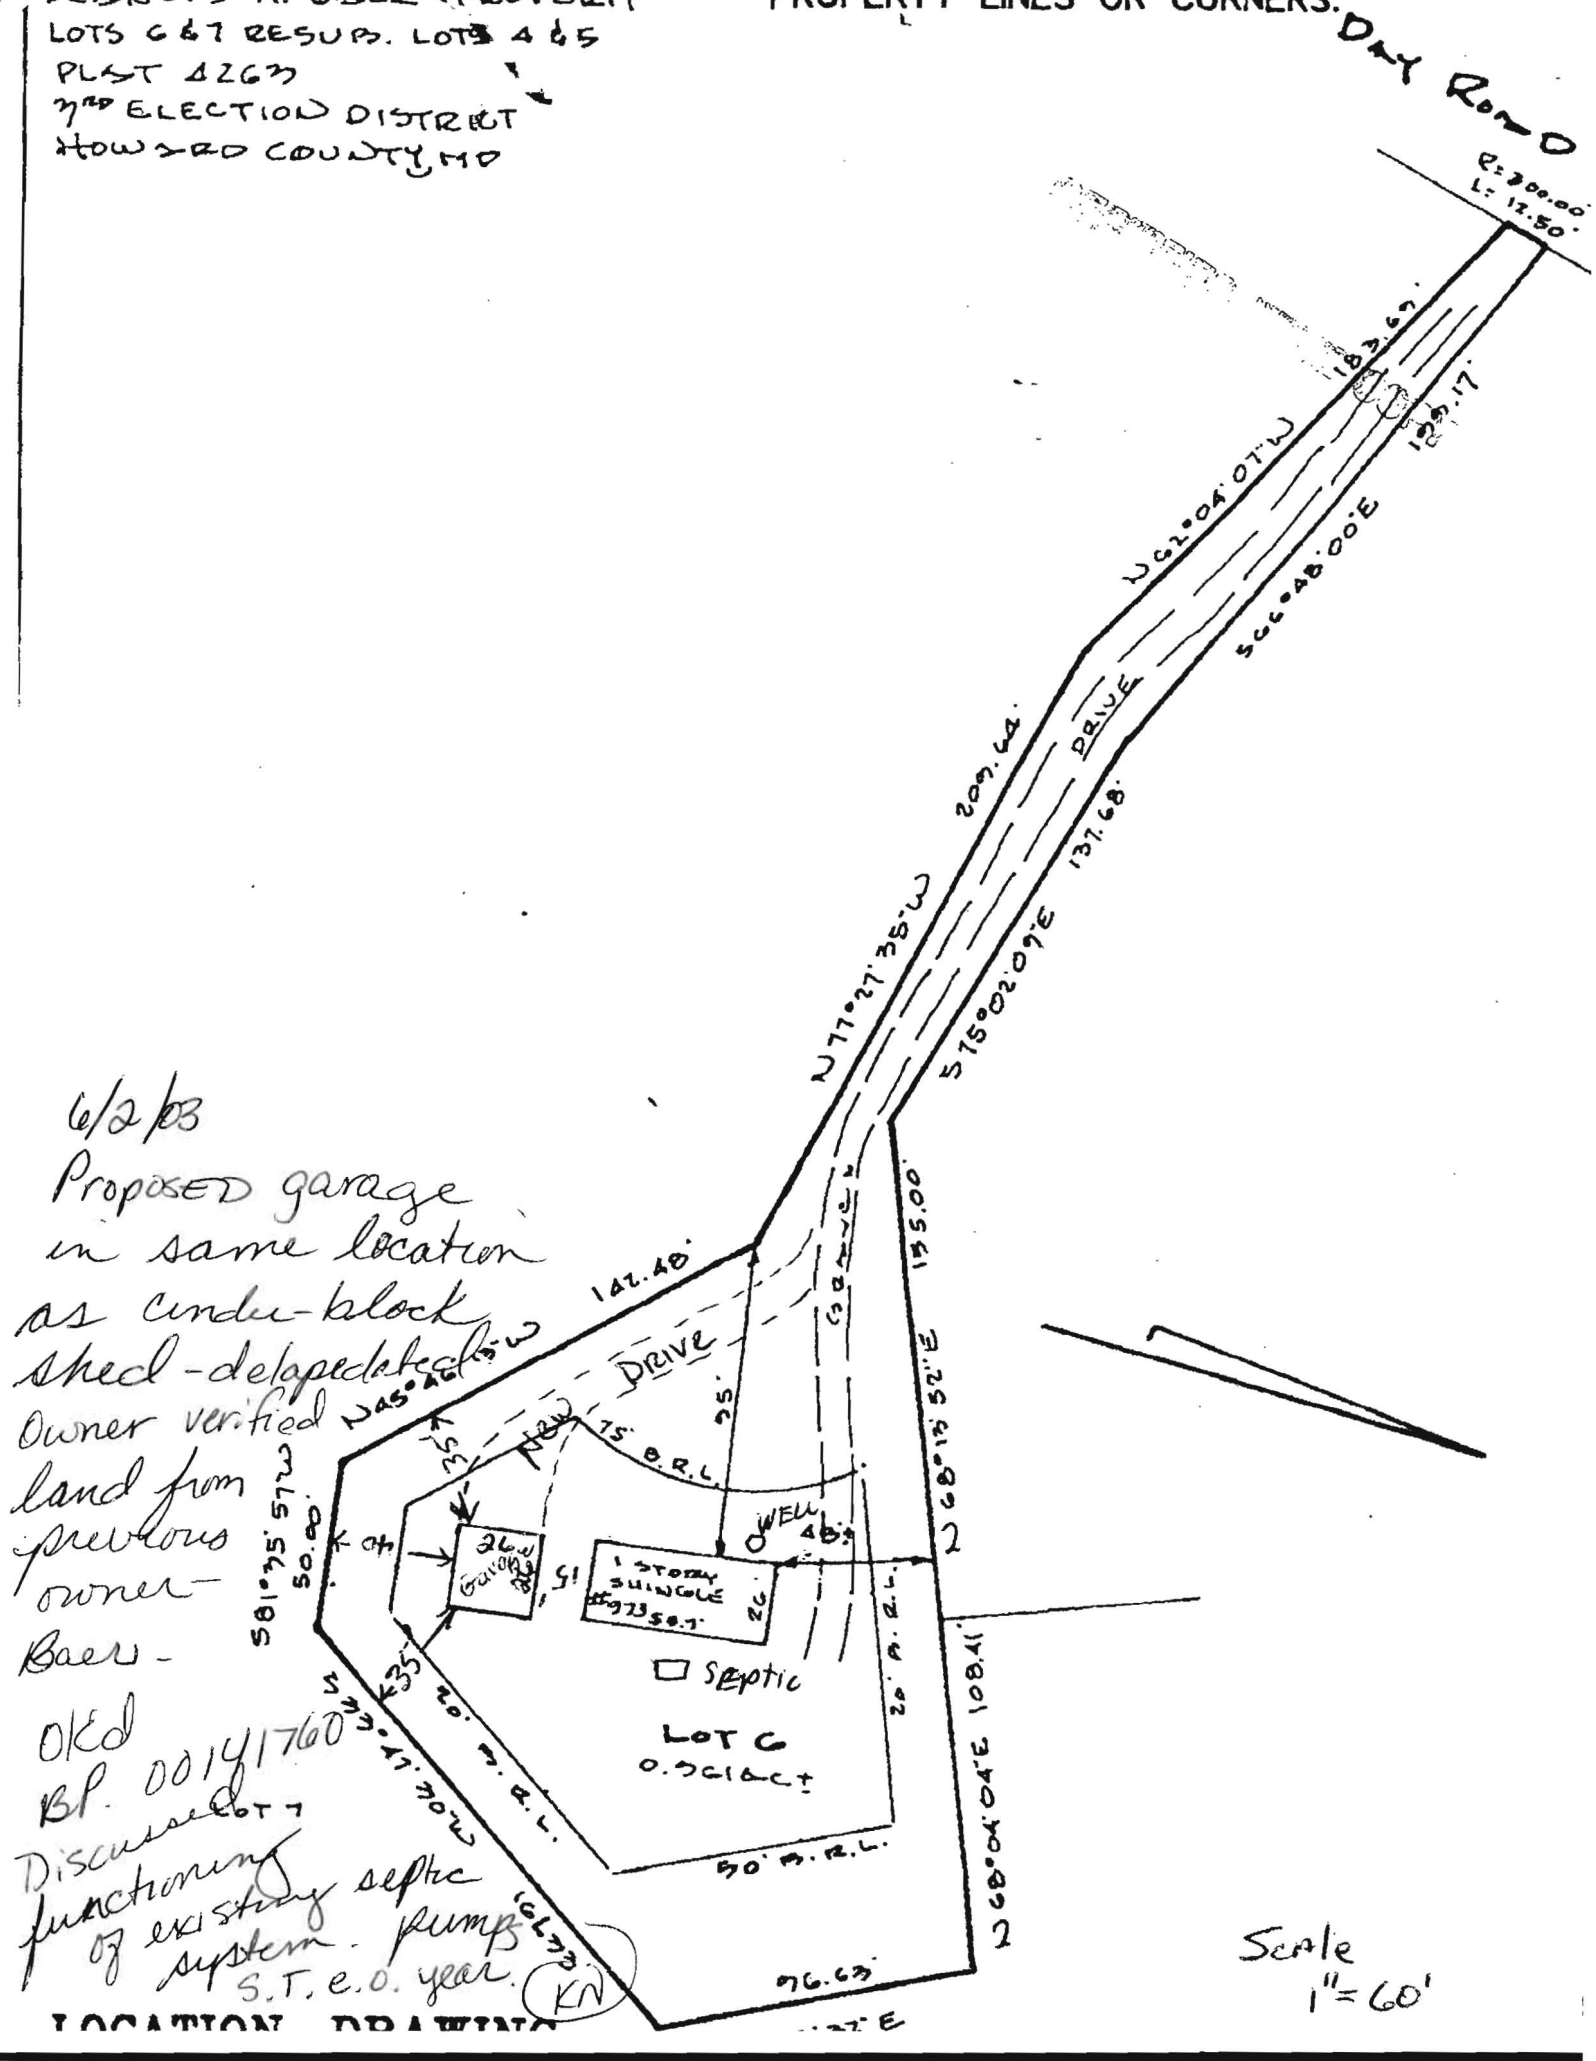

6/2/03
Proposed garage in same location as cinder-block shed - delapidated
Owner verified land from previous owner - Baer -
OKd
BP. 00141760
Discussed functioning of existing septic system. pump S.T.E.O. year.
KN

Scale
1" = 60'

LOCATION DRAWING