DEPARTMENT OF INSPECTIONS, LICENSES AND PERMITS
3430 COURT HOUSE DRIVE
ELLICOTT CITY, MD 21043
PERMITS (410) 313-2455 INSPECTIONS (410) 313-1810
AUTOMATED INFORMATION (410) 313-3800

HOWARD COUNTY PERMIT APPLICATION

PERMIT NUMBER B0043855 prev. strum

Building Address 11718 OLD FREDERICK RD. MARRIOTTSVILLE 21104

Suite/Apt. #: _____ SDP/WP/Petition #: _____

Census Tract 6030 Subdivision _____

Section _____ Area _____ Lot _____

Tax Map 10 Parcel 100 Grid 20

Zoning _____ Map Coordinates SRD Lot size _____

Existing Use SUNDECK SF Home

Proposed Use SUNROOM 10x Sqft

Estimated Construction Cost $ 25,000

Description of Work PUT ROOF & WALLS ON EXISTING SUNDECK 24'x16'

Occupant or Tenant OWNER

Contact Name _____

Address _____

City _____ State _____ Zip Code _____

Phone _____ Fax _____

Property Owner's Name DAVID + BETSY HASLUP

Address 11718 OLD FREDERICK RD

City MARRIOTTSVILLE State MD Zip Code 21104

Home Phone 410 984 6158 Work Phone SAME

Applicant's Name & Mailing Address, (if other than stated hereon):

Phone _____ Fax _____

Contractor Company MARK MWHORTER

Contact Person SAME

Address 6851 REDBERRY RD

City CLARKSVILLE State MD Zip Code 21029

License No. 9807

Phone 301 674 5854 Fax 301 854 3449

Engineer or Architect Company SAME

Contact Person _____

Address _____

City _____ State _____ Zip Code _____

Phone _____ Fax _____

BUILDING DESCRIPTION - *COMMERCIAL*

Building Characteristics

Height: 10'

No. of stories: 1

Gross area, sq. ft. per floor: 384 ø

Use group: _____

Construction type:
_____ Reinforced Concrete
_____ Structural Steel
_____ Masonry
X Wood Frame

_____ State Certified Modular

Utilities

Water Supply:
____ Public
____ Private

Sewage Disposal:
____ Public
____ Private

Electric Yes ☒ No ☐
Gas Yes ☐ No ☐

Heating System:
Electric ☐ Oil ☐
Natural Gas ☐
Propane Gas ☐

Sprinkler system: N/A ☐
____ Full
____ Partial
____ Other Suppression
____ # of Heads

BUILDING DESCRIPTION - *RESIDENTIAL*

Building Characteristics

SF Dwelling ☒ SF Townhouse ☐

	Depth	Width
1st floor:	16	24
2nd floor:		
Basement:		

Finished Basement ☐ Unfinished Basement ☐
Crawl space ☐ Slab on Grade ☐
No. of Bedrooms _____

Multi-family dwellings:
No. of efficiency units: _____
No. of 1 BR units: _____
No. of 2 BR units: _____
No. of 3 BR units: _____

Other Structure: _____
Dimensions: _____
Footings: _____
Roof: _____

_____ State Certified Modular
_____ Manufactured Home

Utilities

Water Supply:
____ Public
✓ Private

Sewage Disposal:
____ Public
✓ Private

Electric Yes ☐ No ☐
Gas Yes ☐ No ☐

Heating System:
Electric ☐ Oil ☐
Natural Gas ☐
Propane Gas ☐

Sprinkler system: N/A ☐
_____ NFPA #13D
_____ NFPA #13R
_____ Other:

THE UNDERSIGNED HEREBY CERTIFIES AND AGREES AS FOLLOWS. (1) THAT HE/SHE IS AUTHORIZED TO MAKE THIS APPLICATION; (2)THAT THE INFORMATION IS CORRECT; (3) THAT HE/SHE WILL COMPLY WITH ALL REGULATIONS OF HOWARD COUNTY WHICH ARE APPLICABLE THERETO; (4) THAT HE/SHE WILL PERFORM NO WORK ON THE ABOVE REFERENCED PROPERTY NOT SPECIFICALLY DESCRIBED IN THIS APPLICATION; (5) THAT HE/SHE GRANTS COUNTY OFFICIALS THE RIGHT TO ENTER ONTO THIS PROPERTY FOR THE PURPOSE OF INSPECTING THE WORK PERMITTED AND POSTING NOTICES.

Mark Mwhorter
Applicant's Signature

MARK MWHORTER
Print Name

MWHORTER CONTRACTING
Title/Company

8-28-03
Date

Checks payable to: *DIRECTOR OF FINANCE OF HOWARD COUNTY*
** PLEASE WRITE NEATLY AND LEGIBLY. **
- FOR OFFICE USE ONLY -

AGENCY	DATE	SIGNATURE APPROVAL
Land Development, DPZ		
State Highways		
Building Official	8/28/03	
Dev. Engineering, DPZ		
Health	8/29/03	
Fire Protection		

Is Sediment Control approval required prior to issuance?
YES ☐ NO ☐

CONTINGENCY CONSTRUCTION START: ☐
ONE STOP SHOP: ☐

DPZ SETBACK INFORMATION

Front: _____
Rear: _____
Side: _____
Side St.: _____

All minimum setbacks met?
YES ☐ NO ☐

Is Entrance Permit required?
YES ☐ NO ☐

Historic District?
YES ☐ NO ☐

Lot Coverage for NewTown Zone _____

SDP/Red-line approval date _____

PROPERTY ID#: 31834

Filing fee	$	25
Permit fee	$	69
Excise tax	$	307
Add'l per. fee	$	7
TOTAL FEES	$	408
Sub-total paid	$	
Balance due	$	
Check	#	2207
Validation	#	32268

Accepted by DD

Distribution of Copies- White: Building Official Green: LDD, DPZ Yellow: DED, DPZ Pink: Health Gold: SHA

T:\forms\PERMIT.FRM

Rev. 5/17/00

B-03082

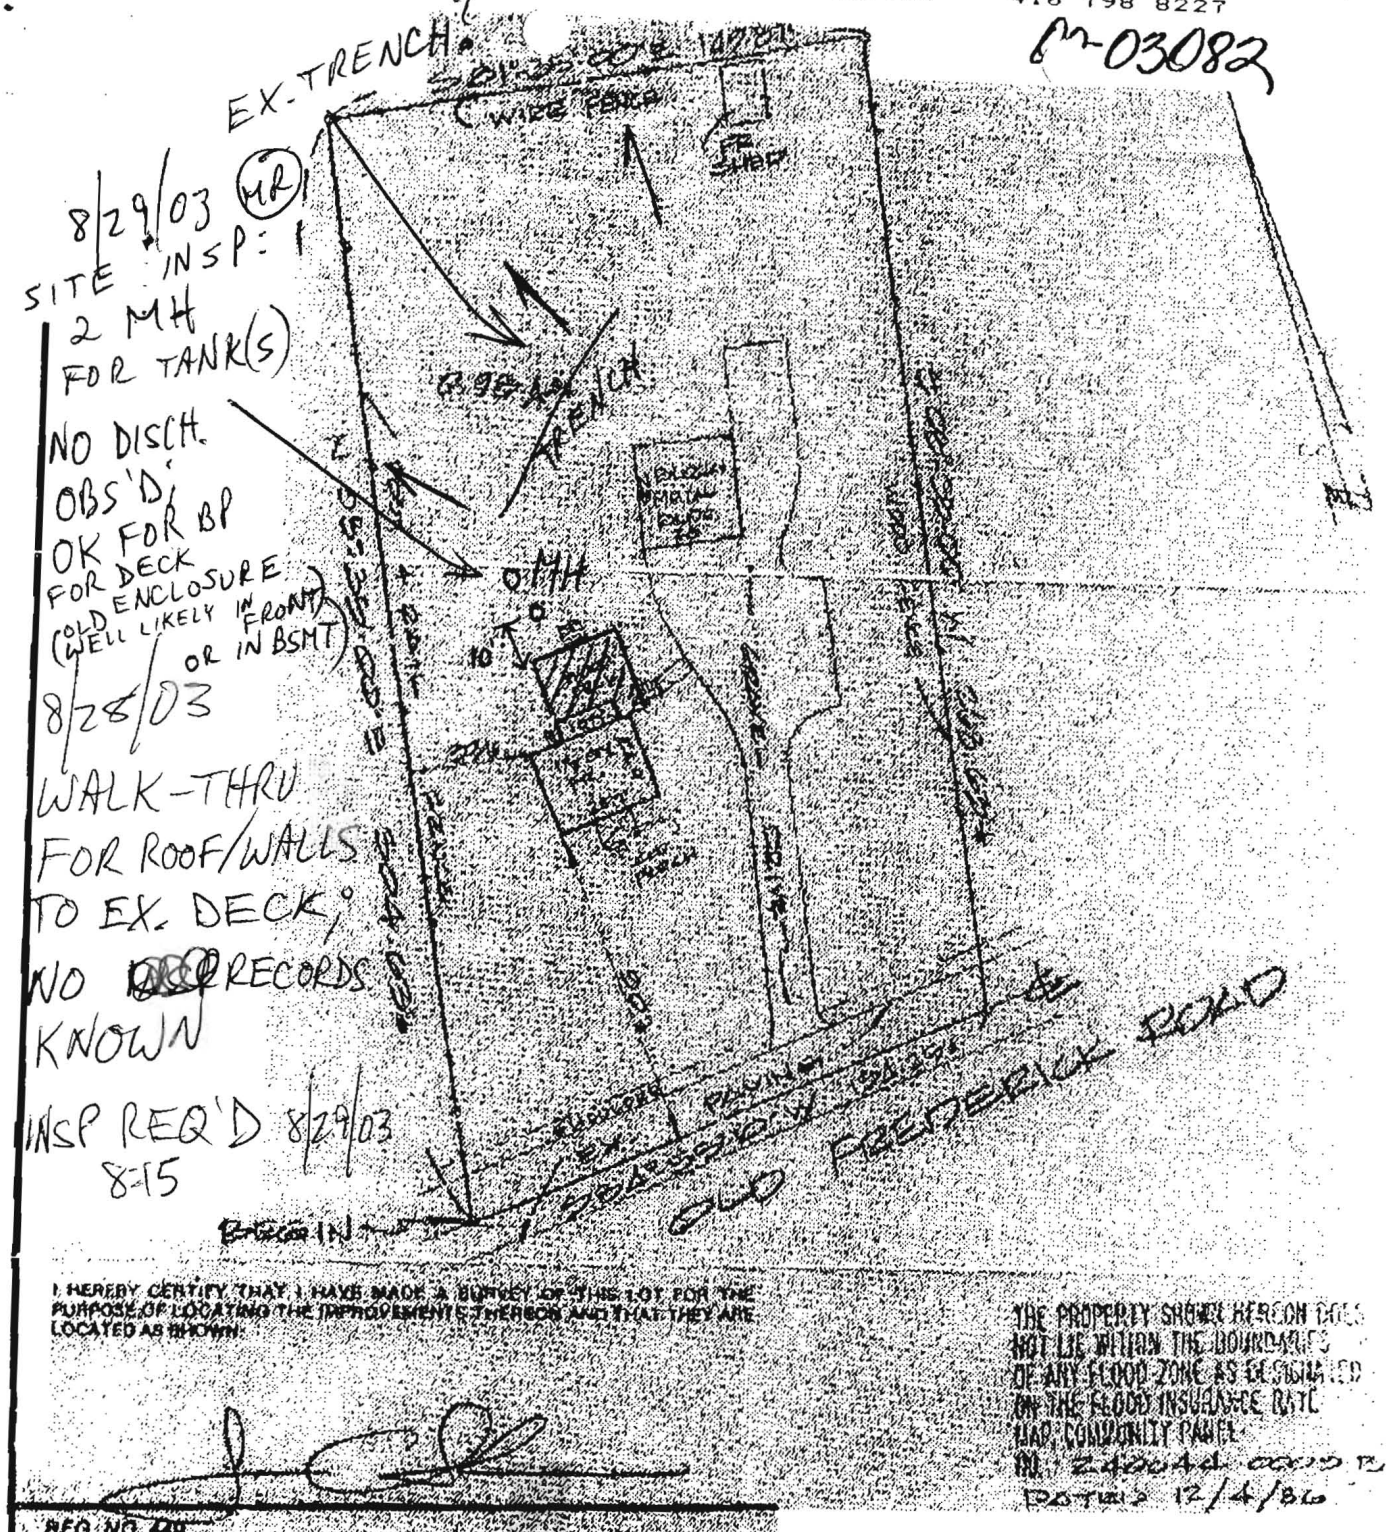

I HEREBY CERTIFY THAT I HAVE MADE A SURVEY OF THIS LOT FOR THE PURPOSE OF LOCATING THE IMPROVEMENTS THEREON AND THAT THEY ARE LOCATED AS SHOWN.

THE PROPERTY SHOWN HEREON DOES NOT LIE WITHIN THE BOUNDARIES OF ANY FLOOD ZONE AS DESIGNATED ON THE FLOOD INSURANCE RATE MAP, COMMUNITY PANEL NO. 240044 0010 B DATED 12/4/86

REG. NO. 420

W.T. SADLER
SURVEYORS
152 WESTMINSTER ROAD
REISTERSTOWN, MD
21136
(301) 526-5618

STATE OF MARYLAND — JAMES CARROLL SADLER — NO. 448 — REGISTERED PROPERTY LINE SURVEYOR

LOCATION SURVEY

11718 OLD FREDERICK ROAD
HOWARD COUNTY, MD

SCALE	DATE	APP. NO.
1"=50'	2-3-1992	JOB NO. J-2245