6231

STATE OF MARYLAND
WATER RESOURCES ADMINISTRATION
TAWES STATE OFFICE BLDG., ANNAPOLIS, MD. 21401
WELL COMPLETION REPORT

FILL IN THIS FORM COMPLETELY

COUNTY NUMBER: A-602

DATE RECEIVED

DATE WELL COMPLETED: March 27-73

DEPTH OF WELL: 140 (TO NEAREST FOOT)

PERMIT NO. FROM "PERMIT TO DRILL WELL": MO-73-C-1-12

DRILLERS IDENTIFICATION NO.: 42

OWNER: Vincent Cohini

STREET OR RFD: 208 Congressional Ln.

POST OFFICE: Rockville Md.

WELL LOG

STATE THE KIND OF FORMATIONS PENETRATED, THEIR COLOR, DEPTH, THICKNESS AND IF WATER BEARING

DESCRIPTION (USE ADDITIONAL SHEETS IF NECESSARY)	FEET FROM	FEET TO	WATER BEARING
top soil	0	3	
rock	3	15	
green slate	15	115	✓
blue slate	115	120	

GROUTING RECORD

WELL HAS BEEN GROUTED (CIRCLE APPROPRIATE BOX): Y N

TYPE OF GROUTING MATERIAL (CIRCLE BOX): CEMENT (C M) BENTONITE CLAY (B C)

NO. OF BAGS: 6 NO. OF POUNDS: 660

GALLONS OF WATER: 30

DEPTH OF GROUT SEAL (TO NEAREST FOOT): FROM 0 FT. TO 18 FT.

(ENTER 0 IF FROM SURFACE)

CASING RECORD

CASING TYPE (INSERT APPROPRIATE CODE BELOW): S T STEEL; C O CONCRETE; P L PLASTIC; O T OTHER

MAIN CASING TYPE: S T

NOMINAL DIAMETER TOP (MAIN) CASING (NEAREST INCH): 6

TOTAL DEPTH OF MAIN CASING (NEAREST FOOT): 21

OTHER CASING (IF USED)

CASING	DIAMETER (INCH)	DEPTH (FEET) FROM	TO

SCREEN RECORD

SCREEN TYPE OR OPEN HOLE (INSERT APPROPRIATE CODE BELOW): S T STEEL; B W BRASS OR BRONZE; H O OPEN HOLE; P L PLASTIC; O T OTHER

C 2

SCREEN	DEPTH (NEAREST WHOLE FOOT) FROM	TO
1		
2		
3		

SLOT SIZE 1. ____ 2. ____ 3. ____

DIAMETER OF SCREEN ____ (NEAREST INCH)

GRAVEL PACK: FROM ____ TO ____

IF WELL DRILLED WAS A FLOWING WELL CIRCLE BOX: F

OWC USE ONLY (NOT TO BE FILLED IN BY DRILLER)

TELESCOPE CASING: ____ LOG INDICATOR: ____ OTHER DATA AVAILABLE: ____

C 3

PUMPING TEST

HOURS PUMPED (TO NEAREST HOUR): 1

PUMPING RATE (GALLONS PER MINUTE TO NEAREST GALLON): 12

METHOD USED TO MEASURE PUMPING RATE: Bucket

WATER LEVEL (DISTANCE FROM LAND SURFACE)

BEFORE PUMPING: 30 (NEAREST FOOT)

AFTER PUMPING: 140 (NEAREST FOOT)

TYPE OF PUMP USED (CIRCLE APPROPRIATE BOX) (FOR PUMPING TEST): A AIR; P PISTON; T TURBINE; C CENTRIFUGAL; R ROTARY; O OTHER (SEE REMARKS BELOW); J JET; S SUBMERSIBLE

PUMP INSTALLED

TYPE OF PUMP (WRITE APPROPRIATE LETTER IN BOX – SEE ABOVE): A, C, J, P, R, S, T

DRILLER WILL INSTALL PUMP (CIRCLE APPROPRIATE BOX): YES Y NO N

CAPACITY:

GALLONS PER MINUTE (TO NEAREST GALLON): ____

PUMP HORSE POWER: ____

PUMP COLUMN LENGTH (NEAREST FOOT): ____

CASING HEIGHT (CIRCLE APPROPRIATE BOX AND ENTER CASING HEIGHT): + ABOVE; − BELOW LAND SURFACE: 2 (NEAREST FOOT)

LOCATION OF WELL ON LOT

SHOW PERMANENT STRUCTURE SUCH AS BUILDINGS, SEPTIC TANKS, AND/OR OTHER LAND MARKS AND INDICATE NOT LESS THAN TWO DISTANCES (MEASUREMENTS TO WELL).

N

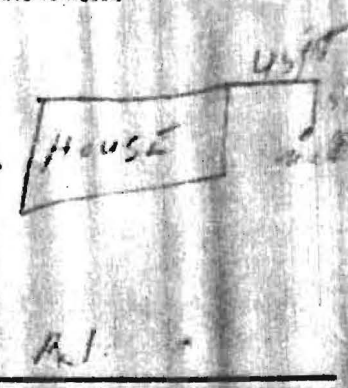

CIRCLE APPROPRIATE BOXES

A — A WELL WAS ABANDONED AND SEALED WHEN THIS WELL WAS COMPLETED

E — ELECTRIC LOG OBTAINED

P — TEST WELL CONVERTED TO PRODUCTION WELL

I HEREBY CERTIFY THAT I HAVE COMPLIED WITH ALL CONDITIONS STATED ON THE ABOVE-CAPTIONED "PERMIT TO DRILL WELL", AND THAT INFORMATION CONTAINED IN THIS REPORT IS TRUE, ACCURATE, AND COMPLETE TO THE BEST OF MY KNOWLEDGE, INFORMATION AND BELIEF.

DRILLERS NAME (PLEASE PRINT): [illegible]

SIGNATURE: [illegible]

HEALTH