MARYLAND DEPARTMENT OF THE ENVIRONM
1800 Washington Blvd., Baltimor

****

WATER WELL ABANDONMENT

****

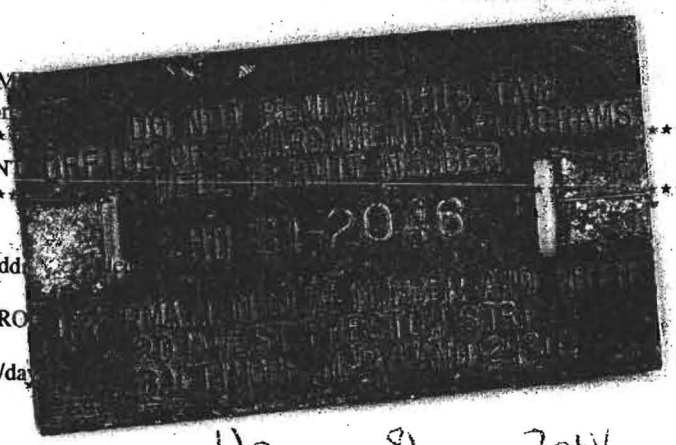

SUBMIT COPIES OF COMPLETED FORM TO:

- COUNTY ENVIRONMENT AGENCY (contact MDE, WMA if add
- WELL OWNER
- MDE, WATER MANAGEMENT ADMINISTRATION, WELL PRO

DATE WELL ABANDONED: 8-10-04 (month/da

* PERMIT NUMBER OF ABANDONED WELL (if any) Ho - 81 - 2046
* PERMIT NUMBER OF REPLACEMENT WELL — —
* PERSON ABANDONING WELL: Michael ISom
* WELL DRILLERS LICENSE NUMBER: 162
  CIRCLE: MWD/MSD/MGD
* OWNER'S NAME: Jim Aglemyer
* WELL LOCATION:
  COUNTY: Howard
  NEAREST TOWN:
  TAX MAP ____ BLOCK ____ PARCEL ____
  SUBDIVISION: Aglemyer Property
  SECTION: ____ LOT: ____
  NEAREST ROAD: Pindell School Rd

SITE LOCATION MAP

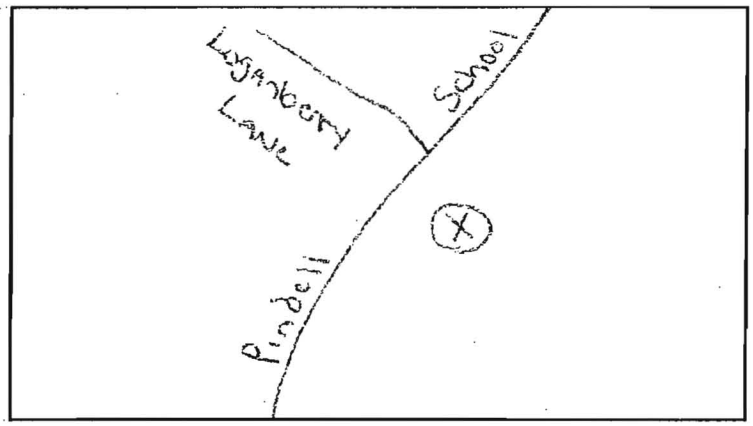

* TYPE OF WELL BEING ABANDONED:
  - X DRILLED
  - ____ JETTED
  - ____ BORED/AUGERED
  - ____ HAND DUG
  - ____ OTHER (specify)

* USE CODE:
  - X DOMESTIC
  - ____ MUNICIPAL/PUBLIC
  - ____ IRRIGATION
  - ____ INDUSTRIAL
  - ____ TEST/OBSERVATION
  - ____ GEOTHERMAL

* TYPE OF CASING:
  - X STEEL
  - ____ PLASTIC
  - ____ CONCRETE
  - ____ OTHER (specify)

* SIZE OF CASING: 6 INCHES IN DIAMETER
* DEPTH OF WELL: 200 FEET DEEP
* WAS ANY CASING REMOVED? ____ YES X NO
  if yes, length removed, in feet: ____
* WAS CASING RIPPED OR PERFORATED? ____ YES X NO

LOG OF SEALING MATERIAL

MATERIAL	FEET	
	FROM	TO
Drill Cuttings	200	40
Portland Cement	40	0

VOLUME OF MATERIAL USED

SIGNATURE-MASTER WELL DRILLER OR SUPERVISING SANITARIAN | 162 LICENSE # | MWD/MSD/MGD CIRCLE ONE | 8-10-04 DATE