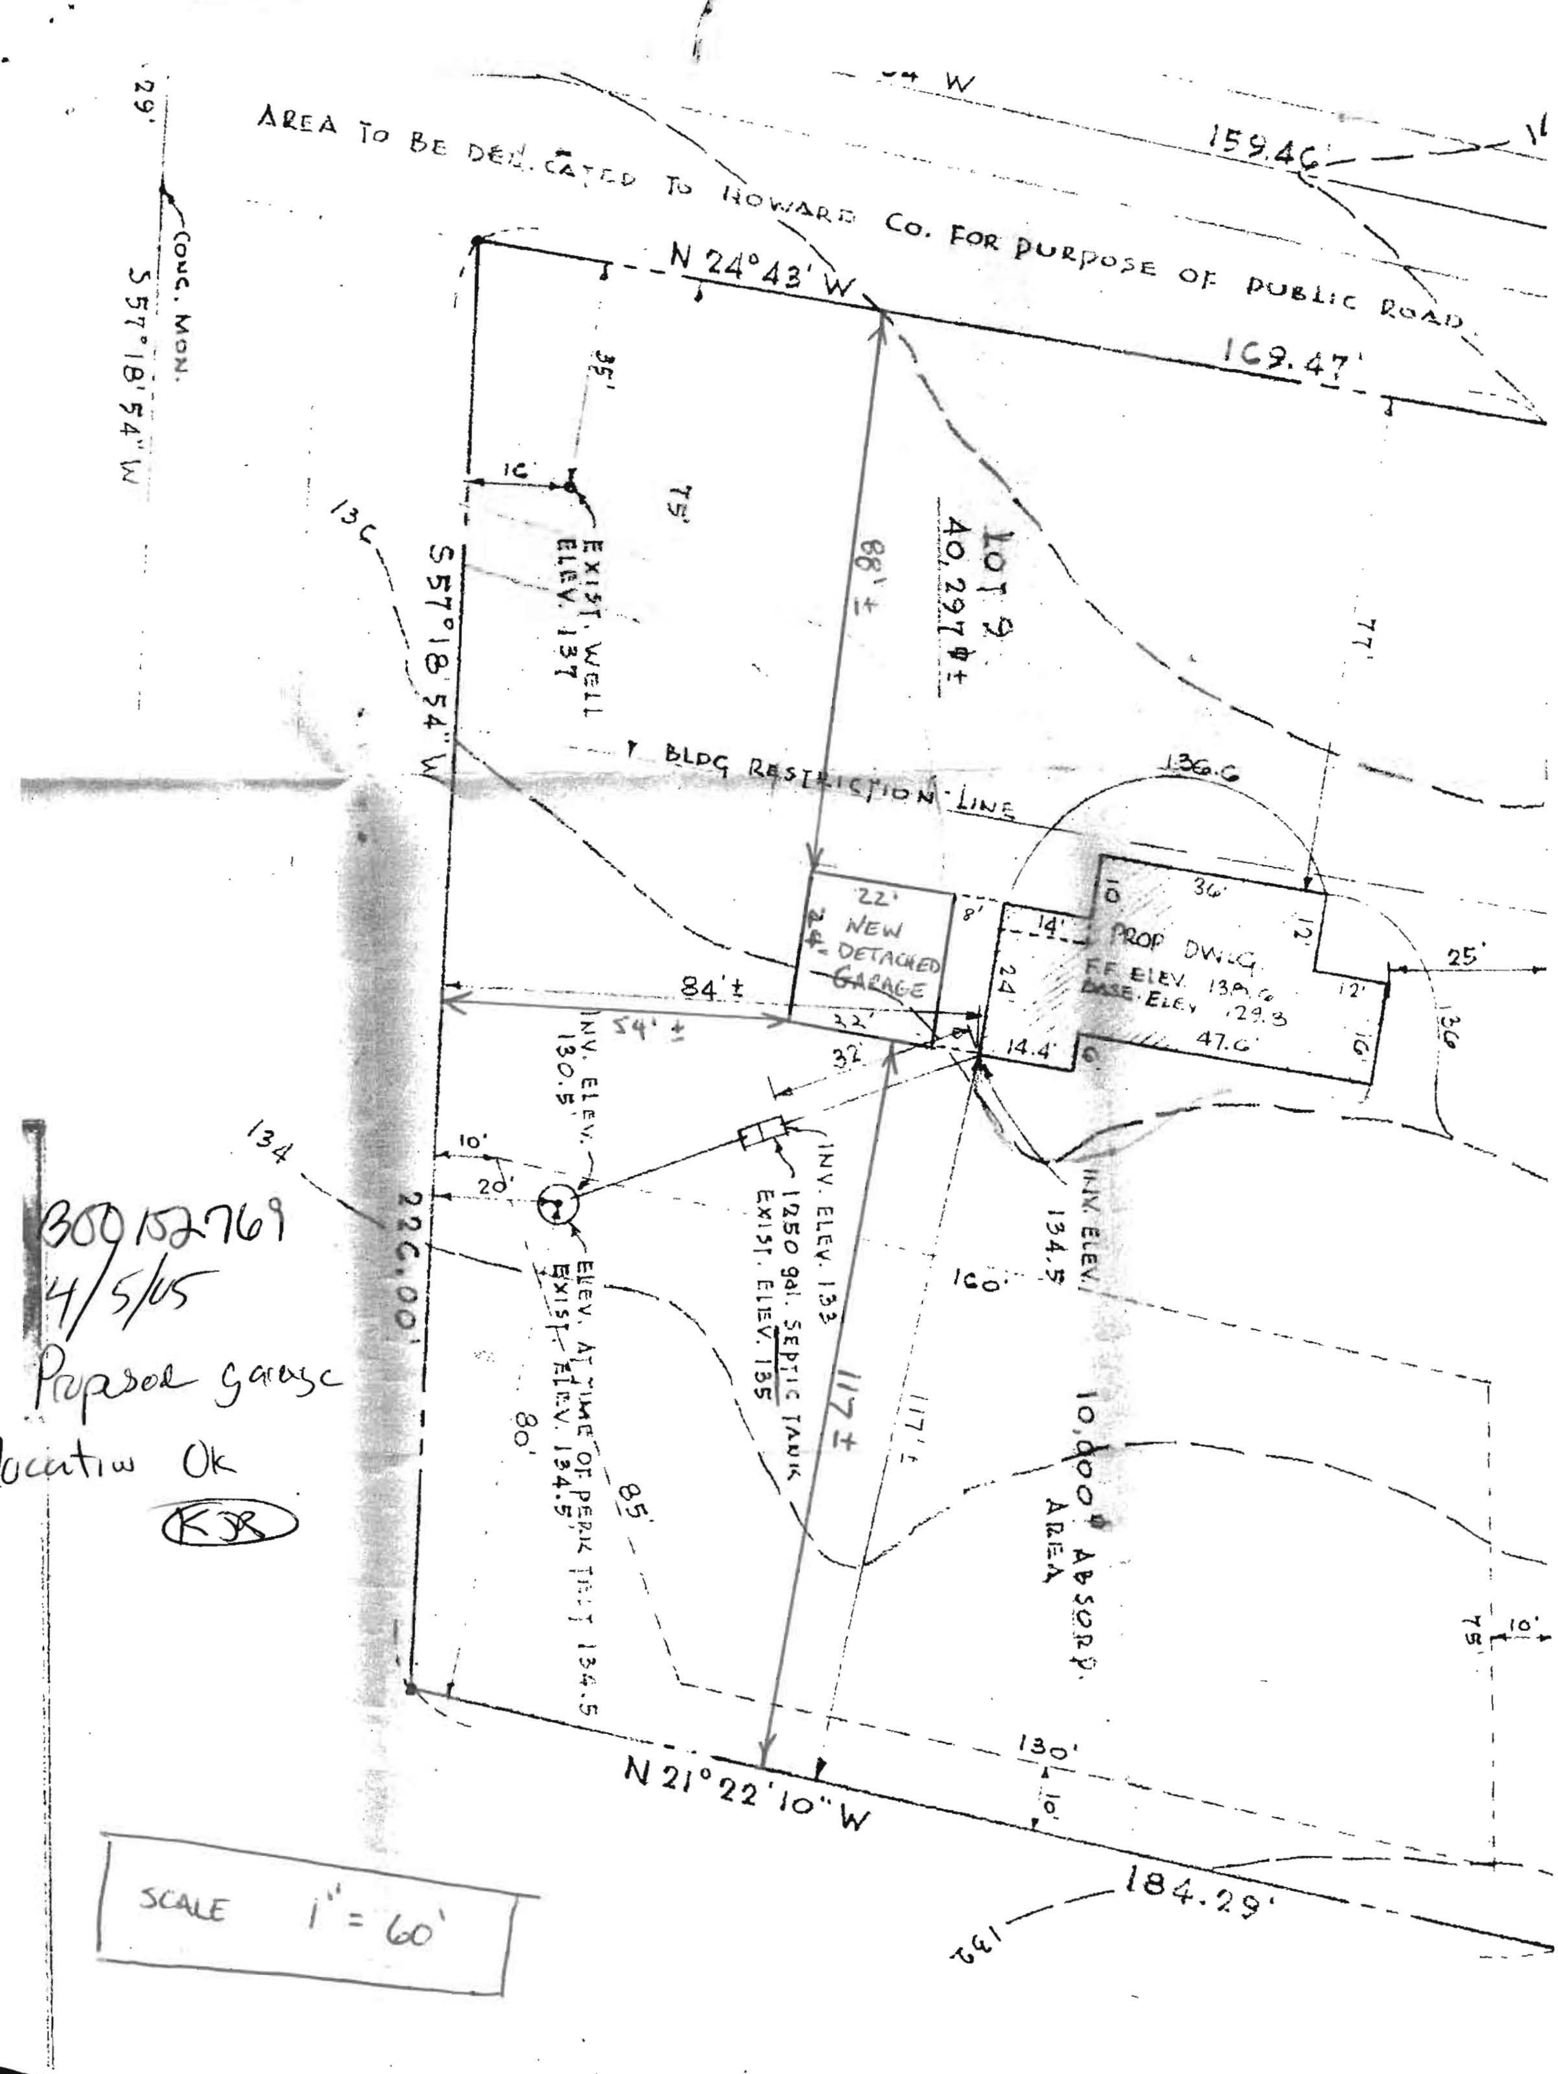
W
159.46'
AREA TO BE DEDICATED TO HOWARD CO. FOR PURPOSE OF PUBLIC ROAD
N 24°43' W
169.47'
29'
CONC. MON.
S 57°18'54" W
35'
75'
16'
EXIST. WELL
ELEV. 137
88' ±
LOT 9
40,297 ☐ ±
77'
13C
S 57°18'54" W
BLDG RESTRICTION LINE
136.6
22'
NEW
2 ±
DETACHED
GARAGE
8'
14'
10
36'
12'
PROP DWLG.
F.F. ELEV. 139.6
BASE. ELEV. 129.3
24'
25'
12'
47.6'
16'
14.4'
6
136
84' ±
54' ±
32'
32'
INV. ELEV. 130.5
10'
20'
134
226.00'
INV. ELEV. 133
1250 gal. SEPTIC TANK
EXIST. ELEV. 135
INV. ELEV. 134.5
160'
ELEV. AT TIME OF PERK TEST 134.5
EXIST. ELEV. 134.5
80'
85'
117' ±
117' ±
10,000 ☐ ABSORP. AREA
75'
10'
130'
10'
N 21°22'10" W
184.29'
132

300152769
4/5/05
Proposed garage
location Ok
KJR

SCALE 1" = 60'

A19869
P24749

RECEIVED
[illegible] COUNTY DEPT. OF
ENVIRONMENTAL HEALTH

2005 MR 24 PM 12:56