BP 0144562
FOR DECK
APPROVED BY FA

NOTE:
EXISTING ELEVATION IS SAME
AS ELEVATION AT TIME OF
PERC. TEST

10/15/03

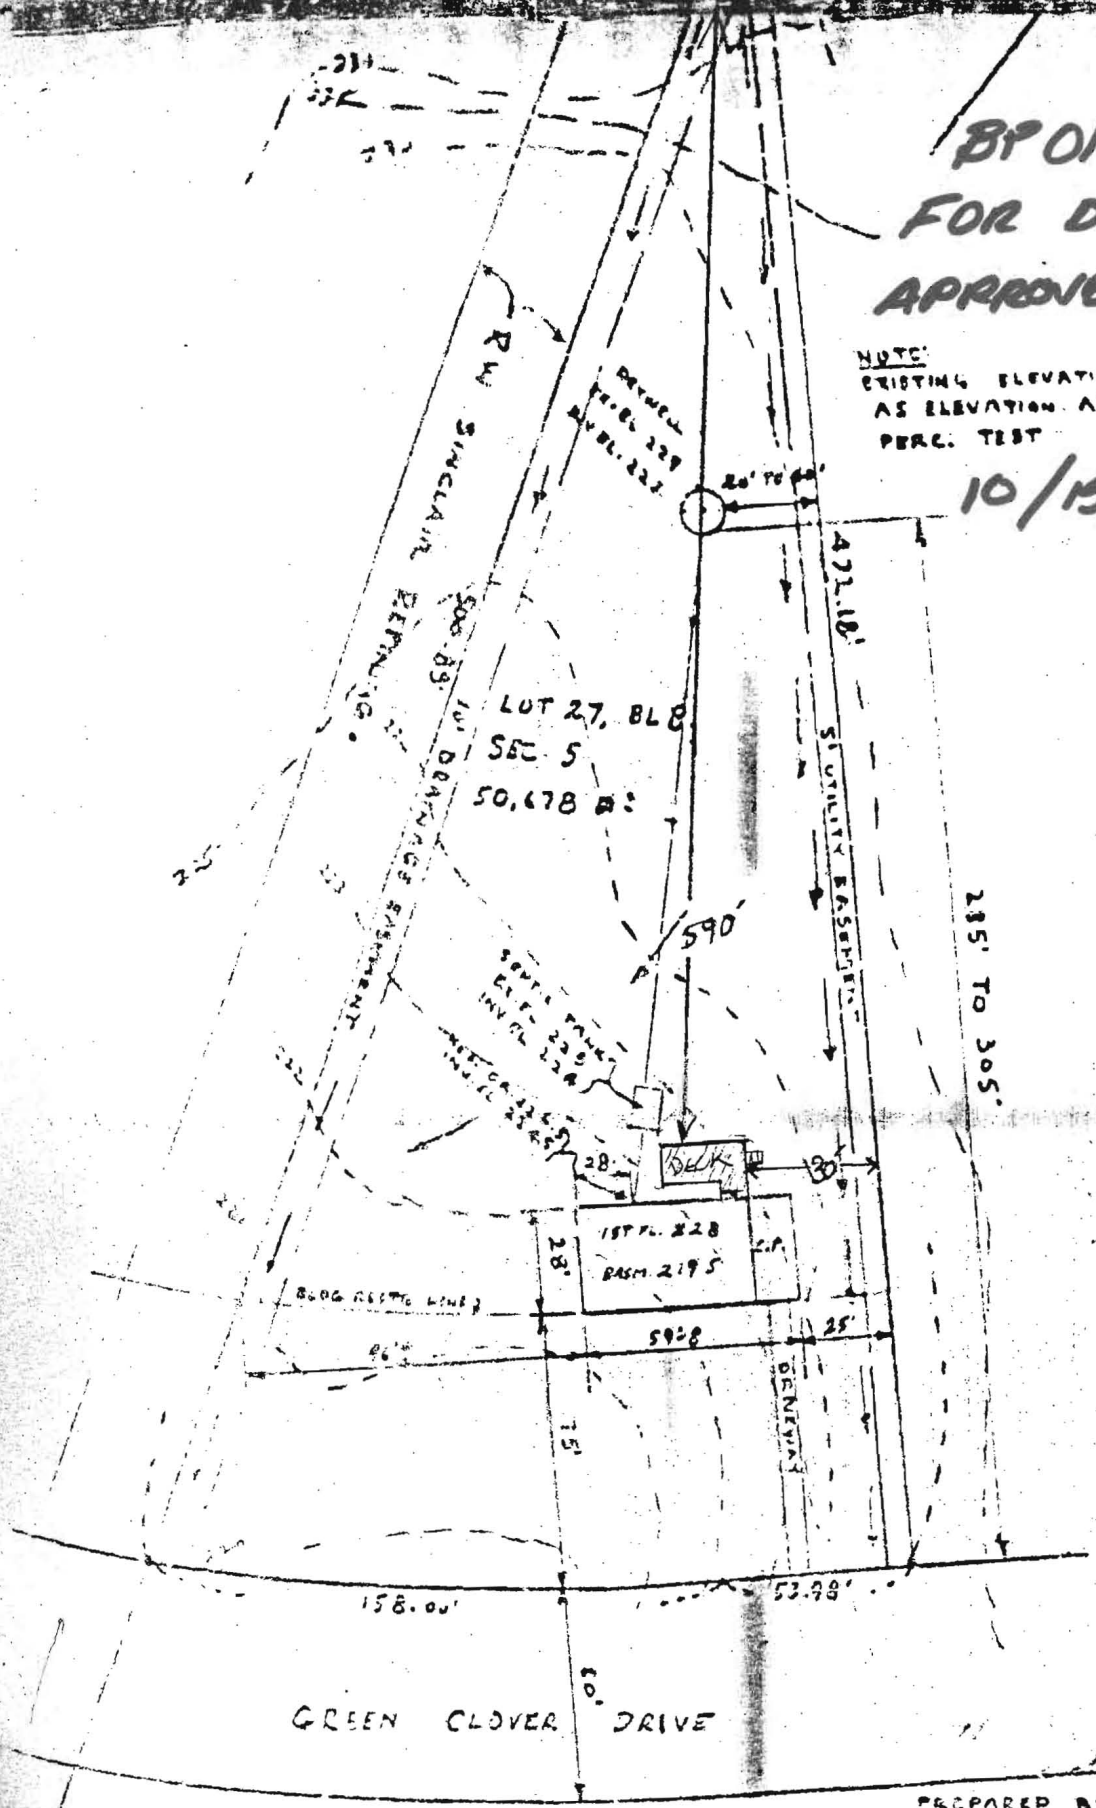

PREPARED BY C.N. BURGESS
3617 LIGON RD.
ELLICOTT CITY, MD.
PHONE: 465-0238
SCALE: 1" = 50'
REV: 7-21-71
7-12-71

10162 GREEN CLOVER RD