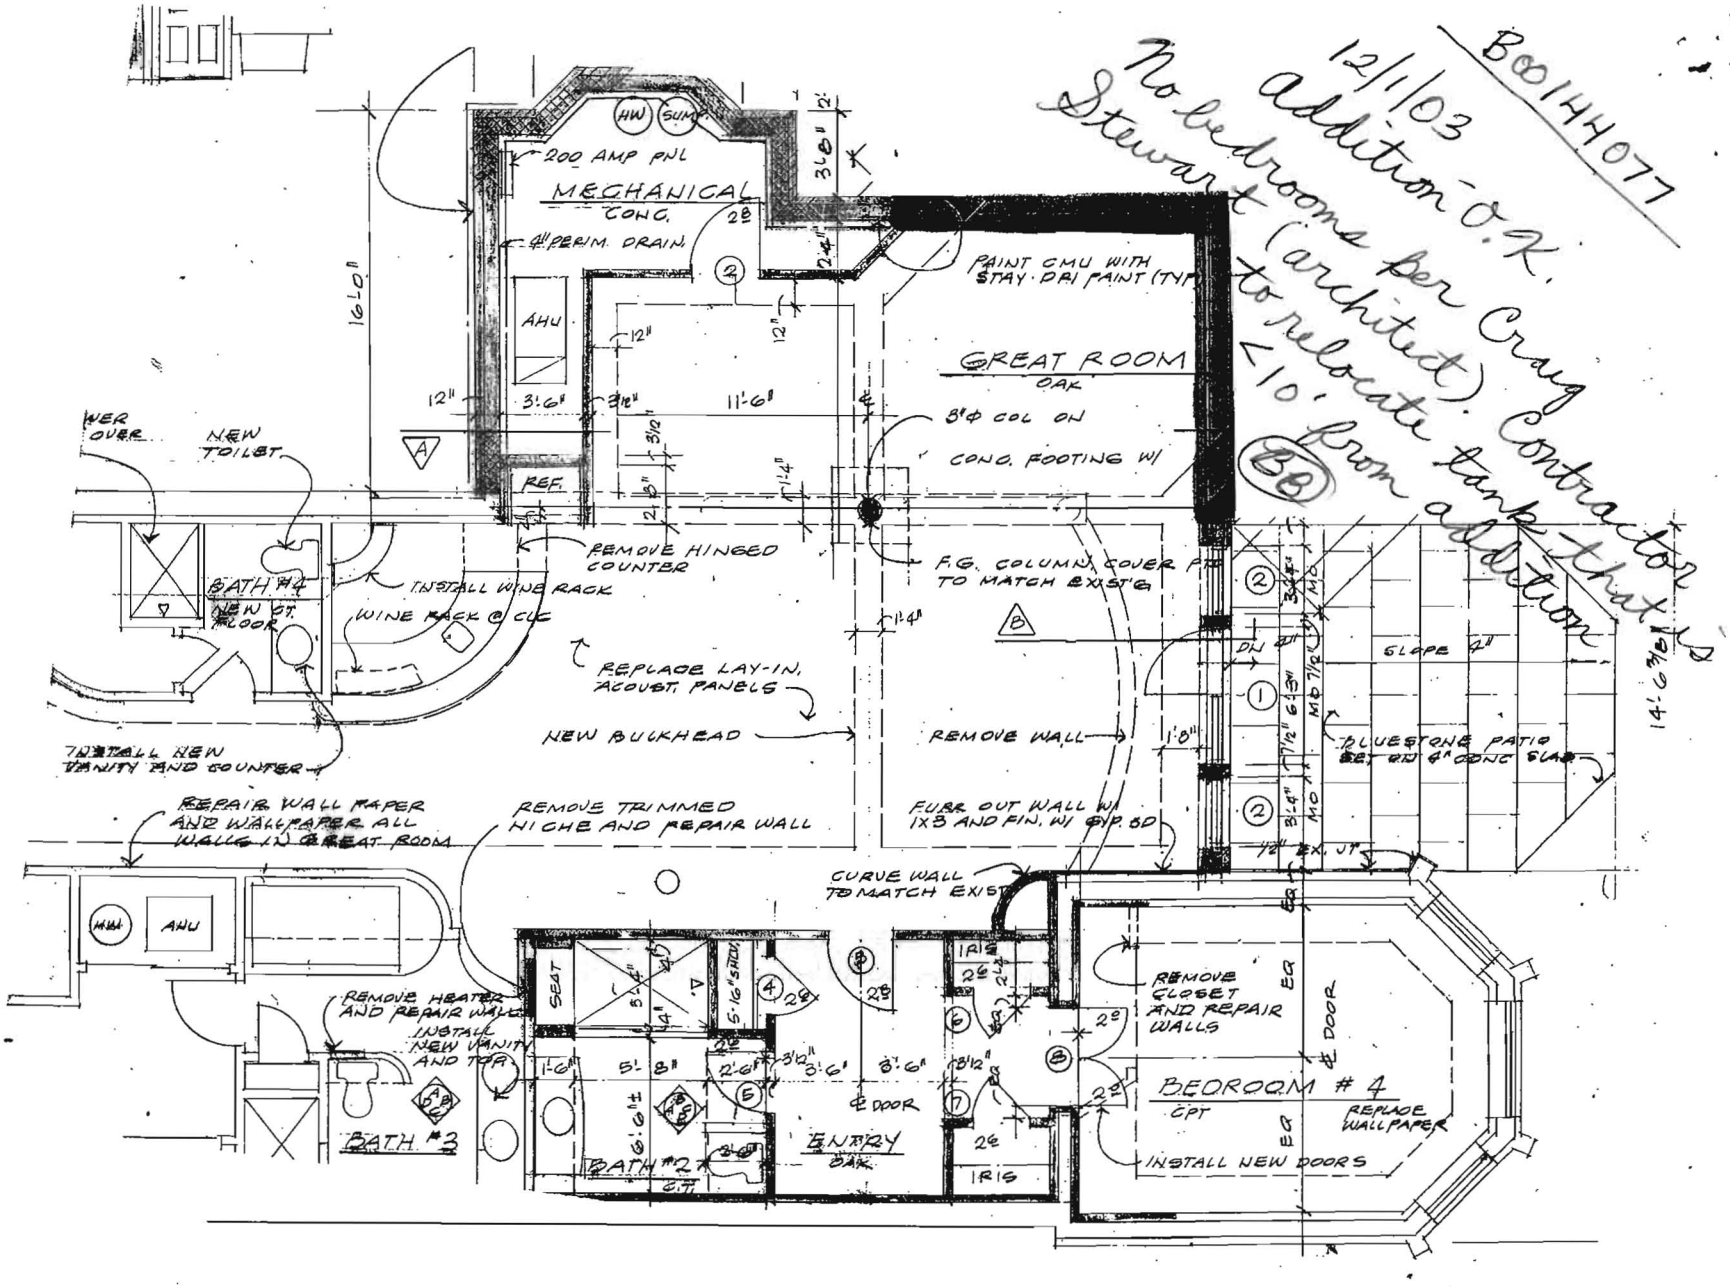

PARTIAL BASEMENT PLAN 1/8" = 1'-0"

LAKHANPAL RESIDENCE

11-4-03