APPLICATION

SEWAGE DISPOSAL TESTING

MARYLAND STATE DEPARTMENT OF HEALTH

A 12929

P

HOWARD COUNTY

ELLICOTT CITY

DISTRICT 3

DATE 7/21/67

Septic Tank - 3 bedroom - 750 gal
4 " - 1000 gal.

Dry Well - 125 sq. ft. absorbent sidewall area per bedroom to begin below inlet pipe. Onlet pipe 3½ ft below orig. grade. Max depth permitted for Dry Well below orig. grade is 6½ ft.

Place Dry Well 12½ ft from front lot line and 90 ft from right sideline as seen when facing from Mt. Albert Rd. Onlet 3 ft. 4 area 3 sets 4 ft.

TO: THE COUNTY HEALTH OFFICER
ELLICOTT CITY, MARYLAND

I, HEREBY, APPLY FOR THE NECESSARY TESTS IN ORDER TO CONSTRUCT (OR RECONSTRUCT) A SEWAGE DISPOSAL SYSTEM.

PROPERTY OWNER Woodmark, Inc.

ADDRESS 231 Chatham Rd., Ellicott City, Md. PHONE HO 5-1345

PROPERTY LOCATION:

SUBDIVISION Woodmark, Inc. LOT NO. 9, Blk. D, Sec. 2

ROAD AND DESCRIPTION Road "A"

OCCUPANT PHONE

PERSON TO CONSTRUCT SYSTEM

ADDRESS PHONE

SIZE OF LOT 190' x 505' x 88' x 285' x 283' TYPE BLDG. 3 or 4 (NUMBER OF BEDROOMS)

IF NOT SINGLE RESIDENCE DESCRIBE

SIGNATURE OF APPLICANT /s/ Mark A. Wakefield

APPROVED BY FOR Dry Well (KIND OF SYSTEM) DATE 3-4-68

REJECTED BY FOR (KIND OF SYSTEM) DATE

HOLD PENDING FURTHER TESTS DATE

REASONS FOR REJECTION OR HOLDING

THIS IS NOT A PERMIT

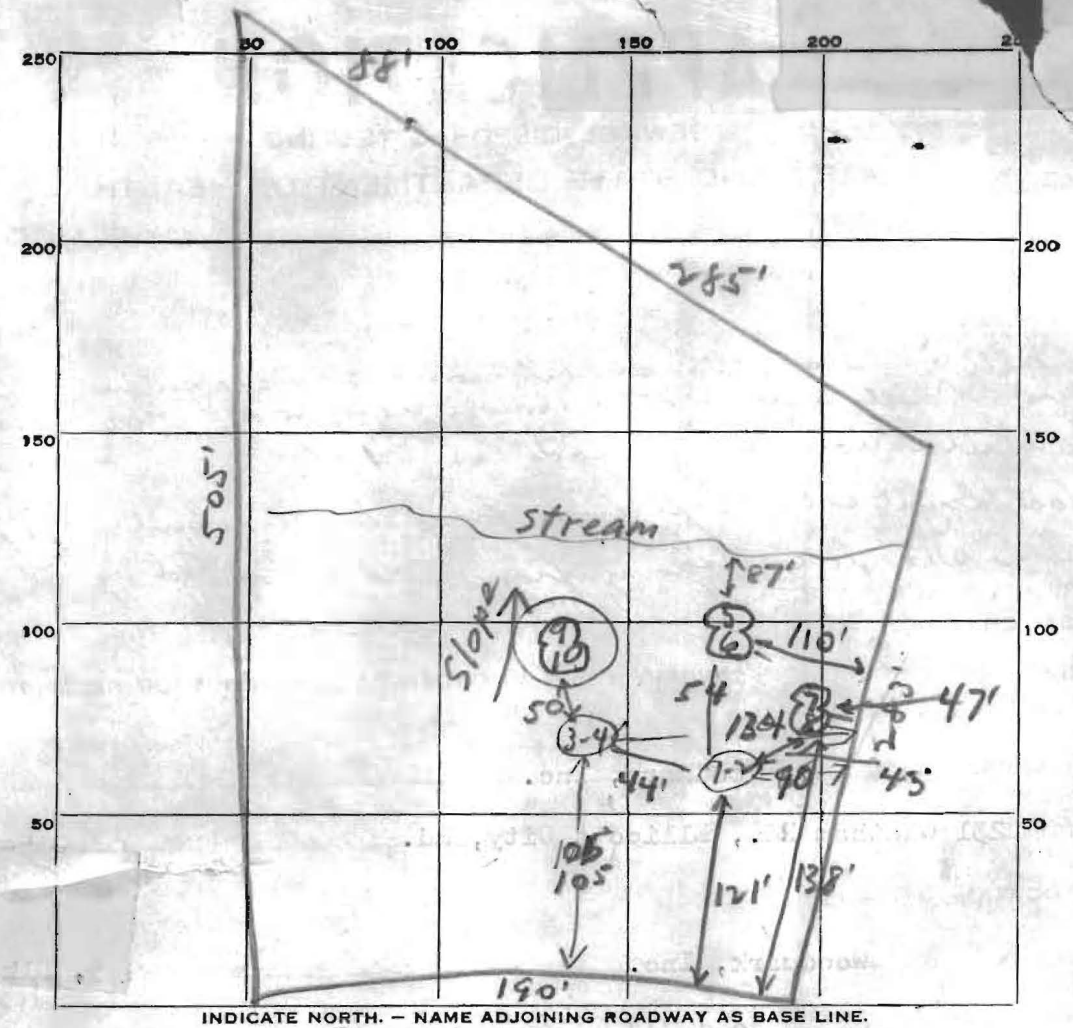

INDICATE NORTH. — NAME ADJOINING ROADWAY AS BASE LINE.

Road A

DATE	TEST NO.	DEPTH	PRE-WET START	PRE-WET STOP	TEST - 1" DROP START	TEST - 1" DROP STOP	TIME
7/13/67	1	4 1/2'	11:20	11:21	11:21	11:23	2 min
	2	10'	11:23	11:26	11:26	11:30	4 min
	3	4 1/2'	11:25	11:26	11:26	11:27	1 min
	4	10'	11:27	11:30	11:30	11:34	4 min
	5	4'	11:35	11:36	11:36	11:37	1 min
	6	9'	11:36	11:38	11:38	11:43	5 min
	7	5'	11:45	11:48	11:48	11:58	10 min
	8	10 1/2'	11:45	12:02	12:02	12:32	30 min
	9	4'	12:22	12:23	12:23	12:25	2 min
	10	11 1/2'	12:22	no perc - probably	on water table		

SOIL AUGER FINDING

TESTED BY DWM + JHK

REMARKS check for water in hole 5-6 - water at 12'
pit (1-2) orig system - 5-6 for shallow repair

9D