


and so that
er

DEPARTMENT OF ENVIRONMENT

48" WHITE OAK TREE

PARCEL 31

L.7565 / F. 653
2.40 AC

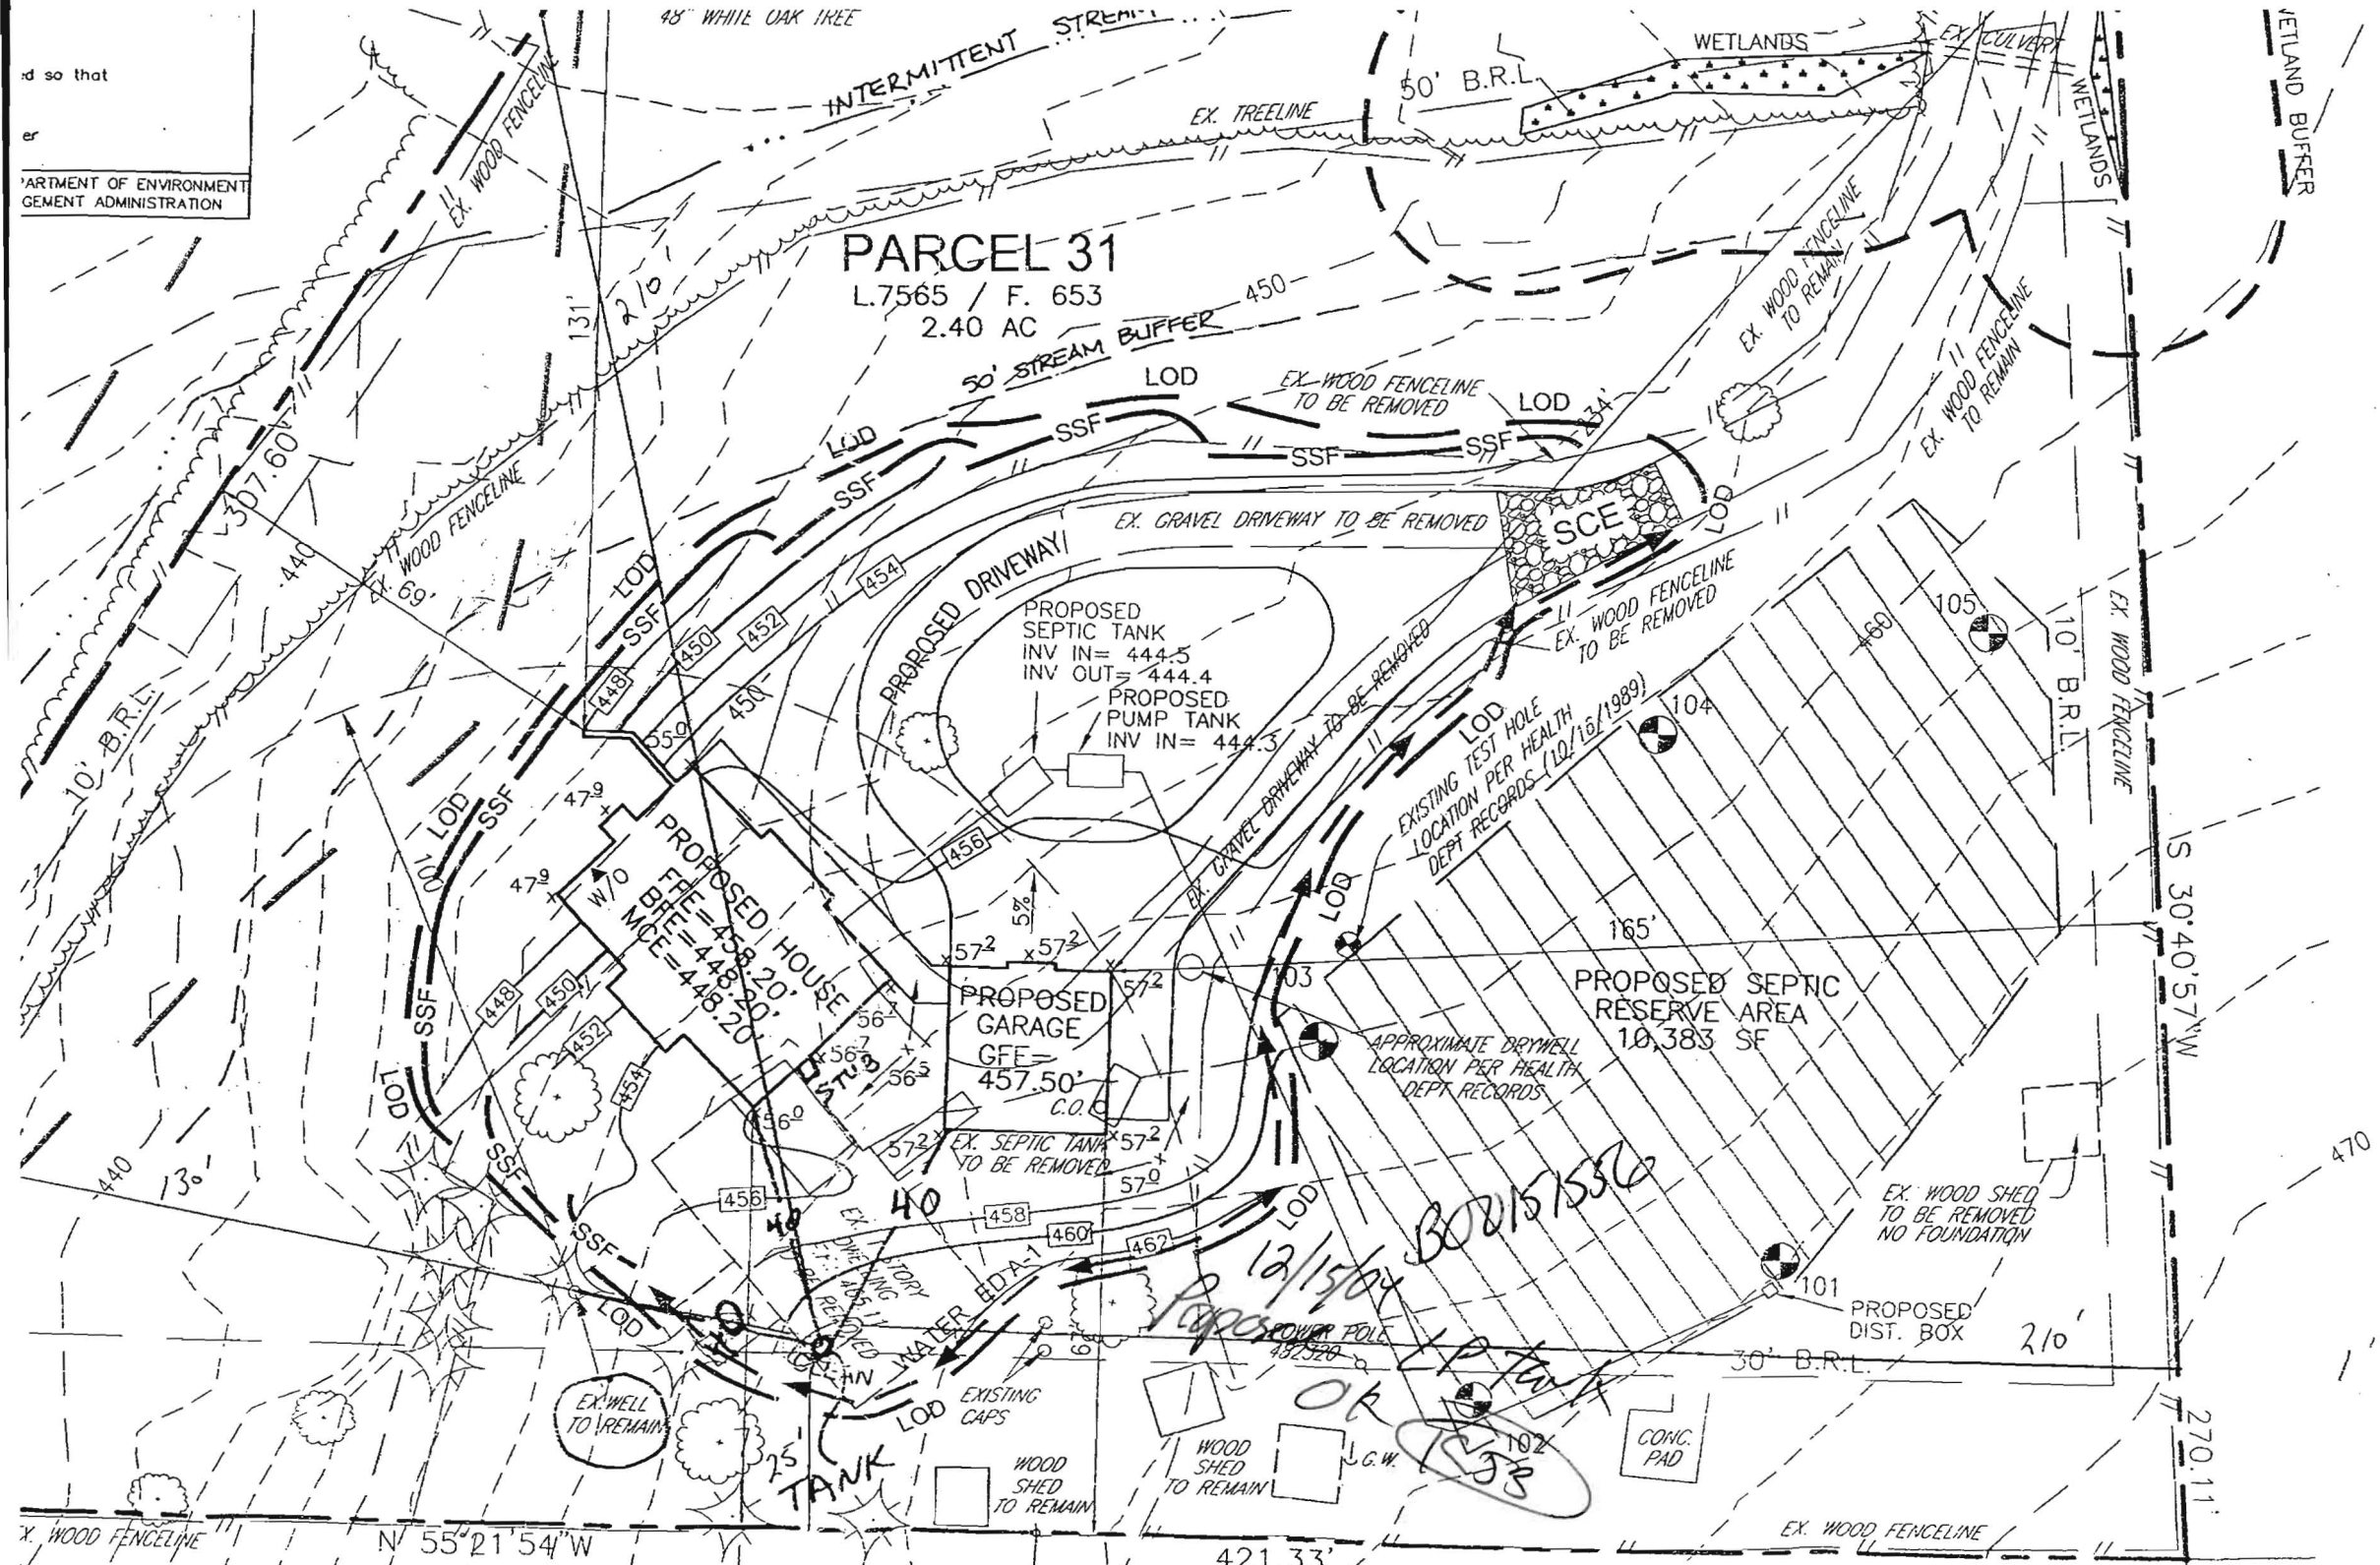

1" = 30'