404 — SEQUENCE NO. (OEP USE ONLY)

(THIS NUMBER IS TO BE PUNCHED IN COLS. 3-6 ON ALL CARDS)

STATE OF MARYLAND
WELL COMPLETION REPORT,
FILL IN THIS FORM COMPLETELY
PLEASE PRINT OR TYPE

THIS REPORT MUST BE SUBMITTED WITHIN 45 DAYS AFTER WELL IS COMPLETED.

COUNTY NUMBER A23436

DATE Received

DATE WELL COMPLETED 08/24/93

Depth of Well 240 (TO NEAREST FOOT)

PERMIT NO. FROM "PERMIT TO DRILL WELL" HO-81-0238

OWNER Northern Mod. Homes

STREET OR RFD Last name Browns Farm Road First name TOWN Woodstock

SUBDIVISION Valley Anne Estates SECTION 2 LOT 6

WELL LOG
Not required for driven wells

STATE THE KIND OF FORMATIONS PENETRATED, THEIR COLOR, DEPTH, THICKNESS AND IF WATER BEARING

DESCRIPTION (Use additional sheets if needed)	FEET FROM	FEET TO	Check if water bearing
Top Soil	0	2	
Brown shale	2	6	
Gray Sandstone	6	35	
Tan Sandstone	35	40	✓
Blue Mica	40	187	
White Sandstone	187	190	✓
Blue Mica	190	240	

GROUTING RECORD
WELL HAS BEEN GROUTED (Circle Appropriate Box) YES (Y) NO (N)
TYPE OF GROUTING MATERIAL
CEMENT CM BENTONITE CLAY BC
NO. OF BAGS 5 NO. OF POUNDS 500
GALLONS OF WATER 30
DEPTH OF GROUT SEAL (to nearest foot)
from 0 ft. to 18 ft. (enter 0 if from surface)

CASING RECORD
casing types — Insert appropriate code below
ST STEEL CO CONCRETE PL PLASTIC OT OTHER

MAIN CASING TYPE	Nominal diameter top (main) casing (nearest inch)	Total depth of main casing (nearest foot)
ST	6	21

OTHER CASING (If used)

EACH CASING	diameter inch	depth (feet) from	depth (feet) to

SCREEN RECORD
screen type or open hole — Insert appropriate code below
ST STEEL BR BRASS BRONZE HO OPEN HOLE PL PLASTIC OT OTHER

C 2

EACH SCREEN	DEPTH (nearest ft.)	
1	40	190
2		
3		

SLOT SIZE 1 ____ 2 ____ 3 ____
DIAMETER OF SCREEN ____ (NEAREST INCH)

from ____ to ____
GRAVEL PACK ____
IF WELL DRILLED WAS FLOWING WELL INSERT F IN BOX 68

C 3

PUMPING TEST
HOURS PUMPED (nearest hour) 3
PUMPING RATE (gal. per min. to nearest gal.) 10
METHOD USED TO MEASURE PUMPING RATE BUCKET
WATER LEVEL (distance from land surface)
BEFORE PUMPING 48
WHEN PUMPING 191

TYPE OF PUMP USED (for test)
A air P piston T turbine
C centrifugal R rotary O other (describe below)
J jet S submersible

PUMP INSTALLED
DRILLER WILL INSTALL PUMP (CIRCLE) (YES or NO) YES (NO)
IF DRILLER INSTALLS PUMP, THIS SECTION MUST BE COMPLETED FOR ALL WELLS EXCEPT HOME USE
TYPE OF PUMP INSTALLED PLACE (A,C,J,P,R,S,T,O) IN BOX - SEE ABOVE:
CAPACITY: GALLONS PER MINUTE (to nearest gallon)
PUMP HORSE POWER
PUMP COLUMN LENGTH (nearest ft.)
CASING HEIGHT (circle appropriate box and enter casing height)
+ above / − below LAND SURFACE 22 (nearest foot)

CIRCLE APPROPRIATE LETTER
A A WELL WAS ABANDONED AND SEALED WHEN THIS WELL WAS COMPLETED
E ELECTRIC LOG OBTAINED
P TEST WELL CONVERTED TO PRODUCTION WELL

I HEREBY CERTIFY THAT THIS WELL HAS BEEN CONSTRUCTED IN ACCORDANCE WITH COMAR 10.17.13 "WELL CONSTRUCTION" AND IN CONFORMANCE WITH ALL CONDITIONS STATED IN THE ABOVE CAPTIONED PERMIT, AND THAT THE INFORMATION PRESENTED HEREIN IS ACCURATE AND COMPLETE TO THE BEST OF MY KNOWLEDGE.

DRILLERS IDENT. NO. 40
DRILLERS SIGNATURE (MUST MATCH SIGNATURE ON APPLICATION) Gene L. Gaildraup
SITE SUPERVISOR (sign. of driller or journeyman responsible for sitework if different from permittee) Blue Hen

OEP USE ONLY
(NOT TO BE FILLED IN BY DRILLER)
T (E.R.O.S.) WQ
TELESCOPE CASING LOG INDICATOR OTHER DATA

LOCATION OF WELL ON LOT
SHOW PERMANENT STRUCTURE SUCH AS BUILDING, SEPTIC TANKS, AND/OR LANDMARKS AND INDICATE NOT LESS THAN TWO DISTANCES (MEASUREMENTS TO WELL)

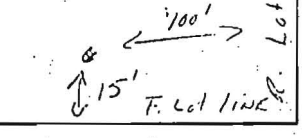

HEALTH

Lot 8
31,000±
Lot 7
23,512±
Lot 6
23,531±
Lot 5
28,726±
A ROAD
L=504.04'
L=472.20'
104.00'
154.00'
50'
50'
50'
50'
S82°38'39"E 225.45'
S82°38'39"E 238.66'
S66°11'50"W
S02°53"W
363.81'
298.21'
210'
210'
120'
120'
135'
102.16'
104.96'
309.41'
N03°21'20"W
Well Sudok
Well
Copy of final plat