A 21594

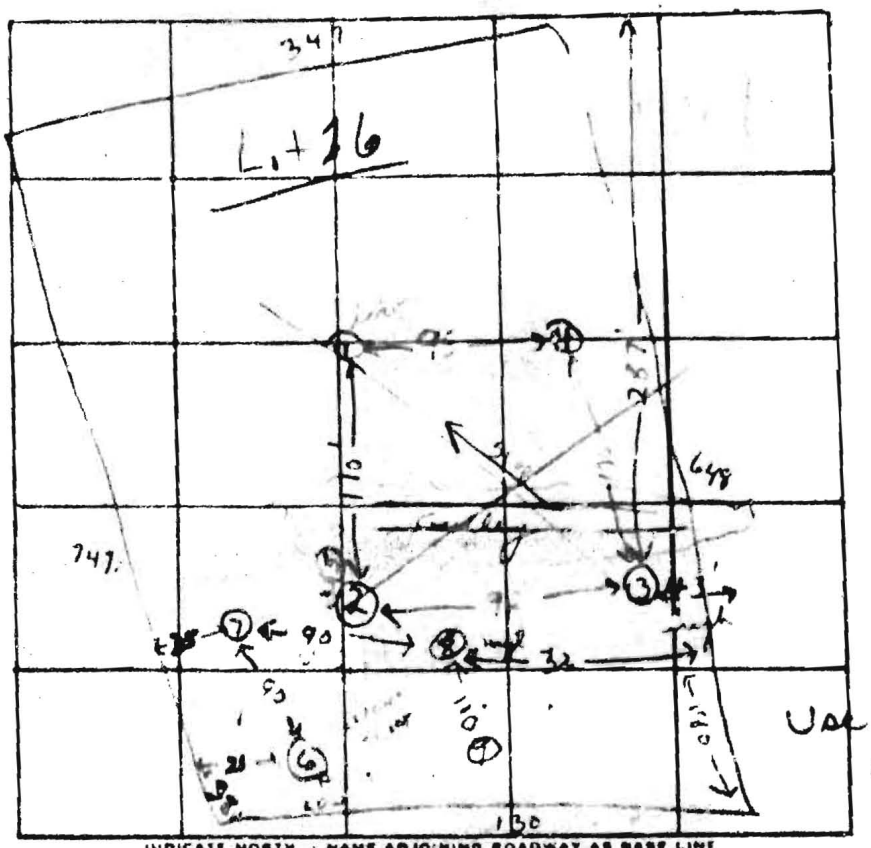

Paul Yoder

INDICATE NORTH · NAME ADJOINING ROADWAY AS BASE LINE

R/W

DATE	TEST NO	DEPTH	PRE WET START	PRE WET STOP	TEST 1" DROP START	TEST 1" DROP STOP	TIME
6/3/75	1	4'	11:40	11:45	11:45	11:50	
	1A	1½'	11:40	11:45	11:45	11:51	
	2	5'	11:43	1/4 drop in 20			12:03
	2A	12'	11:43	11:48	11:48	12:00	12
	3	5'	11:45	3/4 drop in 25			12:13
	3A	12'	11:45	11:51	11:51	12:15	24
	4	7'	W.L.	+7', clay, clay,			
	4	12'	dry, clay,				
6/4/75	6	13'	10:07			10:12	5
	6A	4'	10:07	10:12	10:12	10:22	10
	7	[illegible]	10:25	10:35	10:35	10:35	10
	7A	5'	10:25	10:29	10:29	10:34	5
	8	4½'	10:28			10:32	4
	8A	[illegible]	10:28	10:33	10:33	10:48	15
	9	[illegible]					

REMARKS

TYPE OF SOIL

TESTED BY [illegible] ALSO PRESENT: