filed 2.1116

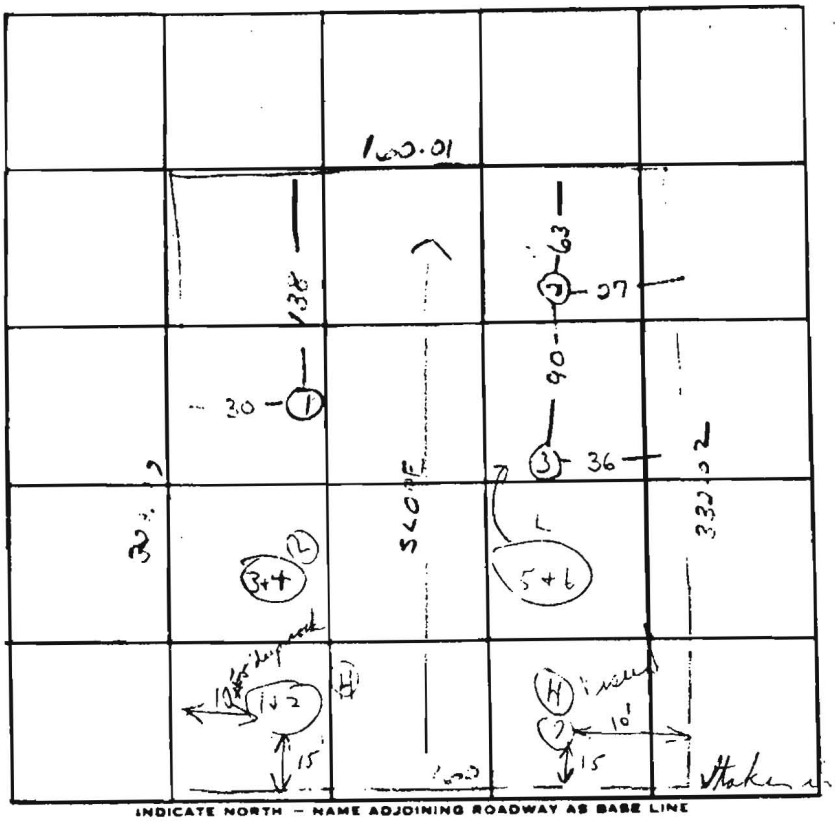

INDICATE NORTH — NAME ADJOINING ROADWAY AS BASE LINE

Hartland Rd.

DATE	TEST NO.	DEPTH	PRE-WET START	PRE-WET STOP	TEST - 1" DROP START	TEST - 1" DROP STOP	TIME
11/4/74	1	9'	11:21	—	—	11:51	not
	2	8½'	11:43	1ST	INCH	[illegible]	NE
	3	11½'	[illegible]	[illegible]	[illegible]		
11/3/75	1	6'	11:35	11:48	11:48	12:14	28m
	2	12'	11:52 ~~11:49~~	11:55	11:55	11:59	4m
	3	5'	11:37	11:49	11:49	12:09	20m
	4	12'	11:47	11:49	11:49	11:56	7m
	5	5'	11:39	11:40	11:40	11:42	2m
	6	12'	11:41	11:45	11:45	11:52	7m
	7	12'	[illegible]	[illegible]	[illegible]	[illegible]	

Note: 1'-2' difference in elevation in entire lot where tested

REMARKS: Estate holes by owner - measured off stake off 2 months

TYPE OF SOIL: [illegible] 1" [illegible]

TESTED BY: R.T. [illegible] ALSO PRESENT: [illegible] Edwards