WR-W-4
4-66

State Office Building
ANNAPOLIS, MARYLAND 21401

RECEIVED
STATE OF MARYLAND
DEPARTMENT OF
WATER RESOURCES
10:11

THIS REPORT MUST BE SUBMITTED WITHIN 30 DAYS AFTER COMPLETION OF THE WELL

WELL COMPLETION REPORT A09002

WELL DESCRIPTION Lt 6B Sec 5

WELL LOG State the kind of formations penetrated, their color, their depth, their thickness, and if water-bearing	FEET from ___ to ___	CASING AND SCREEN RECORD State the kind and size and position of casing, liner, shoe, screen, and other accessories (if no casing used, give diameter of well).	DIAM. (inches)	FEET from ___ to ___
		Sand		
		45 ft casing		
		Gray Rock		
rock for 42 ft.		well 72 ft		

Permit Number 70 68 W 8
Owner James Bondek
Address ~~Burnt Wood~~
Subdivision Burnt Wood
Section Sect B Lot 6

PUMPING TEST
Hours Pumped 1
Type of Pump Used Bayler
Pumping Rate
Gallons per Minute 6

WATER LEVEL
(Distance from land surface to water)
Before Pumping 45 Ft.
When Pumping 60 Ft.

APPEARANCE OF WATER
Clear Partly Cloudy
Taste None
Odor None

Height of Casing Above Land Surface 2 Ft.

PUMP INSTALLED
Type
Capacity
Gallons per Minute
Gallons per Hour
Pump Column Length Ft.

LOCATION OF WELL ON LOT
Show permanent structures such as building(s), septic tank, and/or other landmarks and indicate not less than 2 distances (measurements) to well.

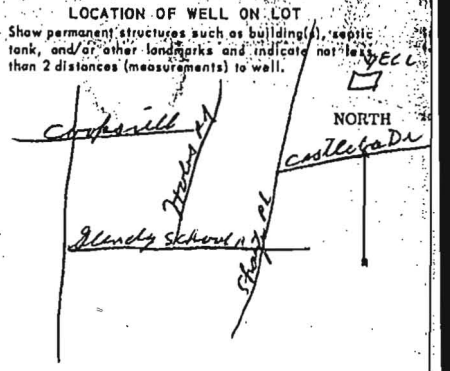

DATE WELL WAS COMPLETED
July 31 1967

I hereby affirm that this report contains no willful misrepresentations or falsifications and that information given in this report is true, accurate and complete to the best of my knowledge and belief.

Denny Brown, Well Driller

Well Driller License No.: 113

HEALTH