THIS INDICATES A
EXISTS SEWAGE EASEMENT
OF 10,000 SQ. FT. OR MORE
AS PROVIDED BY THE MARYLAND
STATE DEPARTMENT
OF HEALTH AND MENTAL HYGIENE.
FOR INDIVIDUAL DISPOSAL IMPROVEMENTS
OF ANY KIND IN THIS AREA ARE
RESTRICTED UNTIL PUBLIC SEWAGE
IS AVAILABLE AND SERVICING ANY
RESIDENTIAL STRUCTURES CONSTRUCTED
ON THIS SITE. THIS EASEMENT SHALL
BECOME NULL AND VOID UPON CONNECTION
TO A PUBLIC SEWAGE SYSTEM.

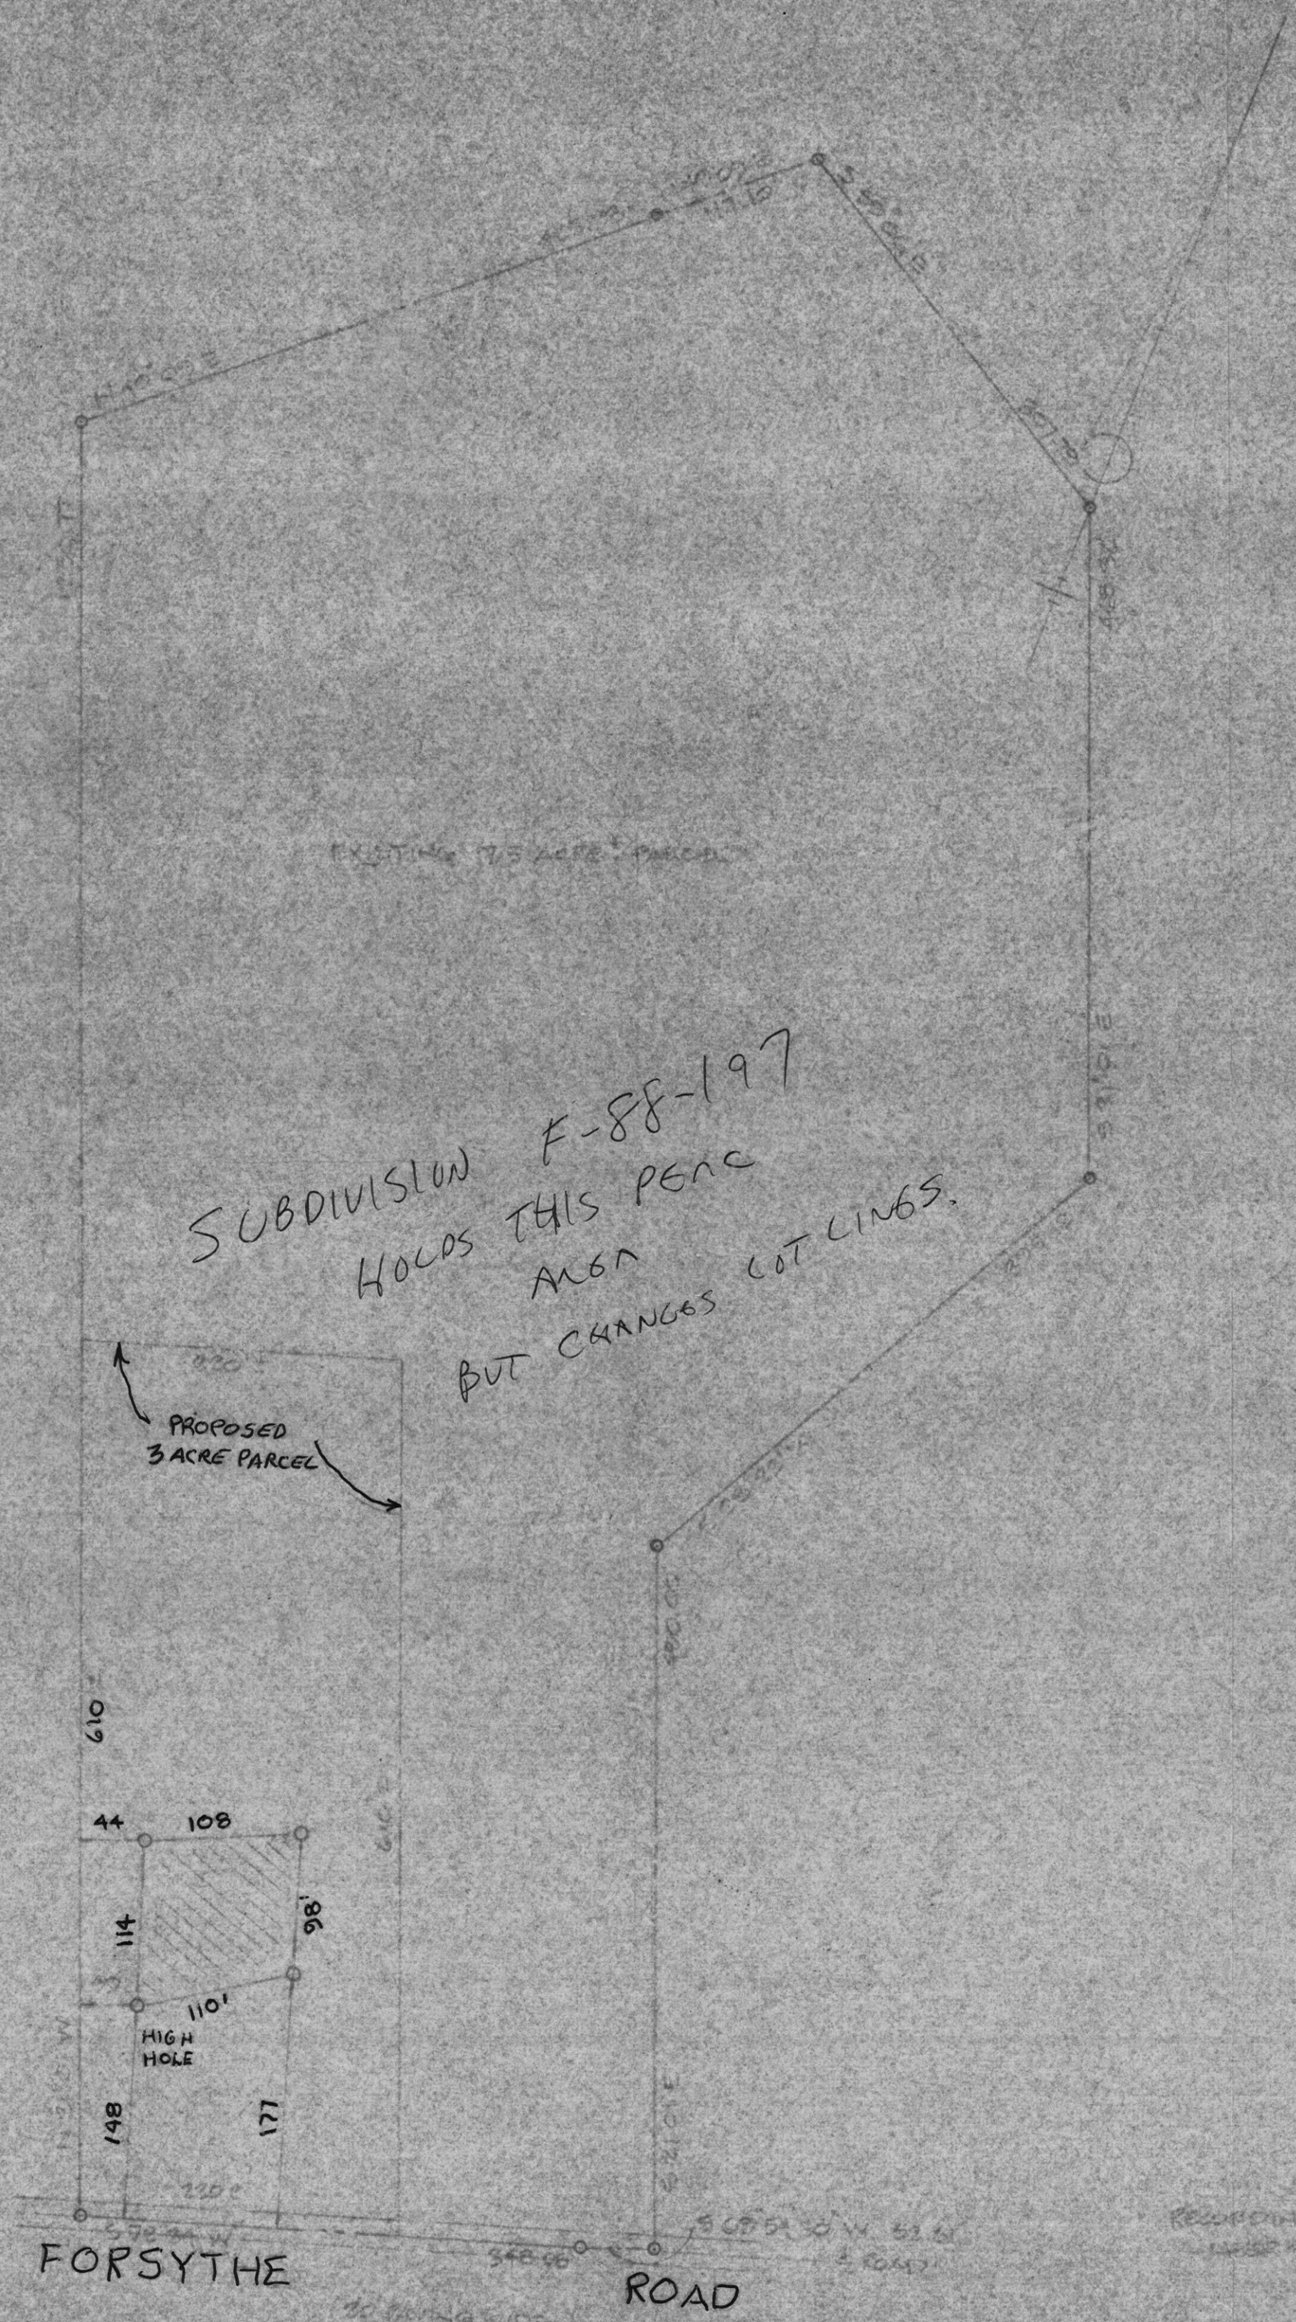

APPROVED: REG. PUBLIC WATER
AND PRIVATE SEWER SYSTEMS
HOWARD COUNTY HEALTH DEPARTMENT

12-5-79
DATE

STATE OF MARYLAND
JOHN LAUGHLIN
No. 7317
REGISTERED
PROFESSIONAL ENGINEER

12-3-79

SIGNED

NOTE

1. PERCOLATION TEST HOLES SHOWN HEREON VS. OTHER PERC HOLES LOCATED.
2. THE LOT (PARCEL) SHOWN HEREON COMPLIES WITH MINIMUM DIMENSIONS AND LOT AREA AS PERMITTED BY THE MARYLAND STATE DEPARTMENT OF HEALTH AND MENTAL HYGIENE.

ENGINEER
JOHN LAUGHLIN, P.E.
[illegible]
ELLICOTT CITY, MARYLAND 21043
301 [illegible]

lot A on 2

PERC TEST CERTIFICATION PLAT

SCALE: 1" = 100'	APPROVED BY:	DRAWN BY: [illegible]
DATE: 11-30-79		REVISED
LAWRENCE N. RICKER PROPERTY PARCEL 63 BLOCK 1 MAP 9		
		DRAWING NUMBER 79150

18X24 PRINTED ON NO. 1000H CLEARPRINT