

# APPLICATION

## FOR PERCOLATION TESTING AND SITE EVALUATION

TEST DATE(S) \_\_\_\_\_ TEST TIME \_\_\_\_\_ AP A 519038  
AGENCY REVIEW: \_\_\_\_\_ DATE 7/2/2003

DO NOT WRITE ABOVE THIS LINE

I HEREBY APPLY FOR THE NECESSARY TESTING/EVALUATION PRIOR TO ISSUANCE OF SEWAGE DISPOSAL SYSTEM PERMIT(S) TO:

CHECK AS NEEDED:

- CONSTRUCT NEW SEPTIC SYSTEM(S) "SAND MOUND"
- REPAIR/ADD TO AN EXISTING SEPTIC SYSTEM
- REPLACE AN EXISTING SEPTIC SYSTEM

CHECK AS NEEDED:

- NEW STRUCTURE(S)
- ADDITION TO AN EXISTING STRUCTURE
- REPLACE AN EXISTING STRUCTURE

CHECK ONE:

- CREATE NEW LOT(S)
- BUILD ON AN EXISTING LOT IN A SUBDIVISION
- BUILD ON AN EXISTING PARCEL OF RECORD

IS THE PROPERTY WITHIN 2500' OF ANY RESERVOIR?

- YES
- NO

THE TYPE OF STRUCTURE IS:

- RESIDENTIAL WITH 4 PROPOSED BEDROOMS IN THE COMPLETED STRUCTURE (NOTE UNKNOWN IF APPROPRIATE)
- COMMERCIAL (PROVIDE DETAIL OF NUMBERS AND TYPES OF EMPLOYEES/ CUSTOMERS ON ACCOMPANYING PLAN)
- INSTITUTIONAL/GOVERNMENT (PROVIDE DETAIL OF NUMBERS AND TYPES OF EMPLOYEES/USERS ON ACCOMPANYING PLAN)

PROPERTY OWNER(S) CORRECTION HOMES

DAYTIME PHONE 910/792/2565 CELL \_\_\_\_\_ FAX \_\_\_\_\_

MAILING ADDRESS 9695 Norfolk Ave Laurel MD 20723  
STREET CITY/TOWN STATE ZIP

APPLICANT SAMUE

DAYTIME PHONE \_\_\_\_\_ CELL \_\_\_\_\_ FAX \_\_\_\_\_

MAILING ADDRESS \_\_\_\_\_  
STREET CITY/TOWN STATE ZIP

APPLICANT'S ROLE: DEVELOPER  BUILDER BUYER RELATIVE/FRIEND REALTOR CONSULTANT

PROPERTY LOCATION  
SUBDIVISION/PROPERTY NAME Rt 99/Wharfedale 2109 LOT NO. 19

PROPERTY ADDRESS \_\_\_\_\_  
STREET TOWN/POST OFFICE




TAX MAP PAGE(S) 10 GRID 22 PARCEL(S) 68 PROPOSED LOT SIZE 1.00 AC

AS APPLICANT, I UNDERSTAND THE FOLLOWING: THE SYSTEM INSTALLED SUBSEQUENT TO THIS APPLICATION IS ACCEPTABLE ONLY UNTIL PUBLIC SEWERAGE IS AVAILABLE. THIS APPLICATION IS COMPLETE WHEN ALL APPLICABLE FEES AND A SUITABLE SITE PLAN HAVE BEEN RECEIVED. I ACCEPT THE RESPONSIBILITY FOR COMPLIANCE WITH ALL M.O.S.H.A. AND "MISS UTILITY" REQUIREMENTS. APPROVAL IS BASED UPON SATISFACTORY REVIEW OF A PERC CERTIFICATION PLAN.

TEST RESULTS WILL BE MAILED TO APPLICANT:

[Signature]  
SIGNATURE OF APPLICANT

HOWARD COUNTY HEALTH DEPARTMENT, BUREAU OF ENVIRONMENTAL HEALTH, WELL AND SEPTIC PROGRAM  
3525-H ELLICOTT MILLS DRIVE, ELLICOTT CITY, MARYLAND 21043-4544 (410) 313-1771 FAX (410) 313-3648  
TDD (410) 313-2323 TOLL FREE 1-877-4MD-DHMH

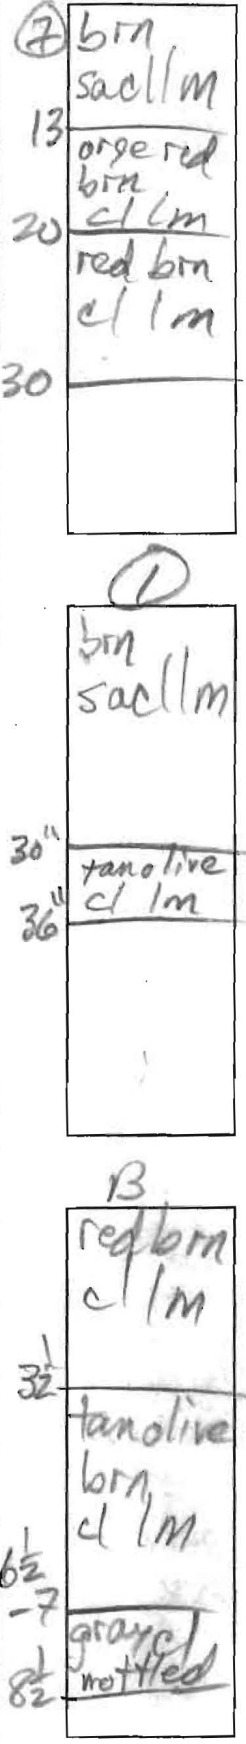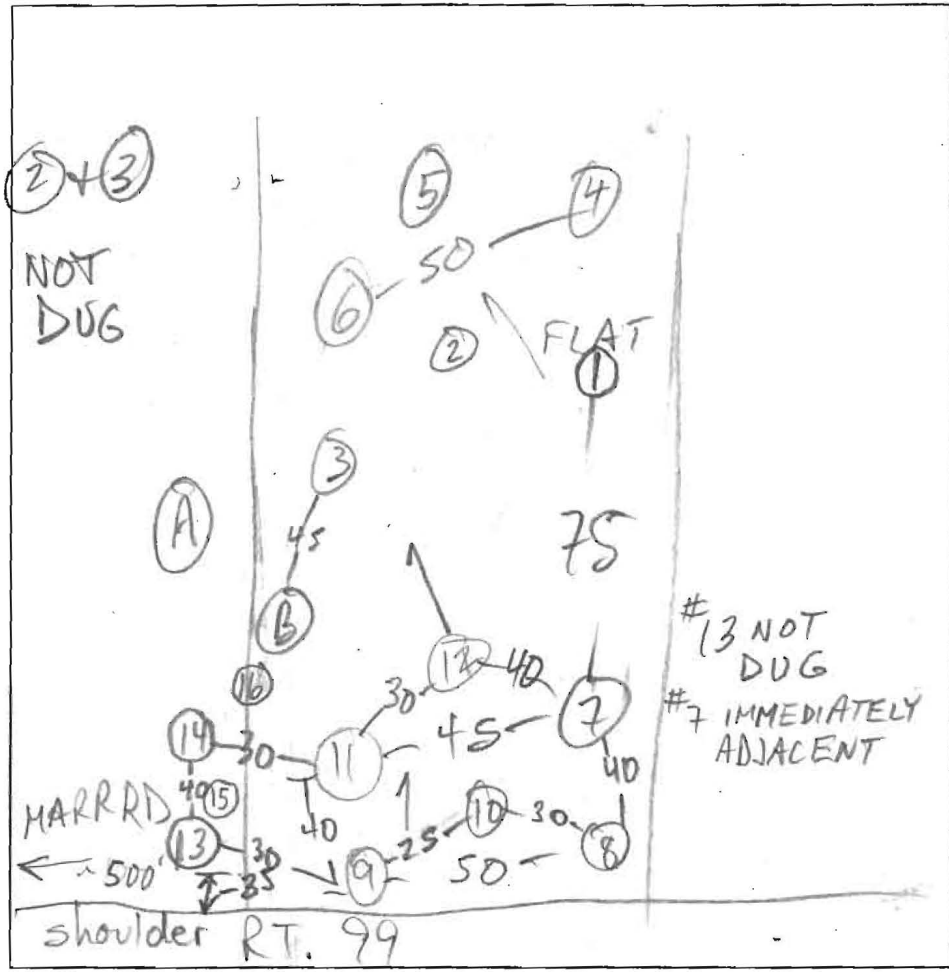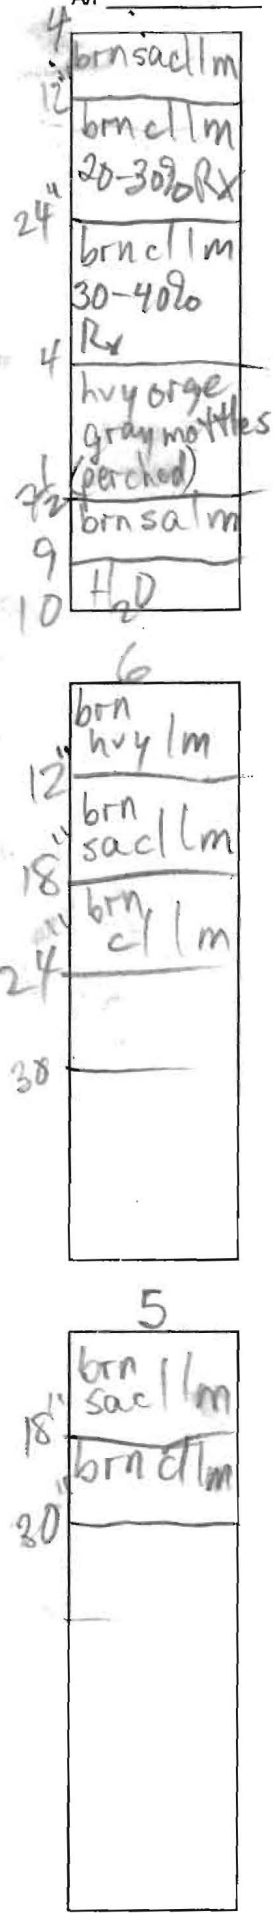

DATE	TEST #	DEPTH	START	BREAK 1" DROP	STOP 2" DROP	TIME OF 2nd INCH	P/F/H
8/29/03	A	7"	10:25	11			
			10:35	10 1/2			
			10:45	10 1/4		31	
			10:55	9 1/2		32	
			11:05	9 3/4		12/16	
			11:15	9 1/2		12/32	
			11:25	9 1/2		32	
9/11/03	B v	8 1/2"	CONV. TRENCH PERC		(F)		
11/17/03							

REMARKS \_\_\_\_\_

SANITARIAN \_\_\_\_\_ BACKHOE \_\_\_\_\_ OTHERS \_\_\_\_\_

TEST HOLES USED IN SDA \_\_\_\_\_ AVG. PERC TIME \_\_\_\_\_ SQ. FT/BR \_\_\_\_\_

TRENCH WIDTH \_\_\_\_\_ INLET DEPTH \_\_\_\_\_ MAX. BOT DEPTH \_\_\_\_\_ EFFECTIVE S/W \_\_\_\_\_

# APPLICATION

## PERCOLATION TESTING

A \_\_\_\_\_

P \_\_\_\_\_

HOWARD COUNTY HEALTH DEPARTMENT  
BUREAU OF ENVIRONMENTAL HEALTH  
3525-H ELLICOTT MILLS DRIVE/ELLICOTT CITY, MARYLAND 21043  
TELEPHONE: 313-2640

DISTRICT \_\_\_\_\_

DATE \_\_\_\_\_

TO: THE COUNTY HEALTH OFFICER  
ELLICOTT CITY, MARYLAND

I HEREBY APPLY FOR THE NECESSARY TEST PRIOR TO APPLICATION FOR PERMIT TO CONSTRUCT (OR RECONSTRUCT) A SEWAGE DISPOSAL SYSTEM.

PROPERTY OWNER \_\_\_\_\_

ADDRESS \_\_\_\_\_ PHONE \_\_\_\_\_

AGENT OR PROSPECTIVE BUYER \_\_\_\_\_

ADDRESS \_\_\_\_\_ PHONE \_\_\_\_\_

PROPERTY LOCATION:

SUBDIVISION Williams LOT NO. \_\_\_\_\_

ROAD AND DESCRIPTION \_\_\_\_\_

TAX MAP \_\_\_\_\_ PARCEL # \_\_\_\_\_

SIZE OF LOT \_\_\_\_\_ TYPE BLDG. \_\_\_\_\_  
(SINGLE FAMILY DWELLING OR COMMERCIAL)

THE SYSTEM INSTALLED UNDER THIS APPLICATION IS ACCEPTABLE ONLY UNTIL PUBLIC FACILITIES BECOME AVAILABLE. I FULLY UNDERSTAND THE FEE CONNECTED WITH THE FILING OF THIS PERC TEST APPLICATION IS NON-REFUNDABLE UNDER ANY CIRCUMSTANCES. I ALSO AGREE TO COMPLY WITH ALL M.O.S.H.A. REQUIREMENTS IN TESTING THIS LOT.

(SIGNATURE OF APPLICANT)

APPROVED BY \_\_\_\_\_ FOR \_\_\_\_\_ DATE \_\_\_\_\_

DISAPPROVED BY \_\_\_\_\_ FOR \_\_\_\_\_ DATE \_\_\_\_\_

HOLD PENDING FURTHER TESTS \_\_\_\_\_

REASONS FOR REJECTION OR HOLDING \_\_\_\_\_

PERCOLATION TEST PLAT/PRELIMINARY PLAT - TITLE OR I.D. # \_\_\_\_\_ DATE \_\_\_\_\_

SITE DEVELOPMENT PLAN/FINAL PLAT - TITLE OR I.D. # \_\_\_\_\_ DATE \_\_\_\_\_

# THIS IS NOT A PERMIT

COUNTY #

SOIL PROFILE

0'

Brown/Black  
clay 1 1/2'

light Brown  
clay 2'

Red/Brown  
coarse grain  
SCL 5 1/2'

light Brown  
tan w/  
ging matrix 6' 1"

water

14A

Orange/Red  
Brown SCL 2 1/2'

Red/Yellow  
SCL 4 1/2'

Brown/tan  
Sandy clay  
tan 5 1/2'

Grade 6'

12A

Brown L

Red/Orange  
Brown  
SCL clay  
clay

water 5 7"

6'


SOIL PROFILE

0'

Red/Brown  
SCL 2 1/2'

Orange/Red  
tan SCL 4'

Brown/tan  
Sandy clay  
tan 4 1/2'

Grade 6' 9"

INDICATE NORTH - NAME ADJOINING ROADWAY AS BASE LINE.

DATE	TEST NO.	DEPTH	PRE-WET		TEST - 1" DROP		TIME
			START	STOP	START	STOP	
12/16/03	P-15	29"	2:07	2:41	2:41	3:28	47
	P-16	28"	2:15	3:20	3:46	4 1/4"	F
3/17/04	9A	30"	10:19	10:49	11:37	48 min	
	14A	30"	10:31	11:01	3 1/4" - Pulled		F
	12A	30"	11:08	11:41	12:28	48 min	47
	B2	30"	11:40	12:19	1:17	58 min	

REMARKS \_\_\_\_\_

TYPE OF SOIL \_\_\_\_\_

TESTED BY \_\_\_\_\_ ALSO PRESENT \_\_\_\_\_

TRENCH DESIGN DATA: AVERAGE PERCOLATION TIME \_\_\_\_\_ TRENCH WIDTH \_\_\_\_\_

INLET DEPTH \_\_\_\_\_ MAXIMUM BOTTOM DEPTH \_\_\_\_\_ SQ. FT./BEDROOM \_\_\_\_\_


TEST DATA

NAME <u>Williams</u>	FILE NO <u>519038</u>
LOCATION <u>Rt. 99 W of Marriottsville</u>	COUNTY <u>Howard</u>
<u>Rd</u>	DATE <u>11/17/03</u>
RECORDED BY <u>M. Ripkin</u>	GRID _____ E
	N

HOLE NO.	TEST NO.	DEPTH HOLE	CLOCK TIME	ELAPSED TIME	MEASUREMENT	REMARKS (Method, Moisture, Biopores)
13	H <sub>2</sub> O 7"	28"	10:54	—	10"	> 1/16 FAIL
0	organics & topsoil		11:09	15	9 15/16	
6	brn loam		11:24	15	9 14/16	
14	orge brn sa c l m					
28	orge c l m					
32	—					
14	7"	28"	11:20	—	11"	> 1/4 > 1/8 > 1/8 > 1/8 > 1/8 > 1/8 > 1/8 OK 120 min/in
0	organics & topsoil		11:35	15	10 3/4	
6	orge brn l m		11:50	15	10 5/8	
16	orge loamy sa		12:05	15	10 1/2	
28	orge c l m		12:20	15	10 3/8	
			12:35	15	10 1/4	
			12:50	15	10 1/8	
30						

**TEST DATA**

NAME <u>Cornerstone Homes</u>	FILE NO <u>519038</u>
LOCATION <u>Rt. 99, W of P. Marriottsville</u>	COUNTY <u>Howard</u>
	DATE <u>9/11/03</u>
	GRID _____ E
RECORDED BY <u>Mark Ripkin</u>	N

HOLE NO.	TEST NO. <i>H<sub>2</sub>O DEPTH</i>	DEPTH	CLOCK TIME	ELAPSED TIME	MEASUREMENT	REMARKS (Method, Moisture, Biopores)
4	7"	12"	9:54	—	11"	
			10:09	15	10 10/16	> 6/16
			10:24	15	10 1/2	> 2/16
			10:49	25	10 5/16	> 3/16
			11:04	15	10 4/16	> 1/16
			11:19	15	10 2/16	> 2/16
			11:34	15	10 1/16	> 1/16
			11:49	15	10	> 1/16
5	7"	18"	10:16	—	11"	
			10:31	15	10 1/2	> 8/16
			10:46	15	10 1/4	> 4/16
			11:01	15	10 1/16	> 3/16
			11:16	15	9 25/32	> 9/32
			11:31	15	9 20/32	> 5/32
			11:48	17	9 12/32	> 8/32
			12:03	15	9 5/32	> 3/32
			12:18	15	9 1/32	> 4/32
			12:37	19	8 28/32	> 6/32
						 120 min/inch OK

TEST DATA

NAME <u>Williams/Cornerstone</u>	FILE NO <u>519038</u>
LOCATION <u>Rt. 99, W of Marriottsville Rd</u>	COUNTY <u>Howard</u>
	DATE <u>9/11/03</u>
	GRID _____ E
RECORDED BY <u>M. Ripkin</u>	_____ N

HOLE NO.	TEST NO.	DEPTH	CLOCK TIME	ELAPSED TIME	MEASUREMENT	REMARKS (Method, Moisture, Biopores)
6	H <sub>2</sub> O 74	24"	10:30	—	8"	
			10:48	18	7 2/16 > 14/16	
			11:03	15	6 7/16 > 11/16	
			11:22	19	5 3/4 > 11/16	
			11:37	15	5 1/4 > 8/16	
			11:52	15	4 1/16 > 9/16	
			12:07	15	4 4/16 > 7/16	
			12:22	15	3 15/16 > 5/16	
			12:37	15	3 9/16 > 6/16	
						~48 min/inch
1	7"	30"	1:55	—	11	
			2:10	15	10 10/16 > 6/16	
			2:28	15	10 9/16 > 1/16	
			2:40	15	10 17/32 > 1/32	
						ⓕ
7	7"	20"	3:03	—	11	
			3:15	12	10 1/4 > 3/4	
			3:28	13	9 6/16 > 14/16	
			3:43	15	8 11/16 > 11/16	
			3:58	15	7 15/16 > 12/16	
			4:13	15	7 1/4 > 11/16	
4:28	15	6 10/16 > 10/16				
						68 min/inch

TEST DATA

NAME Williams / Cornerstone FILE NO 519038  
 LOCATION Rt. 99, W of Marriottsville COUNTY Howard  
 DATE 10/1/03  
 GRID \_\_\_\_\_ E \_\_\_\_\_  
 RECORDED BY M. Ripkin N \_\_\_\_\_

HOLE NO.	TEST NO.	DEPTH	CLOCK TIME	ELAPSED TIME	MEASUREMENT	REMARKS (Method, Moisture, Biopores)
10 profile	7"	27	11:06	-	10	9/16
			11:21	15	9 7/16	> 9/16
		0	11:36	15	9 1/16	> 6/16
		10	11:53	17	8 2/32	> 13/32
		27	12:13	20	8 3/16	> 15/32
		36	12:33	20	7 13/16	> 6/16 53
			12:58	28	7 5/16	> 8/16 56
			1:13	15	7	> 5/16 48
						~53 min/inch
9	8"	30	11:20	-	10	9/16
			11:35	15	9 7/16	> 9/16
			11:50	15	9 3/32	> 11/32
			12:10	20	8 1/2	> 17/32
			12:30	20	8 2/16	> 6/16 53
			12:57	27	7 10/16	> 8/16 56
			1-17	20	7 5/16	> 5/16 64
						~64 min/inch

TEST DATA

NAME Williams / Cornerstone FILE NO 519038  
 LOCATION Rt. 99, W of Marriottsville COUNTY Howard  
 DATE 10/1/03  
 GRID \_\_\_\_\_ E \_\_\_\_\_  
 RECORDED BY M. Rifkin N \_\_\_\_\_

HOLE NO.	TEST NO.	DEPTH	CLOCK TIME	ELAPSED TIME	MEASUREMENT	REMARKS (Method, Moisture, Biopores)
8 profile	7 <sup>11</sup>	30"	1:02	—	9	> 1/16
			1:27	20	8 5/16	> 3/16
			1:45	18	7 1/4	> 6/16
		brn lm	2:00	15	2 1/2	> 7/16
		sacl lm	2:15	15	7 1/16	> 4/16
		brn yel	2:30	15	6 13/16	> 5/16
		sicl lm	2:45	15	6 8/16	> 4/16
		22	3:00	15	6 4/16	> 60 min/inch
		orge brn cl lm	30			
		orge brn hvy cl lm				

TEST DATA

NAME Williams/Cornerstone FILE NO 519038  
 LOCATION Rt. 99, W of Marriottsville COUNTY Howard  
 DATE 10/1/03  
 GRID \_\_\_\_\_ E  
 RECORDED BY M. Ripkin \_\_\_\_\_ N

HOLE NO.	TEST NO. H <sub>2</sub> O	DEPTH TEST	CLOCK TIME	ELAPSED TIME	MEASUREMENT	REMARKS (Method, Moisture, Biopores)		
12 profile	7"	18"	10:37	—	9"			
			10:52	15	8 2/16	> 7/16		
			11:07	15	8 3/16	> 6/16		
			11:22	15	7 14/16	> 5/16		
			11:37	15	7 21/32	> 7/32		
			11:52	15	7 11/32	> 9/32		
			12:17	25	6 15/16	> 7/16		
			12:32	15	6 9/16	> 6/16		
								~40 min ok inch
11	7"	10"	10:50	—	10"			
			11:05	15	9 1/32	> 31/32		
			11:20	15	8 5/32	> 28/32		
			11:35	15	7 12/32	> 25/32		
			11:52	17	6 1/2	> 28/32		
			12:07	203	5 13/32	> 35/32		
			12:34	15	4 18/32	> 27/32		
								NOT IN DENSEST LAYER
								RETEST
22 32	orge brn h. cl / m	22	12:52	—	10 1/8	> 7/8		
			1:12	20	9 3/8	> 3/8 12		
			1:27	15	8 3/4	> 9/32		
			1:42	15	8 15/32	> 14/32		
			1:57	15	8 1/32	> 9/32		
			2:12	15	7 3/4	> 11/32		
			2:27	15	7 4/32	> 9/32		
			2:42	15	6 26/32	> 10/32		
					~50 min/inch			

**SANITARY/ENVIRONMENTAL ENG., INC.**

Consulting Engineers  
 1414 Washington Road  
 WESTMINSTER, MARYLAND 21157  
 (410) 876-7740  
 FAX (410) 840-9924

JOB WILLIAMS LOT 14  
 SHEET NO. OLD FREDERICK ROAD  
 CALCULATED BY \_\_\_\_\_ DATE \_\_\_\_\_  
 CHECKED BY \_\_\_\_\_ DATE 6/11/04  
 SCALE LOW PRESSURE - REDESIGN

3 BED ROOMS x 150 = 450 GPD  
 LOADING RATE - 0.5 GPD / 59. ft = 900 Sq. Ft.  
 36" TRENCH - 900 / 3 = 300 LINEAR FEET

4 TRENCHES @ 40' + 90' + 90' + 80' = 300 LINEAR FEET

PUMP RATE - 60 PERFORATIONS @ 1.63 = 98 GPM

PUMP DOSE 5 x (35' + 85' + 85' + 75') = 1400' - 2" PVC  
 14 x 17.4 GAL / 100' = 244 GAL

PLUS - 50' - 3" FM and MANIFOLD @ 38.4 GAL / 100'  
 0.5 x 38.4 = 19 GAL DOSE = 244 + 19 = 263 GAL

263 GAL / 7.48 = 35 cu ft / 60 Sq. ft = 0.6' = 7"

EMERGENCY STORAGE = 1.7' x 60 sq ft = 103 cu ft = 767 GAL

TDH = ELEV DIFFERENCE - 475.0' - 469.7' = 5.3'  
 DISTAL HEAD 2.0'

F-2" = 6' + VALVE + L + UNION + L + L + REDUCER,  
 6 + 1.5 + 7 + 2 + 7 + 7 + 10 = 40.3'

f-2" =  $0.0984 \frac{98^{1.85}}{2.067^{4.87}} = 0.0984 \frac{4828}{34.33} = 13.8' / 100'$

F-2" = 0.403 x 13.8' = 5.6'

F-3" = 20' + L + 1 + L  
 20' + 10 + 1 + 10 = 41' f = 2.09' / 100' = 0.41 x 2.09 = 0.86'

F = 5.6 + 0.86 = 6.5'

TDH = 5.3' + 2.0' + 6.5' = 13.8' (14')

PUMP TO REMOVE 98 GPM @ 14' TDH

GOULDS MODEL 3885 - WE 10 H - OR EQUAL

# BENCHMARK

ENGINEERS ▲ LAND SURVEYORS ▲ PLANNERS

## ENGINEERING, INC.

Christopher A. Malagari, P.E., President  
Donald A. Mason, P.E., Vice President

March 9, 2004

Mr. John Boris Jr., RS  
Howard County Bureau of Environmental Health  
3525 H Ellicott Mills Drive  
Ellicott City, MD. 221043

Re: Williams Property  
Revised Percolation Testing Plan

Dear Mr. Boris:

Enclosed please find the revised copy of the Percolation Test Plan for the above referenced project.

As discussed with you on the phone in February, we have performed additional field survey work to assist in satisfying your Departments needs. We have field located Route 99, the existing "farm road", staked 3 additional perc holes to be tested and detailed topography of the low area immediately west of the "farm road". All this is reflected on the plan. What you will see from the spot elevations within the low area is that it is very flat (+/- 0.1 foot) in either direction. The drainage area to this low area was calculated by our office and appears to be approximately 3400 square feet ± (0.8 acres) of drainage to this area. This is a very insignificant amount of water. This low area can be eliminated by providing positive drainage in either direction (east or west) to allow for any "trapped" water to flow out.

For the record, the original percolation test hole locations were **not** staked off the subject lot. It was determined after further review of the plan and field information that the holes shown on the Percolation Certification Plan are the actual field located test holes. The field tests were performed in a different location than where we actually staked the holes. This can be easily determined because the original stakes are still in the ground and you can see where the tests were performed in relationship to the stakes. Therefore, the Health Department and backhoe operator in an area chosen by them, not by Benchmark Engineering or my client, dug holes 7 and 8 shown off the lot.

In closing, the enclosed plan shows three (3) additional holes to be tested. They are labeled as hole numbers 9A, 12A and 14A. Please notify us of the percolation dates. We want to be present during the testing so please do not test without us or the owner being present.


Thanks for your time and assistance in this important matter. We look forward to hearing from you.

Sincerely,

A handwritten signature in cursive script, appearing to read "C. Malagari".

Christopher A. Malagari, P.E., NSPE  
President

Cc: Mr. Paul Hinkle, Owner  
Mr. Frank Skinner, Director Health Dept.

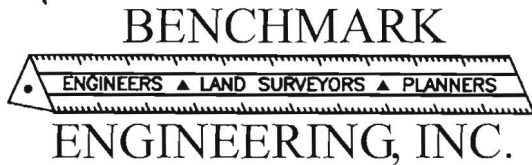

Christopher A. Malagari, P.E., President  
Donald A. Mason, P.E., Vice President

Mr. John Boris Jr., RS  
Bureau of Environmental Health  
Howard County  
3525 H Ellicott Mills Drive  
Ellicott City, Md. 21043

Re: Williams Property  
Low Dose System 4-bedroom Devonshire Proposed

Dear Mr. Boris:

Enclosed please find a copy of the proposed Low Dose System for the above referenced project.

The limits of the proposed septic easement shown are based on your request per a conversation you had with the property owner, Paul Hinkle. We still feel that there is additional area to the north of the Perc hole 10 and west of perc hole 9 that appears to be satisfactory based on the field testing performed.

The information provided indicates that 606± feet of a Low Dose System will fit within the limits of the septic easement.

We would like to meet with you after you have reviewed the enclosed drawing. Please call me or Paul Hinkle to let us know your schedule and a time/date.

Thanks again for your time and efforts on this important matter.

Sincerely,

Christopher A. Malagari, PE, NSPE  
President

Enclosure

# ARTERIAL FREDERICK ROAD RIGHT-OF-WAY


TER MAIN  
2. 44-3480

N 76°23'31" W

107.06'

UP CMPMD73

GRID NORTH

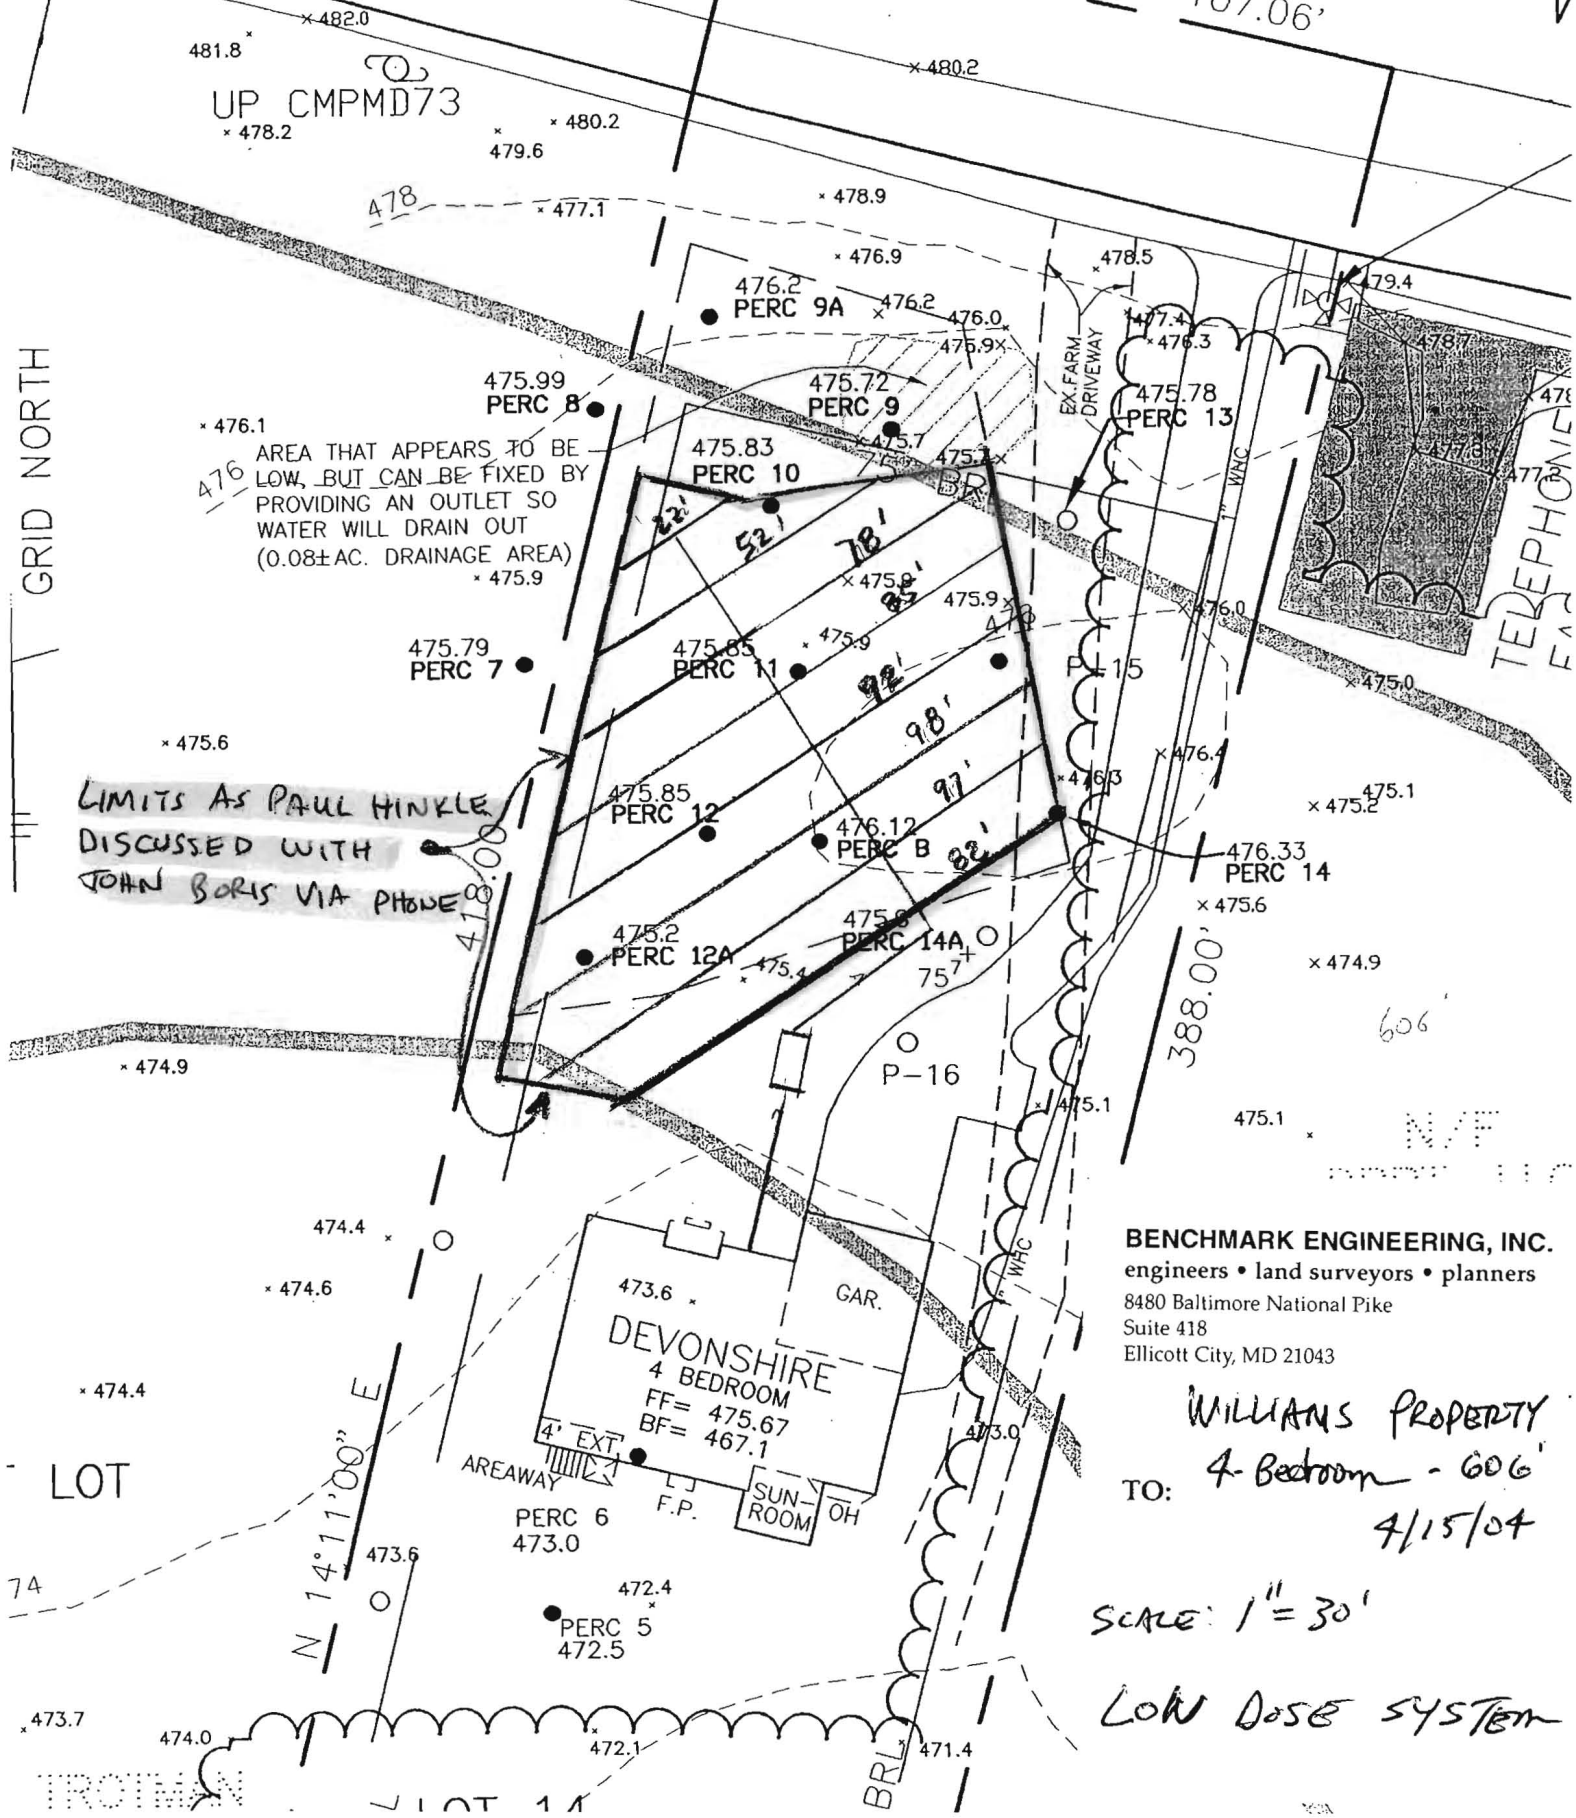

AREA THAT APPEARS TO BE LOW, BUT CAN BE FIXED BY PROVIDING AN OUTLET SO WATER WILL DRAIN OUT (0.08±AC. DRAINAGE AREA)

LIMITS AS PAUL HINKLE DISCUSSED WITH JOHN BORIS VIA PHONE

**BENCHMARK ENGINEERING, INC.**  
engineers • land surveyors • planners  
8480 Baltimore National Pike  
Suite 418  
Ellicott City, MD 21043

*WILLIAMS PROPERTY*  
TO: *4-Bedroom - 606'*  
*4/15/04*


SCALE: 1" = 30'

*LOW DOSE SYSTEM*

TROTMAN

LOT 11

BRL

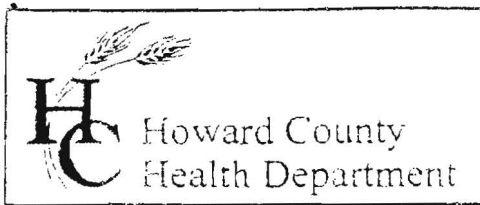

3525 H Ellicott Mills Drive, Ellicott City, MD 21043  
(410) 313-2640 Fax (410) 313-2648  
TDD (410) 313-2323 Toll Free 1-866-313-6300  
website: www.hchealth.org

Penny E. Borenstein, M.D., M.P.H., Health Officer

January 2, 2004

Cornerstone Homes  
9695 Norfolk Avenue  
Laurel, MD 20723  
Attn: Paul Henkel

RE: Percolation Test Results – A 519038  
Williams Property, Old Frederick Road  
Tax Map 21, Parcel 68, Lot 14  
Existing Parcel of Record

Dear Mr. Henkel:


Percolation testing conducted August 29, September 11, October 1, November 17 and December 16, 2003 on the referenced property indicated insufficient satisfactory soil conditions. The primary limiting factors for proposed sand mounds or a trench system with pretreatment are dense clay layers with slow test times and some unsuitable topography. The primary limiting factors for conventional trench designs are deep, dense clay layers and shallow groundwater. Lot size is also an issue. Copies of the test results are enclosed.

For the record, the following chronology is provided:

July 2, 2003: Application submitted with plan showing parcel other than that proposed for testing  
August 28: Revised plan showing correct parcel confirmed for testing  
August 29: Initial testing stopped due to inability to stake test locations with confidence  
September 11: Two of four staked sand mound test locations in initial layout fail, two pass; builder advises Health Dept. that lot is approximately 15' wider than previously thought  
October 1: Testing conducted in higher locations; all test locations meet test time guidelines  
November ~3: Engineer advises Health Dept. that parcel location now known to be inaccurate based on boundary survey; actual parcel location now shifted 35' to the east, placing two passed test holes off the parcel five to ten feet beyond the western parcel boundary  
November 17: Testing conducted east of passed test holes of 10/1; one test marginal, one test fails  
December 9: Site inspection with this inspector, Regional Sanitarian Barry Glotfelty and Chris Malagari of Benchmark Engineering; Barry recommends additional testing to support shallow trench system with pretreatment; test locations agreed upon by all parties  
December 16: Testing conducted as recommended; one test passes, one test fails

If you choose to pursue further review despite this disapproval, such review is contingent upon submission by a registered engineer/surveyor of a certification plan showing the following:

- 1) actual locations of all excavated test holes with suitable designations for passed/failed and for type of test (conventional, sand mound, trench w/pretreatment)
- 2) proposed house location
- 3) proposed sewage reserve area with layout for two systems
- 4) proposed driveway, public water connection and utility lines

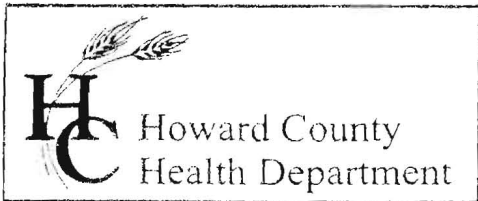

3525 H Ellicott Mills Drive, Ellicott City, MD 21043  
(410) 313-2640 Fax (410) 313-2648  
TDD (410) 313-2323 Toll Free 1-866-313-6300  
website: www.hchealth.org

Penny E. Borenstein, M.D., M.P.H., Health Officer  
January 2, 2004

Cornerstone Homes  
9695 Norfolk Avenue  
Laurel, MD 20723  
Attn: Paul Henkel

RE: Percolation Test Results – A 519038  
Williams Property, Old Frederick Road  
Tax Map 21, Parcel 68, Lot 14  
Existing Parcel of Record

Dear Mr. Henkel:

Percolation testing conducted August 29, September 11, October 1, November 17 and December 16, 2003 on the referenced property indicated insufficient satisfactory soil conditions. The primary limiting factors for proposed sand mounds or a trench system with pretreatment are dense clay layers with slow test times. The primary limiting factors for conventional trench designs are deep, dense clay layers and shallow groundwater. Copies of the test results are enclosed.

Further review is contingent upon submission by a registered engineer/surveyor of a percolation certification plan showing the following:

*limited lot size*

- 1) actual locations of all excavated test holes with suitable designations for passed/failed and for type of test (conventional, sand mound, trench w/pretreatment)
- 2) proposed house location
- 3) proposed sewage reserve area with layout for two systems
- 4) proposed driveway, public water connection and utility lines
- 5) note certifying that all existing wells and septic systems within 100 feet of property boundaries have been shown
- 6) a note indicating that depicted topography reflects field-verified information
- 7) the plan identification number (PC 519680) in the title block

The percolation certification plat should be submitted within 60 days to allow field verification if necessary. If you have any questions regarding this matter, please contact me at the above address or by calling (410) 313-2640.

*ch r 03/0*


Very truly yours,

Mark E. Rifkin, R.S.  
Water and Sewerage Program

MR

Enclosures

cc: Benchmark Engineering  
File

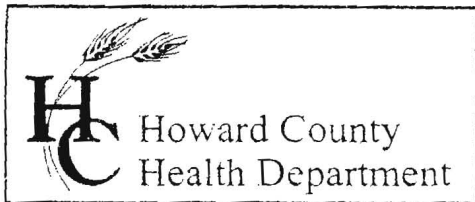

3525 H Ellicott Mills Drive, Ellicott City, MD 21043  
(410) 313-2640 Fax (410) 313-2648  
TDD (410) 313-2323 Toll Free 1-866-313-6300  
website: www.hchealth.org

Penny E. Borenstein, M.D., M.P.H., Health Officer  
October 23, 2003

John Connors  
c/o Cornerstone Homes  
9695 Norfolk Ave  
Laurel, MD 20723

RE: Sand Mound Percolation Test Results – A 519038  
Williams Property, Route 99, Tax Map 10, Parcel 68  
Ex. Parcel of Record

Dear Mr. Connors:

Percolation testing conducted September 11, 2003 on the referenced property indicated unsatisfactory soil conditions due to slow test times. Subsequent testing higher on the lot on October 1, 2003 produced satisfactory soil conditions. Copies of the test results are enclosed.

Further review is contingent upon submission by a registered engineer/surveyor of a percolation certification plan showing the following:

- 1) actual locations of all excavated test holes with field-verified topography at 2' contours
- 2) proposed sewage reserve area to fit the mound design specifications as enclosed
- 4) proposed house
- 5) proposed driveway and utility connections located at least 10' from any sand mound
- 6) a note certifying that all existing wells and septic systems within 100 feet of property boundaries have been shown
- 7) a note indicating that depicted topography reflects field-verified information
- 8) the plan identification number (PC 519038) in the title block
- 9) a note specifying that a sand mound design plan will be approved prior to issuance of building permit

The percolation certification plat should be submitted within 60 days to allow field verification if necessary. If you have any questions regarding this matter, please contact me at the above address or by calling (410) 313-2640.

Very truly yours,

Mark E. Rifkin, R.S.  
Water and Sewerage Program

MR


Enclosures

cc: Benchmark Engineering  
File

- 5) note certifying that all existing wells and septic systems within 100 feet of property boundaries have been shown
- 6) a note indicating that depicted topography reflects field-verified information
- 7) the plan identification number (PC 519680) in the title block

If you so choose, two proposals can be submitted: one depicting proposed sand mounds, and a second depicting a proposed shallow trench system with pretreatment. The percolation certification plans should be submitted within 60 days to allow field verification if necessary. If you have any questions regarding this matter, please contact me according to the above information.

Very truly yours,

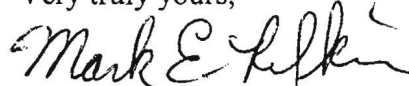

Mark E. Rifkin, R.S.

Water and Sewerage Program

MR

Enclosures

cc: Frank Skinner, Bureau Director  
Benchmark Engineering  
File


**EQUATIONS FOR CALCULATING SAND MOUND DIMENSIONS  
FROM DESIGN AND CONSTRUCTION MANUAL FOR SAND MOUND SYSTEMS  
TABLE 3.1**

% slope =	3 %	or	0.03 ft./ft.
Upslope correction factor =	0.92 see Table 3.2 below		
Downslope correction factor =	1.1 see Table 3.2 below		
Absorption rate =	1.0 gpd/ft. <sup>2</sup>		
Number of Bedrooms =	4		
Design Flow =	600 gpd (150 gpd/bedroom)		
Depth to water table (Z) =	36 in.		
Absorption bed ft. <sup>2</sup> (A × B) = Design Flow / Absorption rate =	600 ft. <sup>2</sup>		
Bed length (B) =	40 ft. (21 ft. to 101 ft dependent on site)		
Bed width (A) =	$\frac{\text{Absorption bed ft.}^2}{\text{Bed length}}$	=	15.00 ft. (15 ft. or less)
Upslope sand fill depth (D) = 48 in. - Z in. =	12 in. (12 in. min.)		
Down slope sand fill depth (E) = [12 A × % slope] + D in. =	17.40 in.		
Cap + topsoil at bed center	(H) = 18 in.		
Cap + topsoil at bed edge	(G) = 12 in.		
Total bed depth	(F) = 10 in.		
Sideslope setback (K) = [((D + E)/2) + 28 in.] × 3 =	128.10 in.	or	10.68 ft.
Upslope setback (J) = (22 in. + D) × 3 × upslope corr. factor =	93.84 in.	or	7.82 ft.
Downslope setback (I) = (22 in. + E) × 3 × downslope corr. factor =	130.02 in.	or	10.84 ft.
Total width of mound (W) = 12A + J + I =	403.86 in.	or	<b>33.66 ft.</b>
Total length of mound (L) = 12B + K + K =	736.20 in.	or	<b>61.35 ft.</b>
<b>TABLE 3.2</b>	area = 2,065 sq. ft.		

**TABLE 3.2**  
Downslope and upslope correction factors  
for sand mounds on sloping sites

Slope %	Downslope Correction Factor	Upslope Correction Factor
0	1.00	1.00
2	1.06	0.94
4	1.14	0.89
6	1.22	0.86
8	1.32	0.80
10	1.44	0.77
12	1.57	0.73

# BENCHMARK

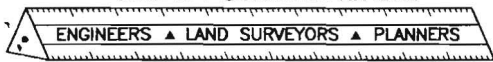

## ENGINEERING, INC.

8480 BALTIMORE NATIONAL PIKE ▲ SUITE 418  
 ELLICOTT CITY, MARYLAND 21043  
 phone: 410-465-6105 fax: 410-465-6644  
 e-mail: BENCHMRK@CAIS.COM

PROJECT NO: 1689

DESIGNED BY: CAM DATE: 11/18/03

CHECKED BY: \_\_\_\_\_ DATE: \_\_\_\_\_

PROJECT: Williams Property

TITLE: \_\_\_\_\_

### EQUATIONS FOR CALCULATING SAND MOUND DIMENSIONS FROM DESIGN AND CONSTRUCTION MANUAL FOR SAND MOUND SYSTEMS TABLE 3.1

% slope =	1 % or	0.01 ft./ft.
Upslope correction factor =	0.97 see Table 3.2 below	
Downslope correction factor =	1.03 see Table 3.2 below	
Absorption rate =	1.2 gpd/ft. <sup>2</sup>	
Number of Bedrooms =	4	
Design Flow =	600 gpd (150 gpd/bedroom)	
Depth to water table (Z) =	36 in.	
Absorption bed ft. <sup>2</sup> (A × B) = Design Flow / Absorption rate =	500 ft. <sup>2</sup>	
Bed length (B) =	42 ft. (42 ft. to 104 ft dependent on site)	
Bed width (A) =	Absorption bed ft. <sup>2</sup> / Bed length =	11.90 ft. (12 ft. or less)
Upslope sand fill depth (D) = 48 in. - Z in. =	12 in. (12 in. min.)	
Down slope sand fill depth (E) = [12A × % slope] + D in. =	13.43 in.	
Cap + topsoil at bed center (H) =	18 in.	
Cap + topsoil at bed edge (G) =	12 in.	
Total bed depth (F) =	10 in.	
Sideslope setback (K) = [(D + E)/2 + 28 in.] × 3 =	122.14 in. or	10.18 ft.
Upslope setback (J) = (22 in. + D) × 3 × upslope corr. factor =	98.94 in. or	8.25 ft.
Downslope setback (I) = (22 in. + E) × 3 × downslope corr. factor =	109.47 in. or	9.12 ft.
Total width of mound (W) = 12A + J + I =	351.27 in. or	<b>29.27 ft.</b>
Total length of mound (L) = 12B + K + K =	748.29 in. or	<b>62.36 ft.</b>

area = 1,825 sq. ft.

### TABLE 3.2 Downslope and upslope correction factors for sand mounds on sloping sites

Slope %	Downslope Correction Factor	Upslope Correction Factor

0	1.00	1.00
2	1.06	0.94
4	1.14	0.89
6	1.22	0.86
8	1.32	0.80
10	1.44	0.77
12	1.57	0.73

# MINOR ARTERIAL RIGHT-OF-WAY

EX. 12 WATER MAIN  
CONTRACT No. 44-3480

50' EMP 073

N 76°23'31" W 107.06'

EX. FIRE  
HYDRANT  
CONTRACT  
No. 44-3480

EX. COI  
PR

PP

TELEPHONE  
EASEMENT

GRID NORTH

14 40-45

388.00'

PERC 7  
475.64

418.00'

CHB2

EVAL 308  
RC-DEC  
VT75

N/F LLC  
URBT, PARCEL 324  
TAX MAP 10, F. 203  
L. 4708 F. 203  
LOT 16  
RC-DEC  
ZONED:

N/F LLC  
URBT, PARCEL 324  
TAX MAP 10, F. 203  
L. 4708 F. 203  
LOT 16  
RC-DEC  
ZONED:

DEVONSHIRE  
PERC 16  
473.0  
PERC 5  
473.0

N/F TRICORP  
CORNELIUS P. PARCEL 88  
TAX MAP 10, F. 04  
L. 3469 F. 13  
LOT 13  
RC-DEC  
ZONED:

LOT 14  
1044 F. 416 68  
TAX MAP 10, P. 68  
RC-DEC  
ZONED:

N 151.100' E

N 141.100' E

10' BRL

10' BRL


CE  
HAG

To: <i>Mark Pelkin</i>	From: <i>John C</i>
Co./Dept.	Co.
Phone #	Phone #
Fax #	Fax #


FREDERICK 2

\* public water available  
 PLAN LATER FOUND TO BE IN ERROR -  
 LOT IS 15' WIDER THAN SHOWN 1:40  
 SEE ENG'R PLAN

8/28/03 *(MR)*  
 REVISED PLAN:  
 PREV. PLAN SHOWED INCORRECT PARCEL;  
 BLDR TO REDRAW 2 BEDS ON CONTOUR  
 MIN 65' x 25'

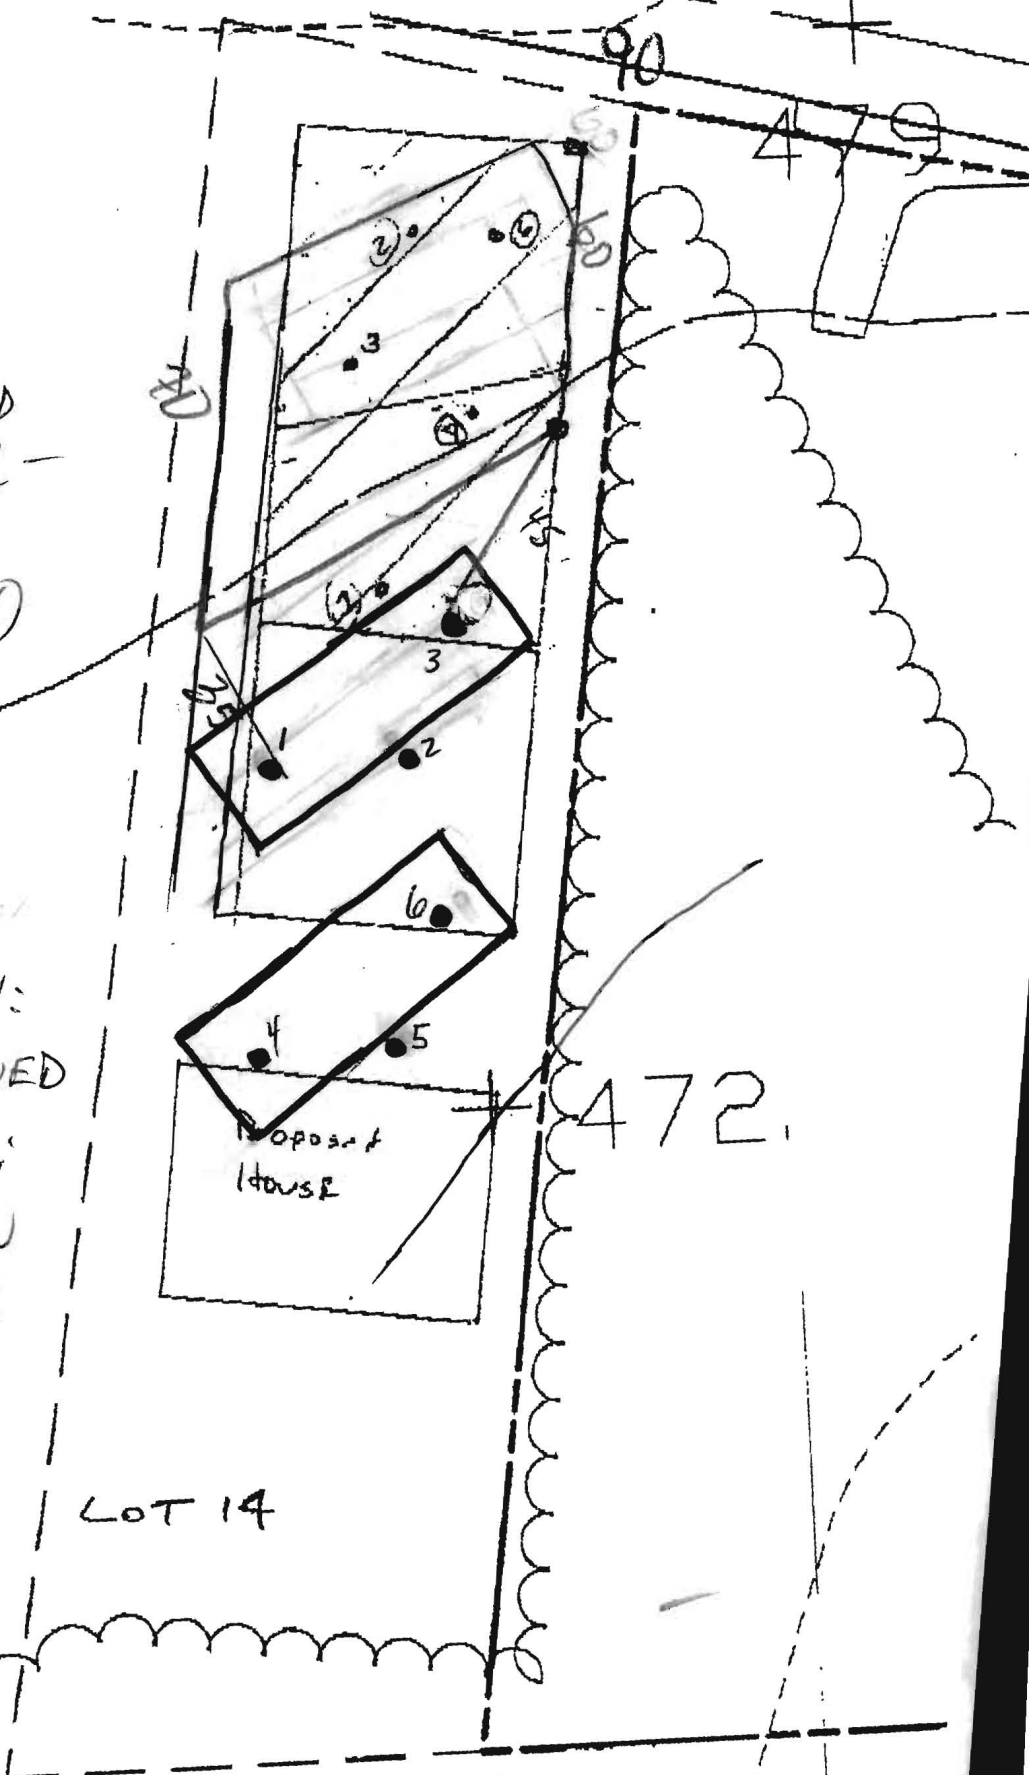

# BENCHMARK

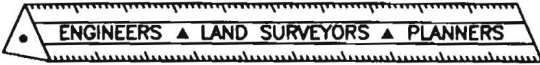

## ENGINEERING, INC.

8480 Baltimore National Pike • Suite 418 • Ellicott City, Maryland 21043

410 465-6105

410 465-6644 (Fax)

Email: [Benchmrk@cais.com](mailto:Benchmrk@cais.com)

TO: Mark Ripkan

### LETTER OF TRANSMITTAL

DATE	<u>11-20-03</u>	PROJECT No.	<u>1689</u>
ATTENTION			
RE:	<u>Williams Property</u>		

WE ARE SENDING YOU  Attached  Under separate cover via hand the following items

- |   |  |                                       |                                      |
|---|--|---------------------------------------|--------------------------------------|
| <input type="checkbox"/> Photocopies    | <input checked="" type="checkbox"/> Prints | <input type="checkbox"/> Originals    | <input type="checkbox"/> Samples     |
| <input type="checkbox"/> Specifications | <input type="checkbox"/> Invoices          | <input type="checkbox"/> Change Order | <input type="checkbox"/> Other _____ |

COPIES of	No. of SHEETS	DESCRIPTION
<u>1</u>	<u>1</u>	<u>Perc Certification plan</u>
<u>1</u>	<u>2</u>	<u>Sand mound design calculations</u>

THESE ARE TRANSMITTED as checked below

- |  |                                       |  |
|--|---------------------------------------|--|
| <input type="checkbox"/> For Comment           | <input type="checkbox"/> For your use | <input checked="" type="checkbox"/> For Approval |
| <input checked="" type="checkbox"/> For Review | <input type="checkbox"/> As requested | <input type="checkbox"/> Other _____             |

REMARKS:

---



---



---



---



---

COPY TO: \_\_\_\_\_

RECEIVED BY: Mary L. Bugge

If enclosures are not as noted, kindly notify us at once.

SIGNED: Cl Malagani

**SANITARY/ENVIRONMENTAL ENG., INC.**

**Consulting Engineers**

1414 Washington Road  
WESTMINSTER, MARYLAND 21157

(410) 876-7740  
FAX (410) 840-9924

**LETTER OF TRANSMITTAL**

TO HOWARD CO. HEALTH DEPT  
BUREAU OF ENVIRONMENTAL HEALTH  
3525-H ELLICOTT MILLS DRIVE  
ELLICOTT CITY, MD 21043

DATE	<u>6/15/04</u>	JOB NO.	
ATTENTION	<u>JOHN BODIS</u>		
RE:	<u>LOT 14</u>		
	<u>OLD FREDERICK RD</u>		
	<u>LOW PRESSURE SYSTEM</u>		

WE ARE SENDING YOU  Attached  Under separate cover via \_\_\_\_\_ the following items:

- Shop drawings     Prints     Plans     Samples     Specifications  
 Copy of letter     Change order     \_\_\_\_\_

COPIES	DATE	NO.	DESCRIPTION
<u>2</u>			<u>PRINTS - PLANS + SPECIFICATIONS</u>
<u>1</u>			<u>CALCULATIONS</u>
			<u>REDESIGN - LOADING RATE 0.5</u>

THESE ARE TRANSMITTED as checked below:

- For approval     Approved as submitted     Resubmit \_\_\_\_\_ copies for approval  
 For your use     Approved as noted     Submit \_\_\_\_\_ copies for distribution  
 As requested     Returned for corrections     Return \_\_\_\_\_ corrected prints  
 For review and comment     \_\_\_\_\_  
 FOR BIDS DUE \_\_\_\_\_     PRINTS RETURNED AFTER LOAN TO US




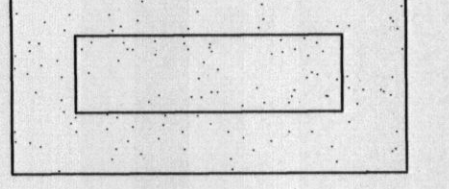
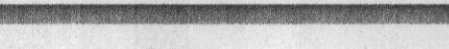
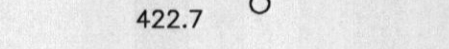
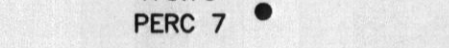
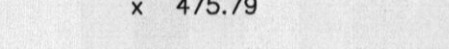
REMARKS \_\_\_\_\_  
 \_\_\_\_\_  
 \_\_\_\_\_  
 \_\_\_\_\_  
 \_\_\_\_\_  
 \_\_\_\_\_  
 \_\_\_\_\_  
 \_\_\_\_\_  
 \_\_\_\_\_



COPY TO file  
Bob Sheeley

SIGNED: Jim Clise

*If enclosures are not as noted, kindly notify us at once.*

**LEGEND**

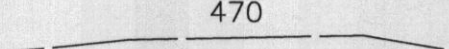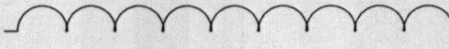-  470 EXISTING CONTOURS (FIELD SURVEYED OCT. 2003)
-  EXISTING TREELINE
-  CL. STREAM
-  PROPOSED SAND MOUND
-  SOILS DELINEATION LINE
-  PERC 1 422.7 PERC FAILED LOCATION
-  475.79 PERC 7 FIELD SHOT PERC PASSED LOCATION
-  x 475.79 FIELD SHOT PERC PASSED LOCATION

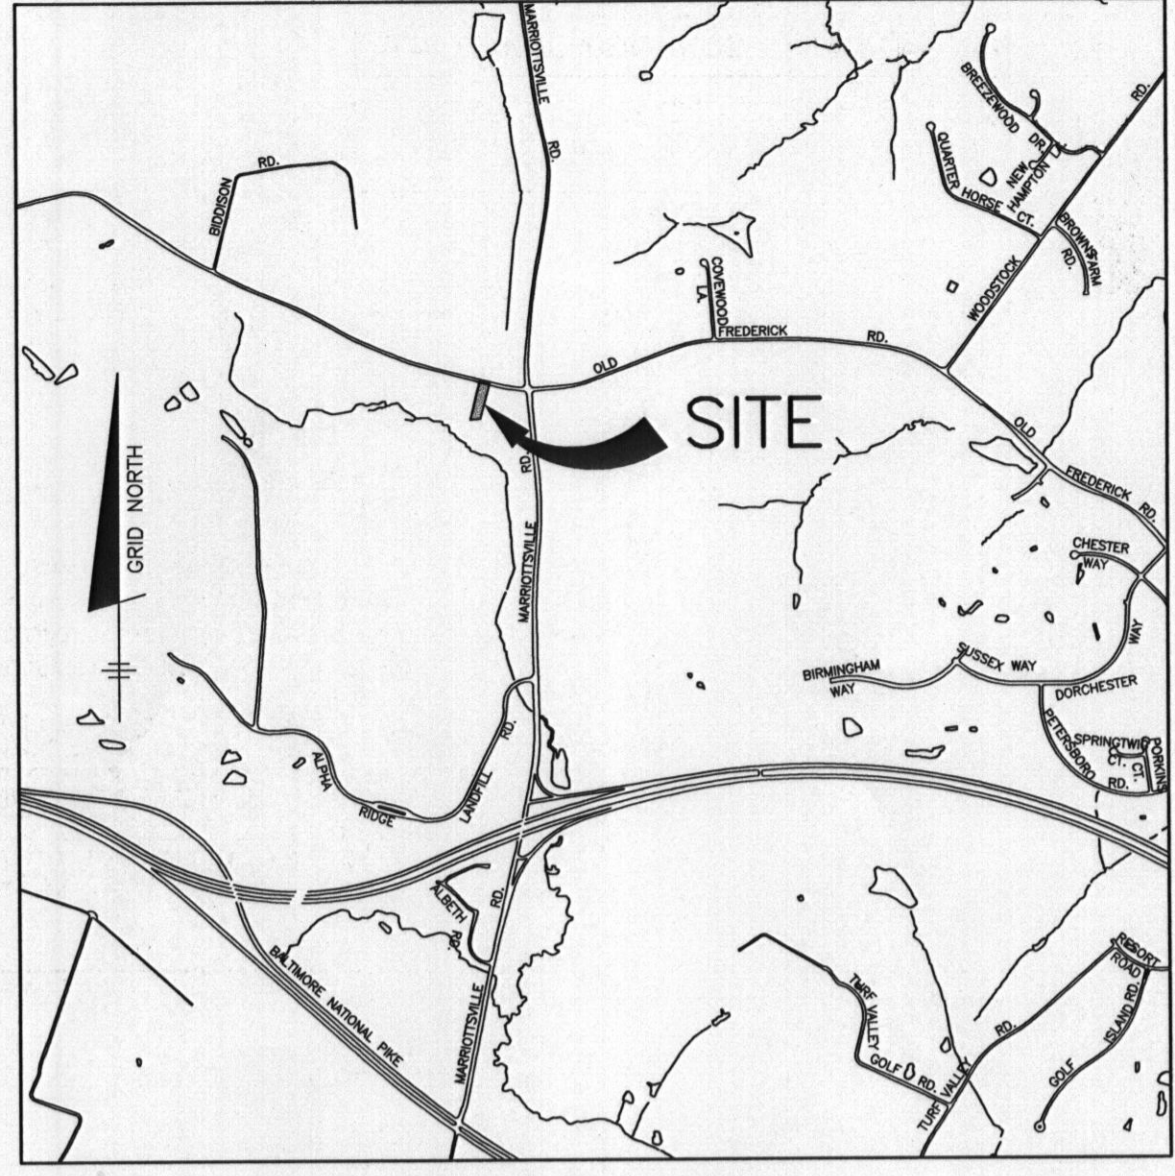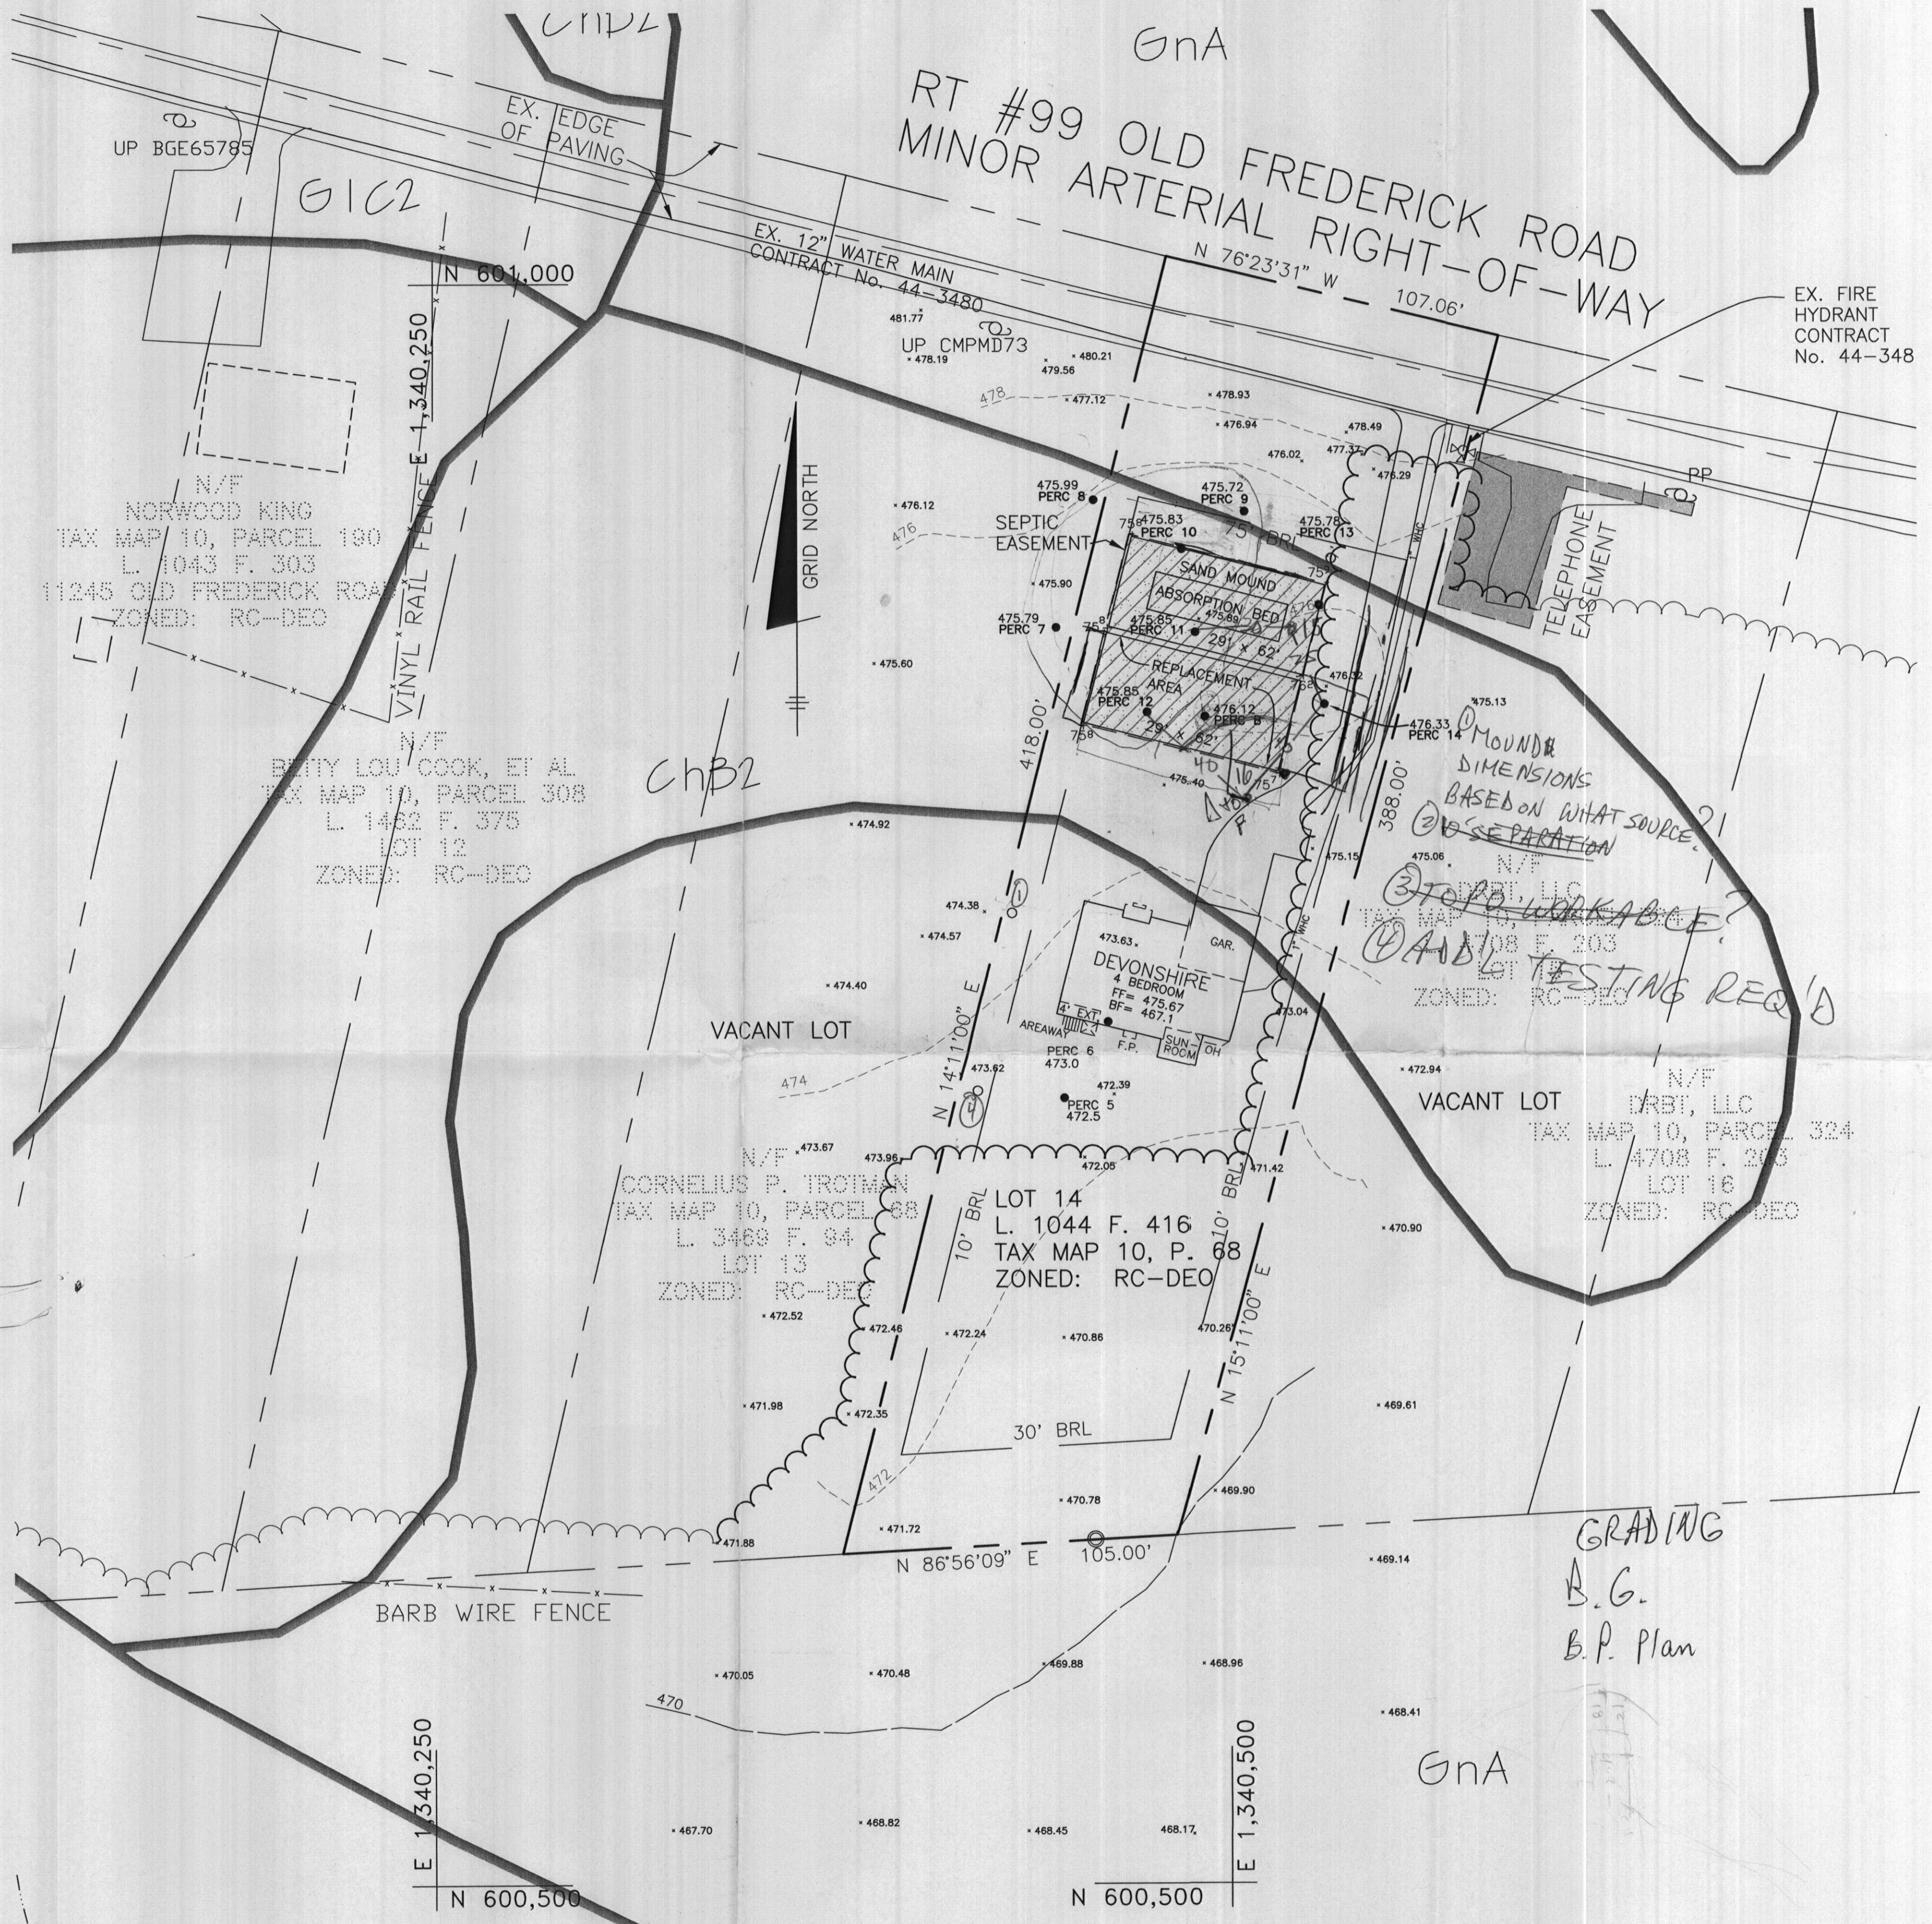

**GENERAL NOTES**

- 1.) THE LOT SHOWN HEREON WAS CREATED BY DEED PRIOR TO 1972.
- 2.) TOPOGRAPHY SHOWN IS BASED ON INFORMATION FROM DIGITAL GIS TOPOGRAPHY PURCHASED FROM HOWARD COUNTY AND WAS FIELD VERIFIED BY BENCHMARK ENGINEERING, INC. IN OCTOBER, 2003.
- 3.) THERE ARE NO EXISTING WELLS OR SEPTIC SYSTEMS WITHIN 100' OF THE PROPERTY BOUNDARY EXCEPT AS NOTED.
- 4.) SAND MOUND DESIGN PLAN SHALL BE APPROVED PRIOR TO ISSUANCE OF A BUILDING PERMIT.

I CERTIFY THAT THE INFORMATION SHOWN HEREON IS BASED ON FIELD WORK PERFORMED BY ME OR UNDER MY DIRECT SUPERVISION, AND IS CORRECT, TO THE BEST OF MY KNOWLEDGE AND BELIEF.

*Chris Malagari*  
CHRIS MALAGARI  
PLAN PREPARER

APPROVED FOR PUBLIC WATER AND PRIVATE SEWERAGE SYSTEM  
HOWARD COUNTY HEALTH DEPARTMENT

HOWARD COUNTY HEALTH OFFICER \_\_\_\_\_ DATE \_\_\_\_\_

**BENCHMARK**  
ENGINEERS • LAND SURVEYORS • PLANNERS  
**ENGINEERING, INC.**

8480 BALTIMORE NATIONAL PIKE • SUITE 418  
ELLCOTT CITY, MARYLAND 21043  
phone: 410-465-8105 • fax: 410-465-6644  
email: Benchmark@ccils.com


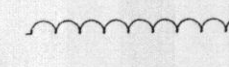
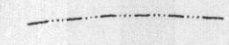
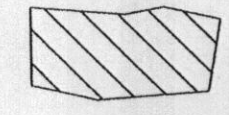

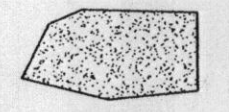
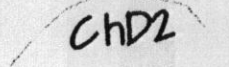
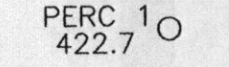
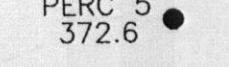
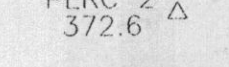
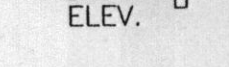
BUILDER: CORNERSTONE HOLDINGS, LLC 9695 NORFOLK AVENUE LAUREL, MD 20723 410-792-2565		PROJECT: WILLIAMS PROPERTY LOT 14 LIBER 1044, FOLIO 416	
LOCATION: TAX MAP: 10, GRID: 22 PARCEL: 68 THIRD ELECTION DISTRICT HOWARD COUNTY, MARYLAND		TITLE: PERCOLATION CERTIFICATION PLAN PLAN IDENTIFICATION NUMBER PC 519038	
DATE: NOVEMBER, 2003	PROJECT NO. 1689	SCALE: 1" = 30'	SHEET 1 OF 1
DES: JMC	DRAFT: JMC	CHECK: CAM	


SOILS LEGEND	
MAP SYMBOL SOIL GROUP	SOIL TYPE
ChB2	B CHESTER SILT LOAM, 3 TO 8 PERCENT SLOPES, MODERATELY ERODED
GnA	G# GLENVILLE SILT LOAM, 0 TO 3 PERCENT SLOPES
* INDICATES HYDRIC SOILS	
TAKEN FROM SOIL SURVEY, HOWARD COUNTY, MARYLAND (ISSUED JULY 1968) MAP NO. 31	

PLAN VIEW  
SCALE: 1" = 30'

Handwritten notes: "52", "51", "50", "1", "0"

**LEGEND**

-  EXISTING CONTOURS (5' INTERVALS)
-  EXISTING TREELINE
-  CL. STREAM
-  PROPOSED SEWAGE DISPOSAL AREA
-  WELL 1500 S.F. WELL AREA
-  PROPOSED SAND MOUND SYSTEM
-  SOILS DELINEATION LINE
-  PERC 1 422.7 PERC FAILED LOCATION
-  PERC 5 372.6 PERC PASSED LOCATION
-  PERC 2 372.6 PERC STAKED BUT NOT DUG LOCATION
-  PERC 11 11 PERC TO BE TESTED ELEV.

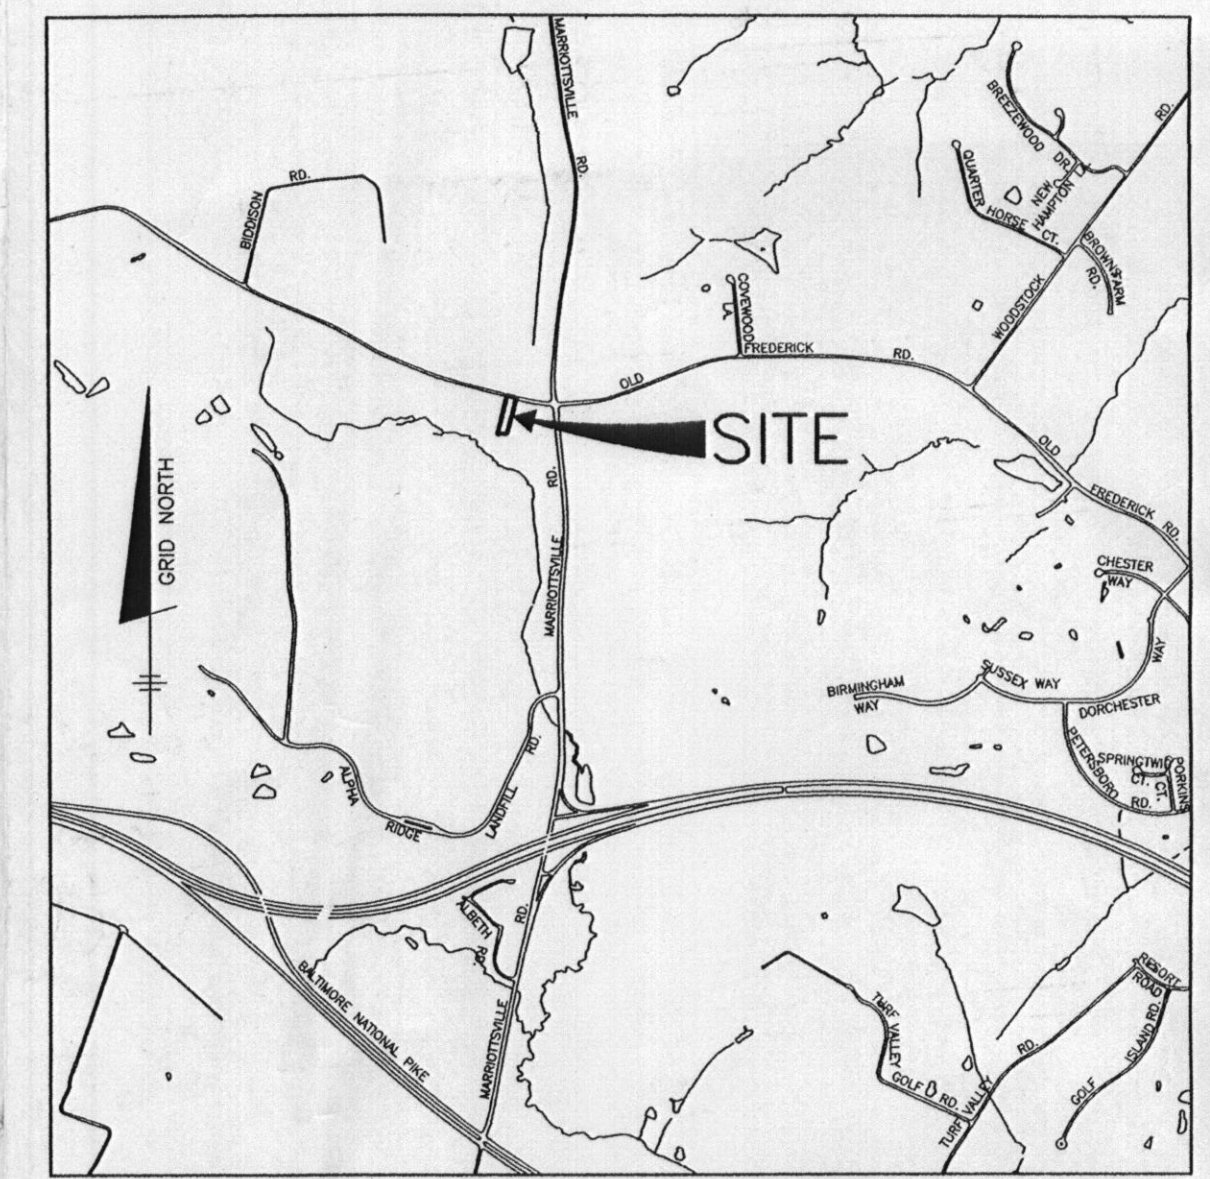

VICINITY MAP  
SCALE: 1" = 2000'

**GENERAL NOTES**

- 1.) THE LOT SHOWN HEREON WAS CREATED BY DEED, PRIOR TO 1972.
- 2.) TOPOGRAPHY SHOWN IS BASED ON INFORMATION FROM DIGITAL GIS TOPOGRAPHY PURCHASED FROM HOWARD COUNTY.
- 3.) THERE ARE NO EXISTING WELLS OR SEPTIC SYSTEMS WITHIN 100' OF THE PROPERTY BOUNDARY EXCEPT AS NOTED.

I CERTIFY THAT THE INFORMATION SHOWN HEREON IS BASED ON FIELD WORK PERFORMED BY ME OR UNDER MY DIRECT SUPERVISION, AND IS CORRECT, TO THE BEST OF MY KNOWLEDGE AND BELIEF.

*John M. Carney*  
JOHN M. CARNEY  
PLAN PREPARER

APPROVED FOR PUBLIC WATER AND PRIVATE SEWAGE SYSTEM  
HOWARD COUNTY HEALTH DEPARTMENT

HOWARD COUNTY HEALTH OFFICER \_\_\_\_\_ DATE \_\_\_\_\_

**BENCHMARK**  
ENGINEERS • LAND SURVEYORS • PLANNERS  
**ENGINEERING, INC.**



8480 BALTIMORE NATIONAL PIKE • SUITE 418  
ELLICOTT CITY, MARYLAND 21043  
PHONE: 410-465-6105 • FAX: 410-465-6644  
EMAIL: Benchmark@ccs.com

BUILDER:  CORNERSTONE HOLDINGS, LLC 9695 NORFOLK AVENUE LAUREL, MD 20723 410-792-2565		PROJECT: <b>WILLIAMS PROPERTY</b>  LOT 14 LIBER 1044, FOLIO 416	
LOCATION:  TAX MAP- 10, GRID: 22 PARCEL 68 THIRD ELECTION DISTRICT HOWARD COUNTY, MARYLAND		TITLE: <b>PERCOLATION TESTING PLAN</b>	
DATE: SEPTEMBER, 2003	PROJECT NO. 1689	DES: JMC	DRAFT: JMC
SCALE: 1" = 50'	SHEET 1 OF 1	CHECK: CAM	

SOILS LEGEND	
MAP SYMBOL SOIL GROUP	SOIL TYPE
CHB2 B	CHESTER SILT LOAM, 3 TO 8 PERCENT SLOPES, MODERATELY ERODED
GnA C*	GLENVILLE SILT LOAM, 0 TO 3 PERCENT SLOPES
* INDICATES HYDRIC SOILS	
TAKEN FROM SOIL SURVEY, HOWARD COUNTY, MARYLAND (ISSUED JULY 1968) MAP NO. 31	

**LEGEND**

- SOILS CLASSIFICATION AbC1
- SOILS DELINEATION
- EXISTING CONTOURS
- EXISTING WOODS LINE
- PROPOSED WOODS LINE
- PROPOSED STRUCTURE
- PERC. TEST - FAILED
- PERC. TEST - PASSED
- APPROVED PRIVATE SEWERAGE EASEMENT
- EX. FIELD-SHOT ELEVATION +99.9

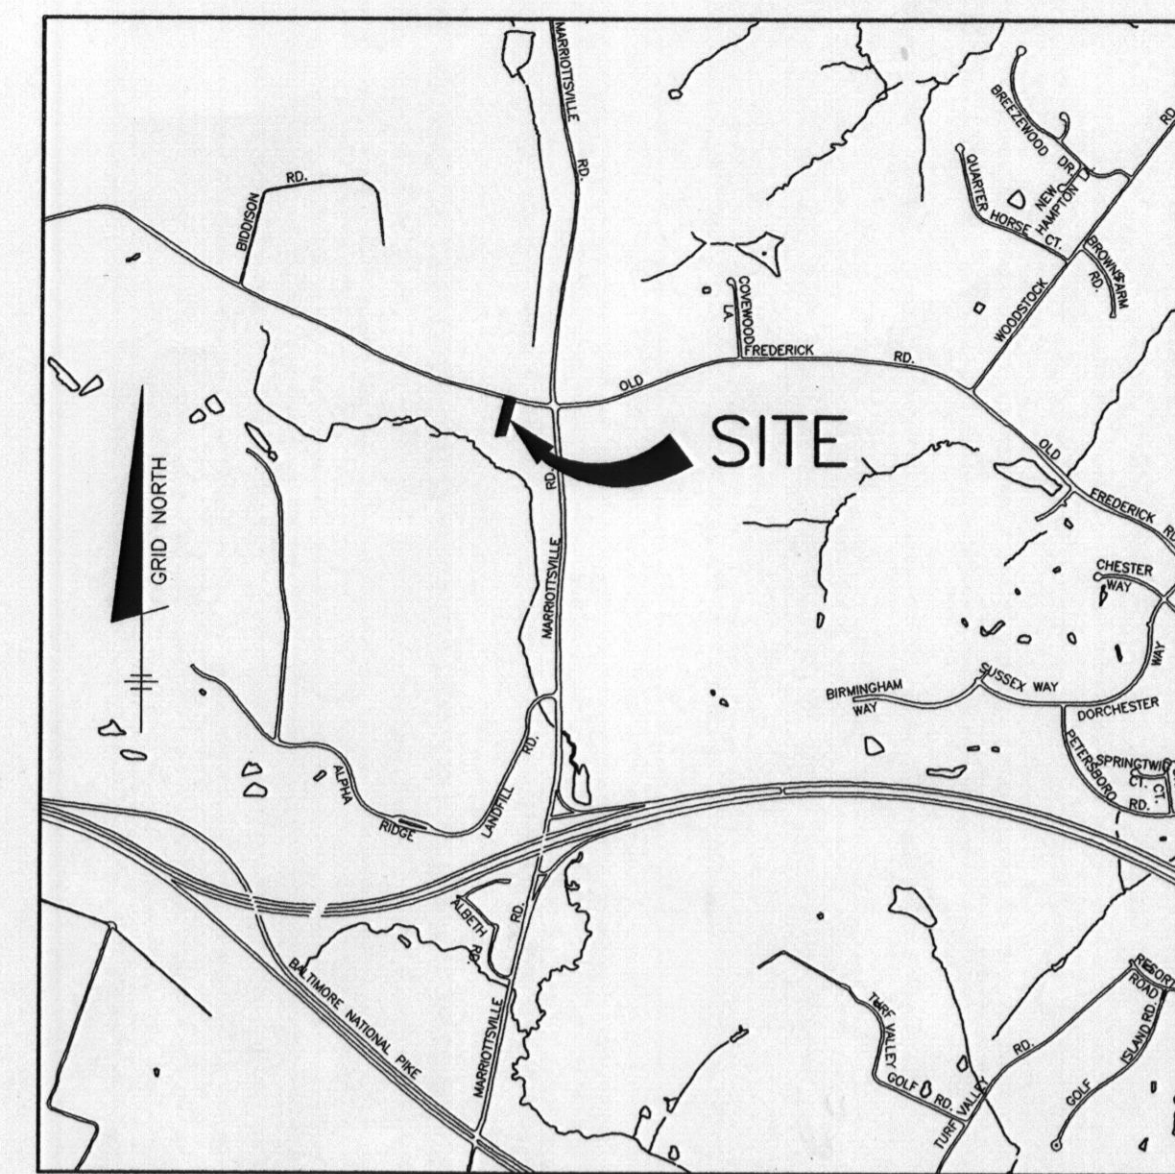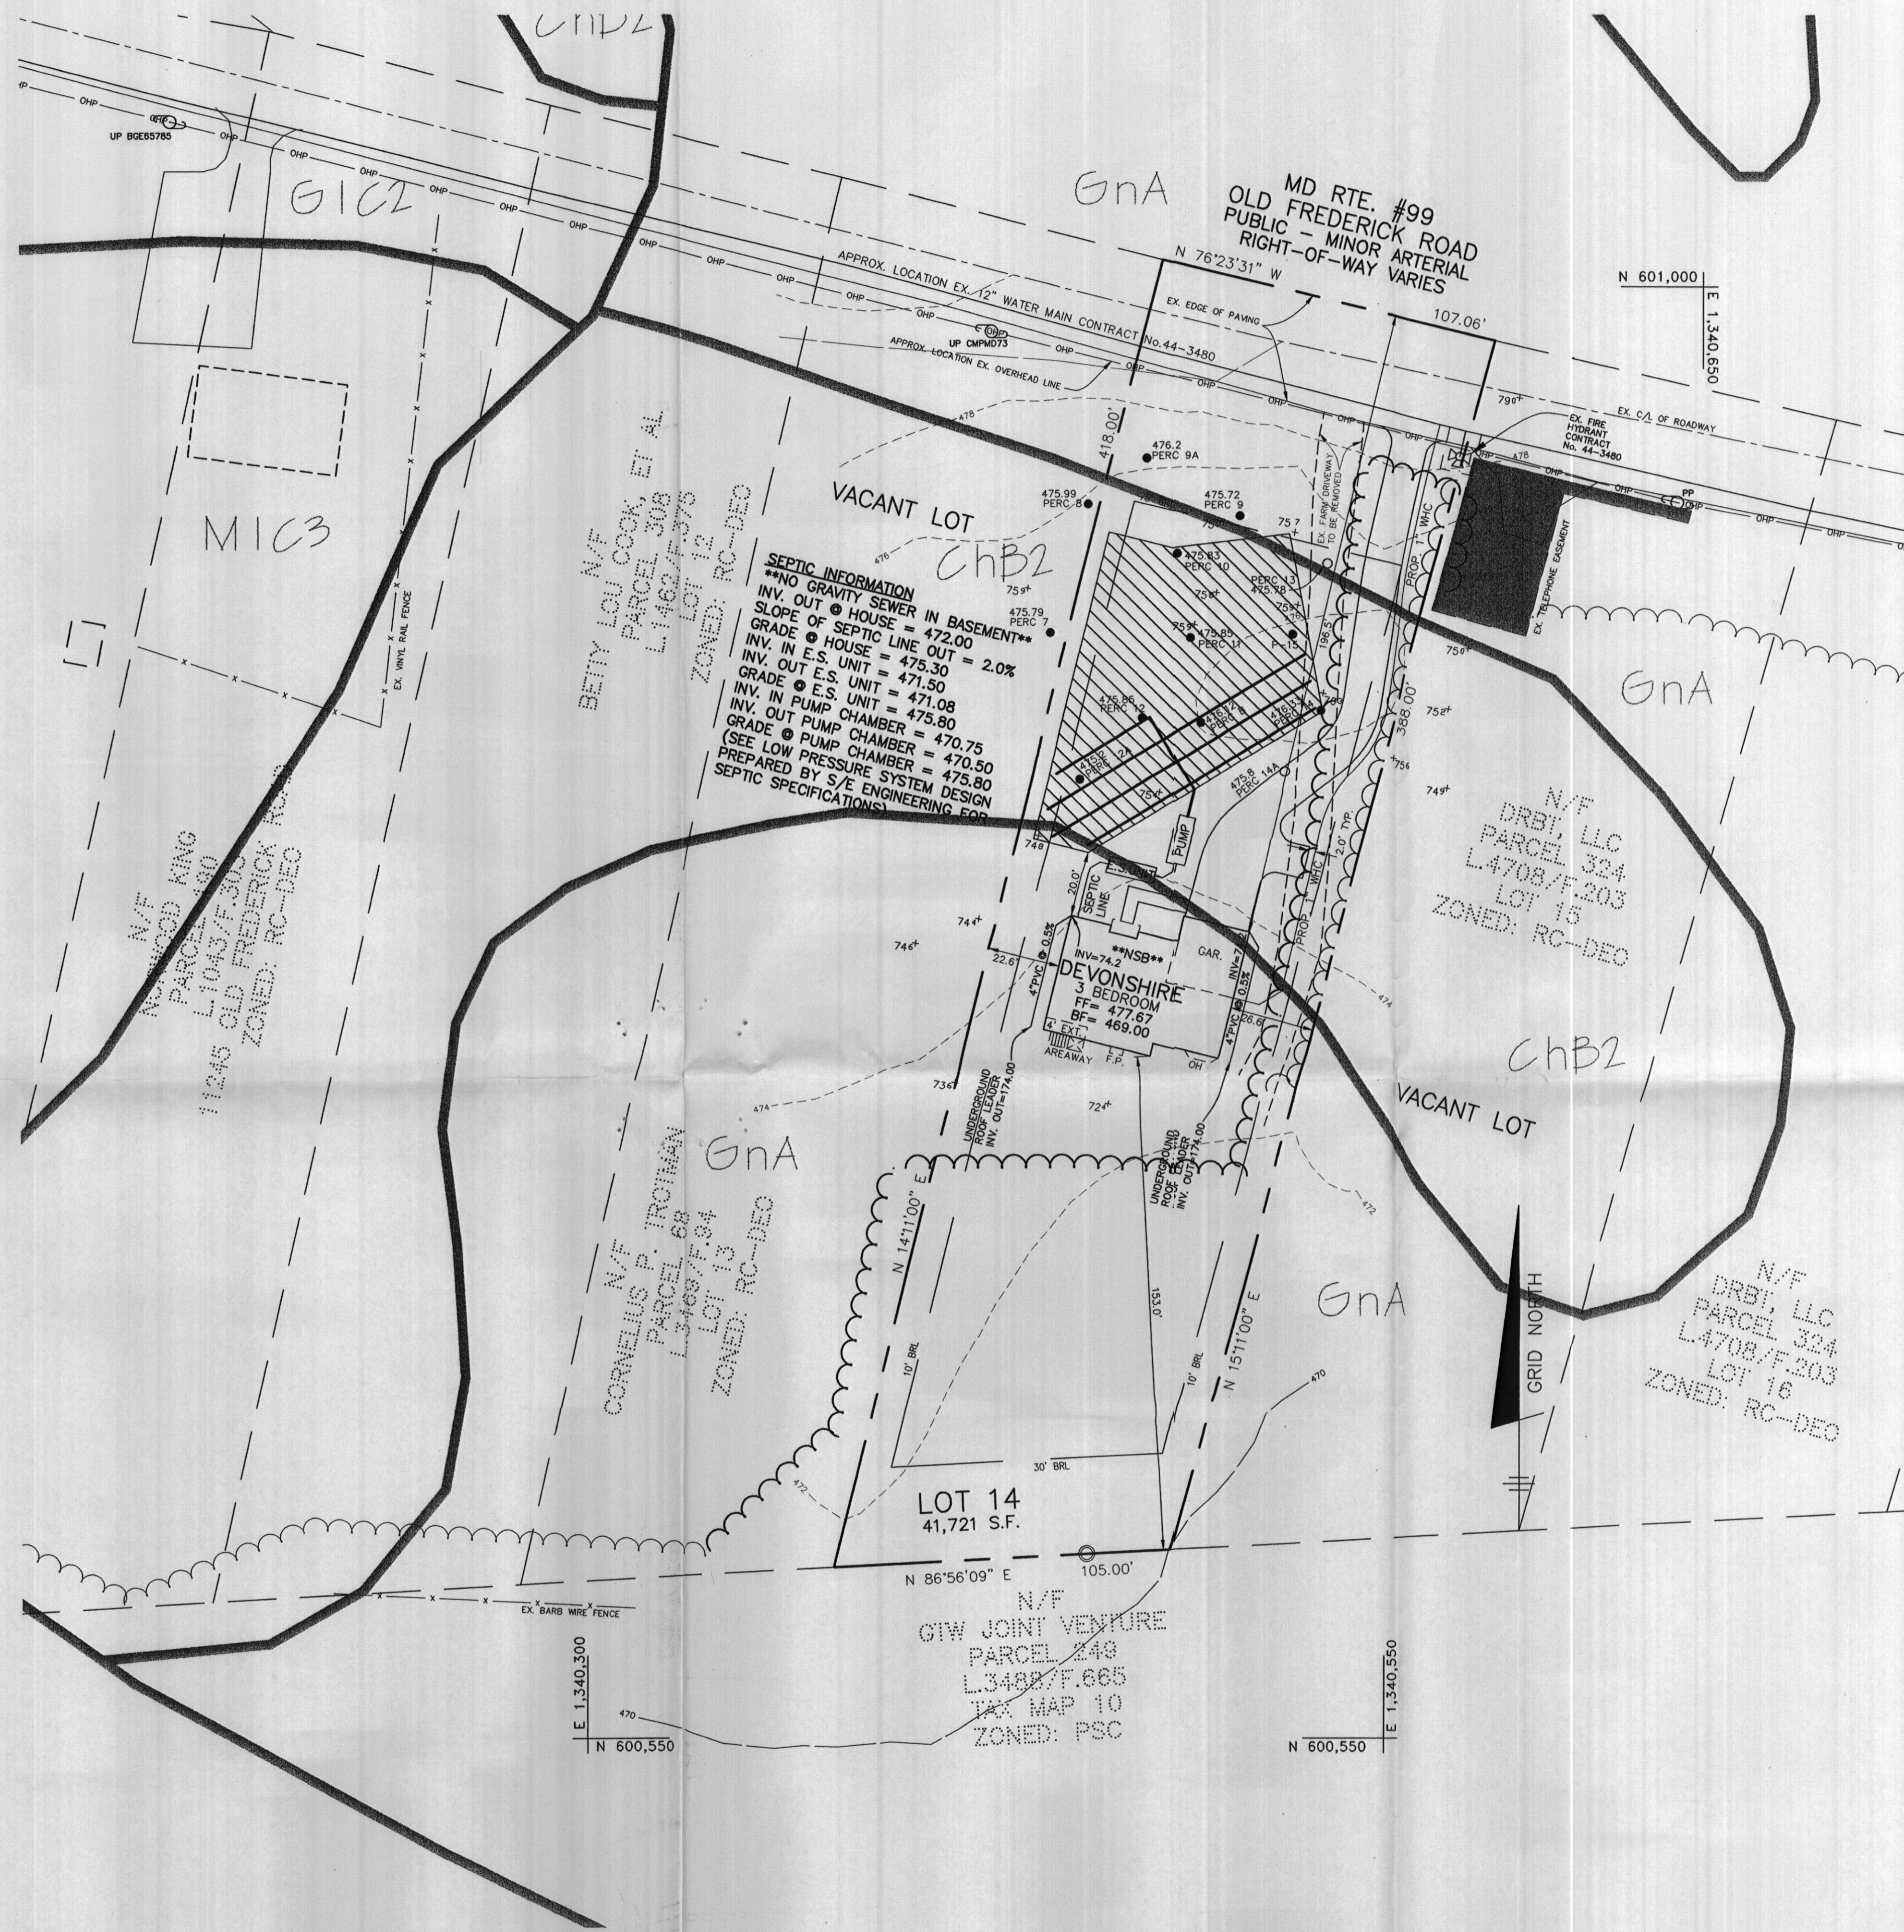

**GENERAL NOTES**

- 1.) THE LOT SHOWN HEREON WAS CREATED BY DEED PRIOR TO 1972.
- 2.) TOPOGRAPHY SHOWN WAS FIELD VERIFIED BY BENCHMARK ENGINEERING INC. IN OCTOBER, 2003 AND AGAIN IN MARCH 2004.
- 3.) THERE ARE NO KNOWN EXISTING WELLS OR SEPTIC SYSTEMS WITHIN 100' OF THE PROPERTY BOUNDARY EXCEPT AS NOTED.
- 4.) WATER SUPPLY SHALL BE PUBLIC AND IS TO BE PROVIDED BY A 1" SUPPLY LINE FROM EX. CONTR. NO.44-3480
- 5.) THE SEPTIC SYSTEM DESIGNED FOR THIS LOT IS PROPOSED TO BE A LOW PRESSURE DOSE SYSTEM. FOR DESIGN INFORMATION, SEE PLAN PLAN PREPARED BY S/E ENGINEERING, INC.
- 6.) SPOIL FROM THE TRENCHING OF THE SEPTIC AREA IS TO BE PLACED ON THE UPHILL SIDE OF THE EXCAVATION.
- 7.) ALL SEDIMENT AND EROSION CONTROL FEATURES USED ON THIS SITE SHALL COMPLY WITH THE 1994 MARYLAND STANDARDS AND SPECIFICATIONS FOR SOIL EROSION AND SEDIMENT CONTROL.
- 8.) THIS AREA DESIGNATES A PRIVATE SEWERAGE EASEMENT AS REQUIRED BY THE MARYLAND STATE DEPARTMENT OF THE ENVIRONMENT FOR INDIVIDUAL SEWERAGE DISPOSAL IMPROVEMENTS OF ANY NATURE IN THIS AREA ARE RESTRICTED UNTIL PUBLIC SEWER IS AVAILABLE. THIS EASEMENT SHALL BECOME NULL AND VOID UPON CONNECTION TO A PUBLIC SEWER SYSTEM. THE COUNTY HEALTH OFFICER SHALL HAVE THE AUTHORITY TO GRANT ADJUSTMENTS TO THE PRIVATE SEWERAGE EASEMENT. RECORDATION OF A MODIFIED SEWERAGE EASEMENT PLAT SHALL NOT BE REQUIRED.
- 9.) SEPTIC EASEMENT IS TO BE FENCED PRIOR TO BUILDING PERMIT ISSUANCE.

I CERTIFY THAT THE INFORMATION SHOWN HEREON IS BASED ON FIELD SURVEY WORK PERFORMED BY ME OR UNDER MY DIRECT SUPERVISION, AND IS CORRECT, TO THE BEST OF MY KNOWLEDGE AND BELIEF.

*Donald Mason Helms*  
DONALD MASON  
PLAN PREPARER

APPROVED FOR PUBLIC WATER AND PRIVATE SEWERAGE SYSTEM  
HOWARD COUNTY HEALTH DEPARTMENT

*Robert J. Walby* 7/27/04  
FOR HOWARD COUNTY HEALTH OFFICER JAB DATE

**BENCHMARK**  
ENGINEERS & LAND SURVEYORS & PLANNERS  
**ENGINEERING, INC.**

8480 BALTIMORE NATIONAL PIKE SUITE 418  
ELLCOTT CITY, MARYLAND 21043  
PHONE: 410-465-6105 FAX: 410-465-6644  
WWW.BEI-CIVILENGINEERING.COM

BUILDER:  CORNERSTONE HOLDINGS, LLC 9695 NORFOLK AVENUE LAUREL, MD 20723 410-792-2565		PROJECT: <b>WILLIAMS PROPERTY</b>  LOT 14 LIBER 1044, FOLIO 416	
DATE: JULY, 2004		LOCATION: TAX MAP: 10, GRID: 22 PARCEL: 68 THIRD ELECTION DISTRICT HOWARD COUNTY, MARYLAND	
DES: CAM		TITLE: PERCOLATION CERTIFICATION PLAN PLAN IDENTIFICATION NUMBER PC 519038	
DRAFT: EDD		SHEET 1 OF 1	
CHECK: CAM		SCALE: 1" = 30'	
		PROJECT NO. 1689	

SOILS LEGEND	
MAP SYMBOL SOIL GROUP	SOIL TYPE
ChB2	B CHESTER SILT LOAM, 3 TO 8 PERCENT SLOPES, MODERATELY ERODED
GnA	C* GLENVILLE SILT LOAM, 0 TO 3 PERCENT SLOPES
* INDICATES HYDRIC SOILS	
TAKEN FROM SOIL SURVEY, HOWARD COUNTY, MARYLAND (ISSUED JULY 1988) MAP NO. 31	

PLAN VIEW  
SCALE: 1" = 30'