January 29, 1968

Mr. Claude Skinner
11 Court Place
Ellicott City, Maryland

RE: Jennings Chapel Woods

Dear Sir:

The following information will have to be printed in the margin of the final Preliminary Plat.

Lot No.	Average Percolation Time in Minutes	Maximum depth permitted for effluent pipe to enter sewage disposal area at its highest elevation with reference to existing grade at time of percolation test
1	5.25 mins.	4½ ft.
2	5.75 mins.	4½ ft.
3	13.25 mins.	4½ ft.
4	14 mins.	4½ ft.

Very truly yours,

Donald W. Monaghan,
Sanitarian

DWM:jr

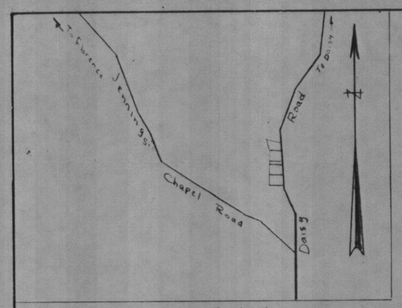

VICINITY MAP Scale: 1in. = 2000 Ft Approx.

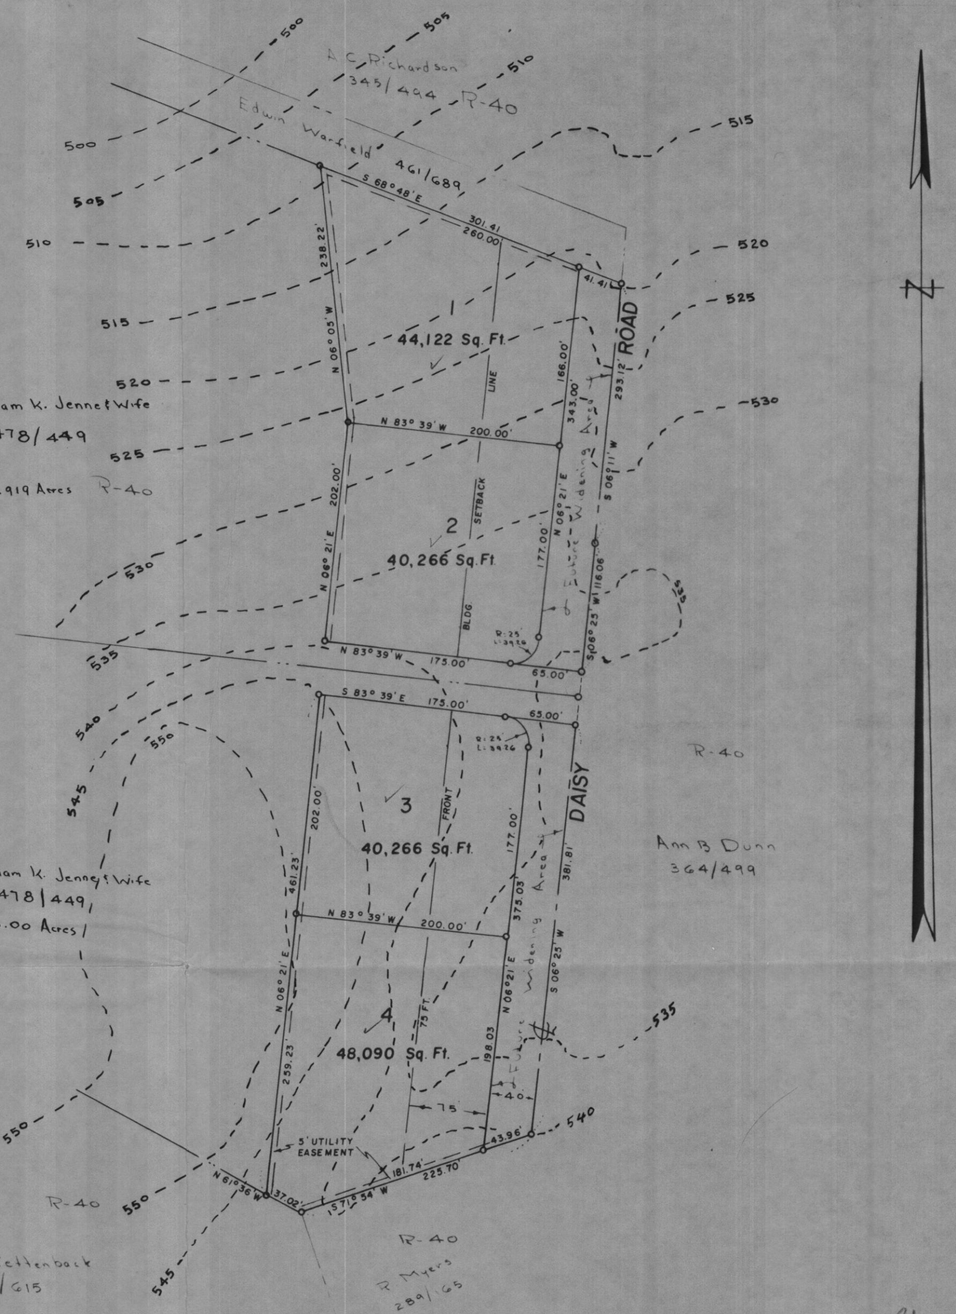

Symbol: ○ Percolation test hole

Symbol: ⊙ Sewerage disposal area 50 Ft diameter

Density: 0.992 Ac. Per lot

Total Lots: 4

Total Acres 3.97 Acres

Percolation Data

Lot No.	Average Percolation Time in minutes 2nd test	Maximum depth permitted for effluent Point to enter Sewerage Disposal area at its highest Elevation with reference to existing grade at time of percolation test
1		
2		
3		
4		

Approved for Private Water & Private Sewerage

Dr. Theodore R. Shrop
Howard County Health Officer

Date

Location Tax Map No. 20

Rt. 97 to Jennings Chapel Rd.
1st wooden piece
off Daisy Rd
on left.

Sign post
Ashton Realty Co.

Robert G. Johnson
Ashton, Md.
1-924-4811

Preliminary

Preliminary Plan
Of
Jennings Chapel Woods
Fourth Election District Of Howard County
Daisy, Maryland
Scale: 1 in. = 100 Ft August 1, 1967

Claude M. Skinner Jr.
Claude M. Skinner Jr. Reg. Engineer & Land Surveyor No. 2237
11 Court Place
Ellicott City, Md.

PROFESSIONAL ENGINEER & LAND SURVEYOR
CLAUDE M. SKINNER, JR.
No. 2237
STATE OF MARYLAND

C-2910