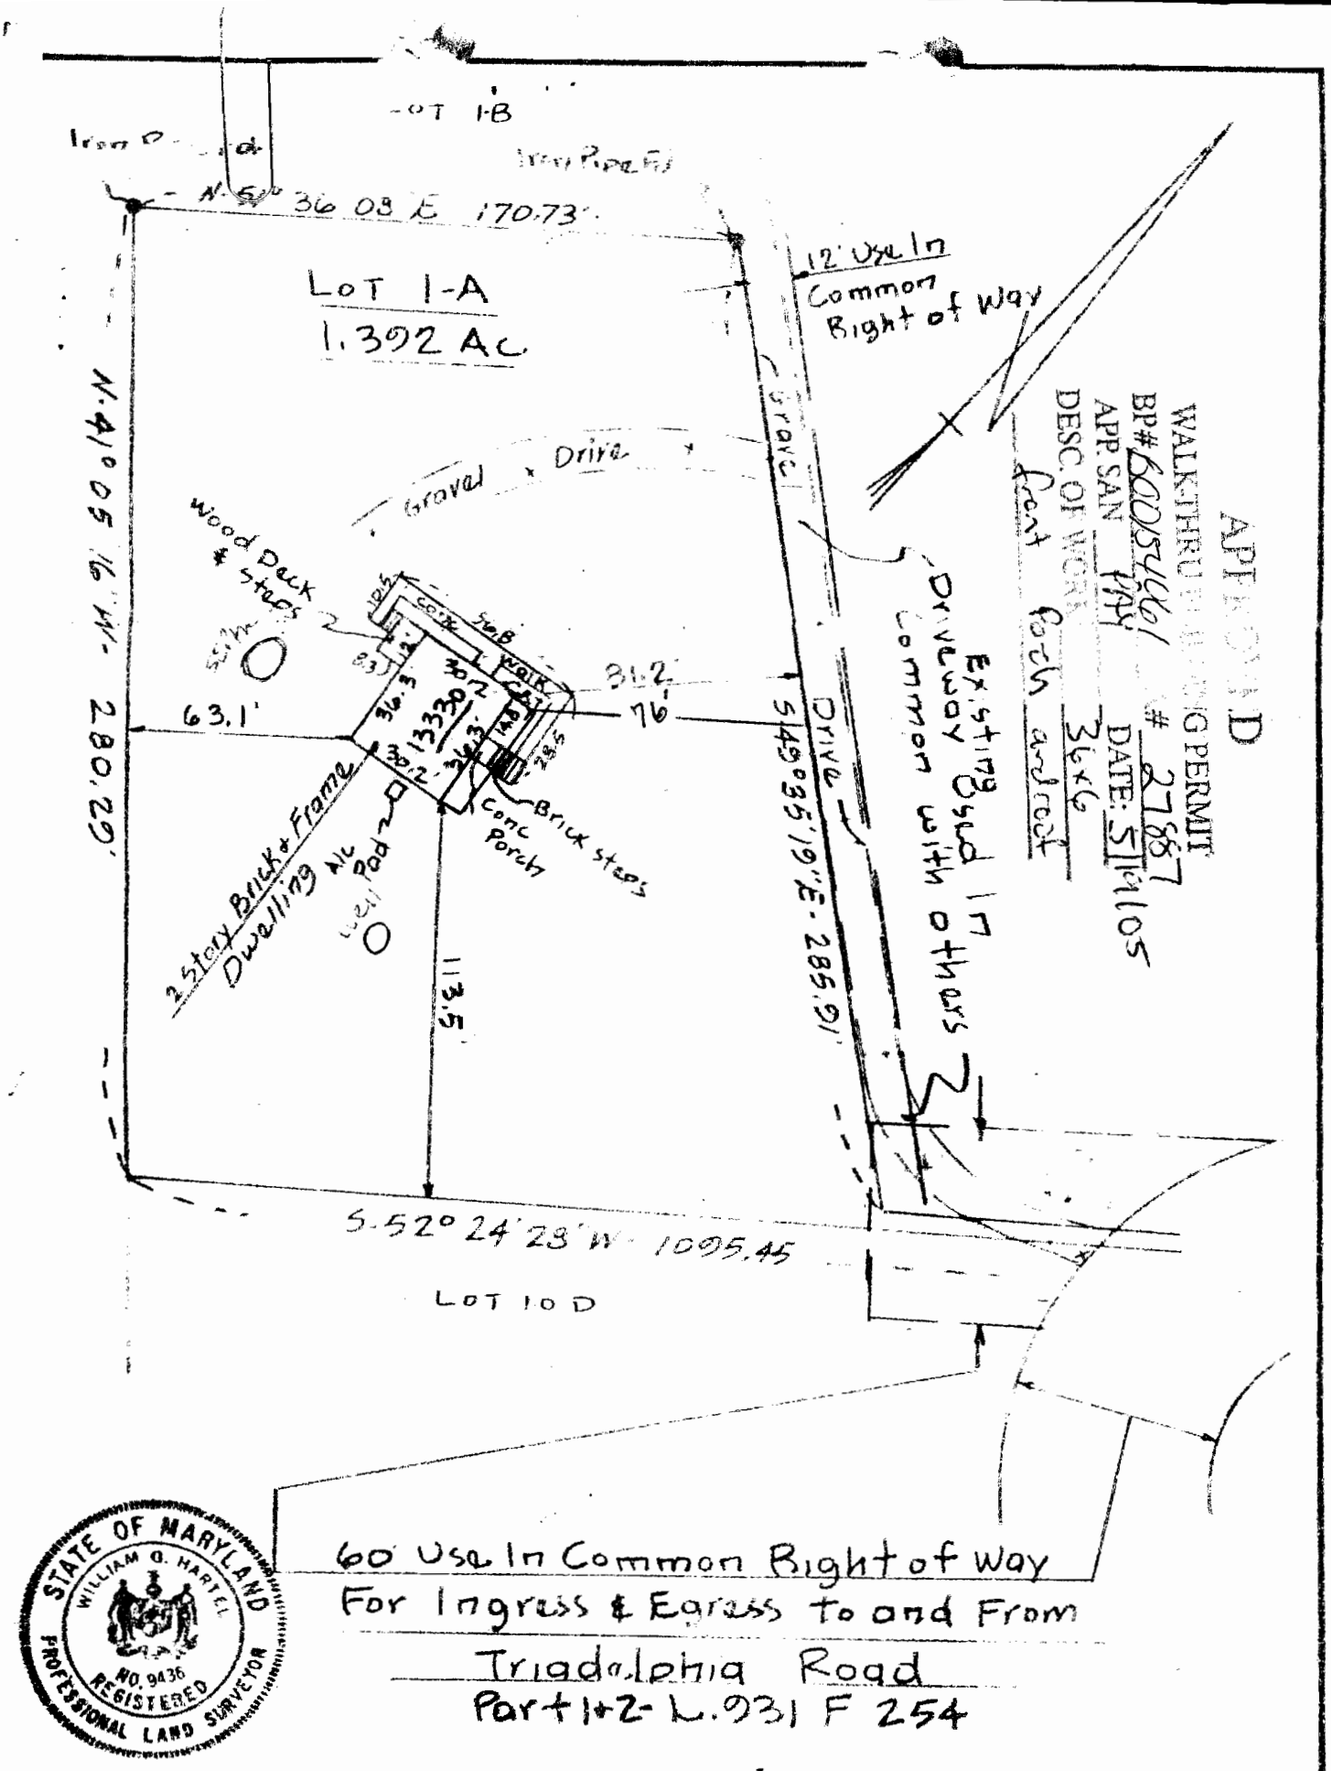

TITLE **LOCATION SURVEY**				
PROJECT LOT 1-A TRIADELPHIA FARMS II				
LOCATION 3RD ELECTION DISTRICT, HOWARD CO., MD.				
FIELD BOOK 54	PAGE NO. —	DRAWN BY: BH	CHECKED BY	DATE: 8-3-94
SCALE: 1" = 50		JOB NO.: 84211		

THE INFORMATION ON THIS PLAT SHOWS ONLY THAT THE IMPROVEMENTS INDICATED HEREON ARE CONTAINED WITHIN THE CONFINES OF THE LOT UPON WHICH THEY ARE ERECTED. THIS PLAT IS NOT TO BE CONSTRUED AS, OR USED FOR THE ESTABLISHMENT OF PROPERTY LINES.

THIS IS TO CERTIFY THAT WE HAVE CONDUCTED A LOCATION SURVEY OF THE IMPROVEMENTS AND THAT THEY ARE LOCATED AS SHOWN HEREON.

SIGNATURE William G. Hartel

REG. NO. 9436 DATE 8-8-94

boender associates inc.
consulting engineers
land surveyors
land planners
COURT HOUSE SQUARE • ELLICOTT CITY, MD. 21043
(301) 465-7777