Walk Thru

DEPT. OF INSPECTIONS, LICENSES AND PERMITS
3430 COURT HOUSE DRIVE
ELLICOTT CITY, MD 21043
PERMITS (410) 313-2455
INSPECTIONS (410) 313-1810
AUTOMATED INFORMATION (410) 313-3800

HOWARD COUNTY PERMIT APPLICATION

PERMIT NUMBER

Building Address 14841 MERIWEATHER DR LAUREL, MD

Suite/Apt. #: _____ SDP/WP/Petition #: _____

Census Tract _____ Subdivision _____

Section _____ Area _____ Lot 13

Tax Map _____ Parcel _____ Grid _____

Zoning Map Coordinates Lot Size

Existing Use SFD
Proposed Use SAME W/ DECK
Estimated Construction Cost $ 27000
Description of Work BUILD 600 ± DECK IRR SHAPE W/ STAIRS

Occupant or Tenant _____

Contact Name _____

Address _____

City _____ State _____ Zip Code _____

Phone _____ Fax _____

Property Owner's Name BLUE BARNEY
Address 14841 Meriwether Drive
City Glenelg State MD Zip Code 21737
Home Phone _____ Work Phone _____
Applicant's Name & Mailing Address, (if other than stated herein):

Phone _____ Fax _____

Contractor Company MCWHORTER OUTDOOR LIVING
Contact Person RYAN MCWHORTER
Address 6851 REDBERRY RD
City CLARKSVILLE State MD Zip Code 21029
License No. 91651
Phone 4109845880 Fax _____

Engineer or Architect Company _____

Contact Person _____

Address _____

City _____ State _____ Zip Code _____

Phone _____ Fax _____

BUILDING DESCRIPTION – *COMMERCIAL*

Building Characteristics

Height:

No. of stories:

Gross area, sq. ft. per floor:

Use group:

Construction type:
____ Reinforced Concrete
____ Structural Steel
____ Masonry
____ Wood Frame

____ State Certified Modular

Utilities

Water Supply:
____ Public
____ Private
Sewage Disposal:
____ Public
____ Private

Electric Yes ☐ No ☐
Gas Yes ☐ No ☐

Heating System:
Electric ☐ Oil ☐
Natural Gas ☐
Propane Gas ☐

Sprinkler system: N/A ☐
____ Full
____ Partial
____ Other Suppression
____ # of Heads

BUILDING DESCRIPTION – *RESIDENTIAL*

Building Characteristics

SF Dwelling ☐ SF Townhouse ☐

Depth Width

1st floor:
2nd floor:
Basement:

Finished Basement ☐ Unfinished Basement ☐ Crawl space ☐ Slab on Grade ☐

No. of Bedrooms _____

Multi-family dwellings:
No. of efficiency units: ____
No. of 1 BR units: ____
No. of 2 BR units: ____
No. of 3 BR units: ____

Other Structure: _____
Dimensions: _____
Footings: _____
Roof: _____

____ State Certified Modular
____ Manufactured Home

Utilities

Water Supply:
X Public
X Private
Sewage Disposal:
____ Public
X Private

Electric Yes ☐ No ☐
Gas Yes ☐ No ☐

Heating System:
Electric ☐ Oil ☐
Natural Gas ☐
Propane Gas ☐

Sprinkler system: N/A ☐
____ NFPA #13D
____ NFPA #13R
____ Other:

THE UNDERSIGNED HEREBY CERTIFIES AND AGREES AS FOLLOWS: (1) THAT HE/SHE IS AUTHORIZED TO MAKE THIS APPLICATION: (2) THAT THE INFORMATION IS CORRECT; (3) THAT HE/SHE WILL COMPLY WITH ALL REGULATIONS OF HOWARD COUNTY WHICH ARE APPLICABLE THERETO; (4) THAT HE/SHE WILL PERFORM NO WORK ON THE ABOVE REFERENCED PROPERTY NOT SPECIFICALLY DESCRIBED IN THIS APPLICATION; (5) THAT HE/SHE GRANTS COUNTY OFFICIALS THE RIGHT TO ENTER ONTO THIS PROPERTY FOR THE PURPOSE OF INSPECTING THE WORK PERMITTED AND POSTING NOTICES.

RYCM
Applicant's Signature

RYAN MCWHORTER
Print Name

SALES@MCWHORTEROUTDOOR.COM
Email Address

_____
Title/Company

10/3/13
Date

Checks payable to: DIRECTOR OF FINANCE OF HOWARD COUNTY
**PLEASE WRITE NEATLY AND LEGIBLY **

FOR OFFICE USE ONLY

AGENCY	DATE	SIGNATURE APPROVAL
Land Development, DPZ		
State Highways		
Building Officials		
Dev. Engineering, DPZ		
Health	10-3-13	DBurnside
Fire Protection		

Is Sediment Control approval required prior to issuance?
YES ☐ NO ☐

CONTINGENT ON CONSTRUCTION START ☐
ONSITE SEWAGE DISPOSAL

DPZ SETBACK INFORMATION

Front: _____
Rear: _____
Side: _____
Side St.: _____

All minimum setbacks met?
YES ☐ NO ☐

Is Entrance Permit Required?
YES ☐ NO ☐
Historic District?
YES ☐ NO ☐
Lot Coverage for New Town Zone _____
SDP/Red-line approval date _____

PROPERTY ID #

Filing fee $ _____
Permit fee $ _____
Excise tax $ _____
Add'l per fee $ _____
TOTAL FEES $ _____
Subtotal $ _____
Balance due $ _____
Check # _____
Cash _____
Application # _____

Distribution of Copies: White: Building Officials Green: LDD, DPZ Yellow: DED, DPZ Pink: Health Gold: HA

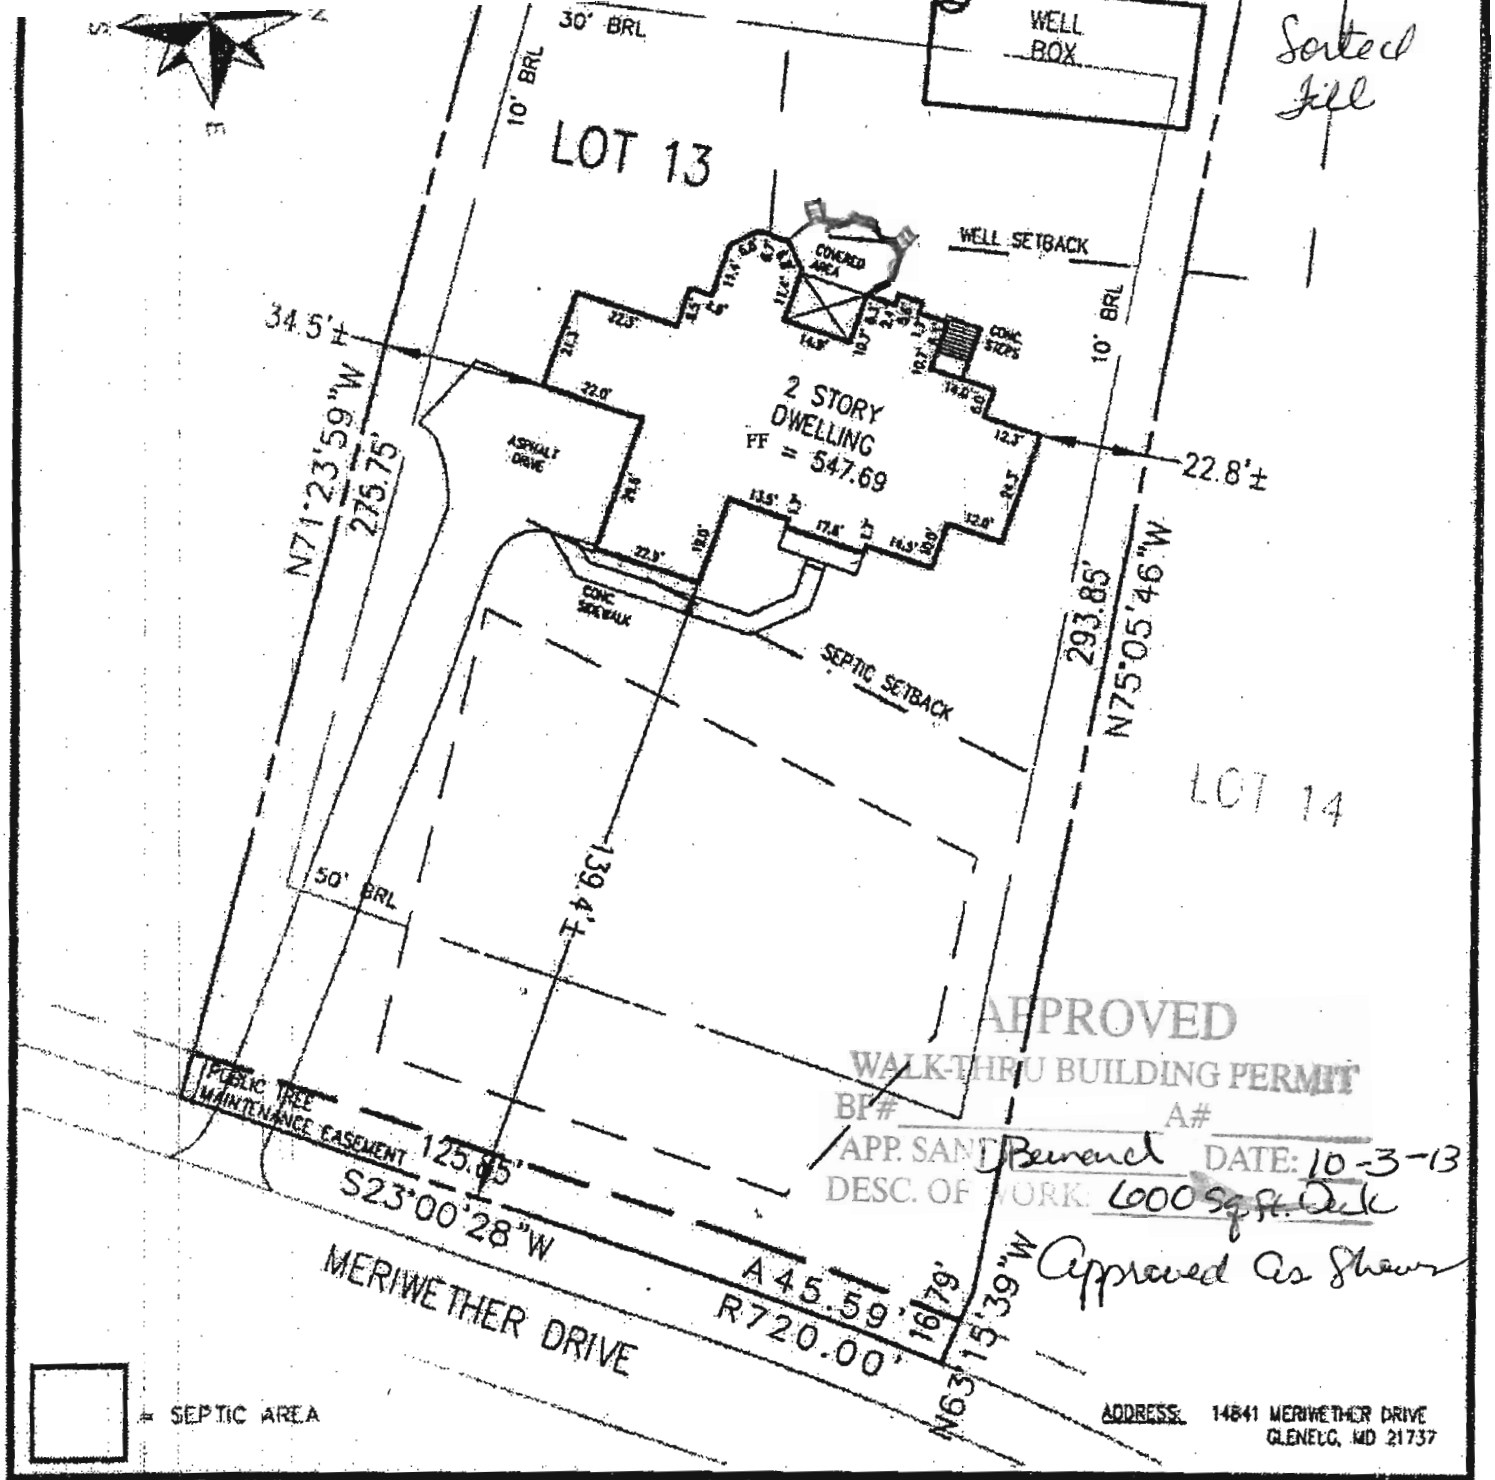

APPROVED
WALK-THRU BUILDING PERMIT
BP# A#
APP. SANT Bernard DATE: 10-3-13
DESC. OF WORK: 600 Sq ft. Deck
Approved as Shown

SURVEYOR'S CERTIFICATE

I HEREBY CERTIFY THAT THE POSITION OF THE EXISTING IMPROVEMENTS SHOWN HEREON HAVE BEEN CAREFULLY ESTABLISHED BY ACCEPTED LAND SURVEYING PRACTICES AND THAT, UNLESS SHOWN, THERE ARE NO VISIBLE ENCROACHMENTS EITHER WAY ACROSS THE PROPERTY LINES. THIS PLAN IS OF BENEFIT TO A CONSUMER ONLY INSOFAR AS IT IS REQUIRED BY A LENDER OR A TITLE INSURANCE COMPANY OR ITS AGENT IN CONNECTION WITH CONTEMPLATED TRANSFER, FINANCING, OR REFINANCING. THE PLAN IS NOT TO BE RELIED UPON FOR THE ESTABLISHMENT OR LOCATION OF FENCES, GARAGES, BUILDINGS, OR OTHER EXISTING OR FUTURE IMPROVEMENTS. THE PLAN DOES NOT PROVIDE FOR THE ACCURATE IDENTIFICATION OF PROPERTY BOUNDARY LINES, BUT SUCH IDENTIFICATION MAY NOT BE REQUIRED FOR THE TRANSFER OF TITLE OR SECURING FINANCING OR REFINANCING. THIS DRAWING WAS PREPARED W/O THE BENEFIT OF A TITLE REPORT.

SIGNATURE: MICHAEL JOE BOYCE — MD. LIC NO. 21328 — DATE 08/21/13

LOCATION DRAWING
LOT# 13
MERIWETHER FARMS
LIBER 12124, FOLIO 120
PLAT No. 21770, ET SEQ.
FOURTH ELECTION DISTRICT
HOWARD COUNTY, MARYLAND

ESE Land Planning Engineering Land Surveying
ESE Consultants Inc.
7164 Columbia Gateway Dr.
Suite 203
Columbia, MD 21046
TEL: 410-872-9105
FAX: 410-872-4870