STATE OF MARYLAND
WELL COMPLETION REPORT
FILL IN THIS FORM COMPLETELY
PLEASE PRINT OR TYPE

COUNTY NUMBER A 18779

DATE Received

DATE WELL COMPLETED 4 3 2 8 8 5

Depth of Well 140 (to nearest foot)

PERMIT NO. FROM "PERMIT TO DRILL WELL" 90-87-0908

OWNER GASCH DOUG (first name)


SUBDIVISION LAWRENCE FARMS SECTION LOT 5

WELL LOG

Not required for driven wells

STATE THE KIND OF FORMATIONS PENETRATED, THEIR COLOR, DEPTH, THICKNESS AND IF WATER BEARING

DESCRIPTION (Use additional sheets if needed)	FEET FROM	FEET TO	Check if water bearing
Topsoil	0	1	
brown shale	1	15	
brown shale	15	45	✓
brown shale	45	60	
blue shale	60	85	
brown shale	85	88	
blue shale	88	140	

GROUTING RECORD

WELL HAS BEEN GROUTED (Circle Appropriate Box) YES (Y) NO (N)

TYPE OF GROUTING MATERIAL

CEMENT (C M) BENTONITE CLAY (B C)

NO. OF BAGS 6 NO. OF POUNDS 600

GALLONS OF WATER 35

DEPTH OF GROUT SEAL (to nearest foot)

from 0 ft. (TOP) to 27 ft. (BOTTOM)

(enter 0 if from surface)

CASING RECORD

casing (type) insert appropriate code below

ST STEEL CO CONCRETE PL PLASTIC OT OTHER

MAIN CASING TYPE: ST

Nominal diameter top (main) casing (nearest inch): 6

Total depth of main casing (nearest foot): 39

OTHER CASING (if used) — EACH CASING

diameter inch	depth (feet) from	to

SCREEN RECORD

screen type or open hole — insert appropriate code below

ST STEEL BR BRASS BRONZE HO OPEN HOLE PL PLASTIC OT OTHER

C 2

EACH SCREEN

	DEPTH (nearest ft.)	
1 HO	39	140
2		
3		

SLOT SIZE 1 ____ 2 ____ 3 ____

DIAMETER OF SCREEN ____ (NEAREST INCH)

GRAVEL PACK from ____ to ____

IF WELL DRILLED WAS FLOWING WELL INSERT F IN BOX 68

OEP USE ONLY (NOT TO BE FILLED IN BY DRILLER)

F (E.R.O.S.) W Q

TELESCOPE LOG OTHER DATA

C 3

PUMPING TEST

HOURS PUMPED (nearest hour): 3

PUMPING RATE (gal. per min to nearest gal.): 5

METHOD USED TO MEASURE PUMPING RATE: Bucket

WATER LEVEL (distance from land surface)

BEFORE PUMPING: 20

WHEN PUMPING: 31

TYPE OF PUMP USED (for test)

A air P piston T turbine

C centrifugal R rotary O other (describe below)

J jet S submersible

PUMP INSTALLED

DRILLER WILL INSTALL PUMP (CIRCLE) (YES or NO) YES NO

IF DRILLER INSTALLS PUMP, THIS SECTION MUST BE COMPLETED FOR ALL WELLS EXCEPT HOME USE

TYPE OF PUMP INSTALLED PLACE (A,C,J,P,R,S,T,O) IN BOX - SEE ABOVE

CAPACITY GALLONS PER MINUTE (to nearest gallon)

PUMP HORSE POWER

PUMP COLUMN LENGTH (nearest ft.)

CASING HEIGHT (circle appropriate box and enter casing height)

+ above / − below LAND SURFACE (nearest foot)

CIRCLE APPROPRIATE LETTER

A A WELL WAS ABANDONED AND SEALED WHEN THIS WELL WAS COMPLETED

E ELECTRIC LOG OBTAINED

P TEST WELL CONVERTED TO PRODUCTION WELL

I HEREBY CERTIFY THAT THIS WELL HAS BEEN CONSTRUCTED IN ACCORDANCE WITH COMAR 10.17.13 "WELL CONSTRUCTION" AND IN CONFORMANCE WITH ALL CONDITIONS STATED IN THE ABOVE CAPTIONED PERMIT, AND THAT THE INFORMATION PRESENTED HEREIN IS ACCURATE AND COMPLETE TO THE BEST OF MY KNOWLEDGE

DRILLERS IDENT. NO. 91

DRILLERS SIGNATURE (MUST MATCH SIGNATURE ON APPLICATION)

SUPERVISOR (sign of driller or supervisor)

LOCATION OF WELL ON LOT
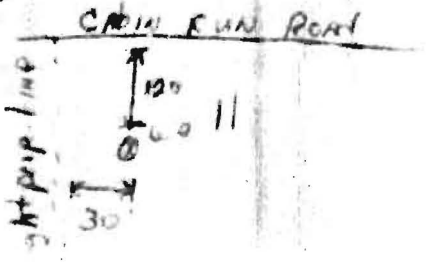
SHOW PERMANENT STRUCTURE SUCH AS BUILDING, SEPTIC TANKS, AND/OR LANDMARKS AND INDICATE NOT LESS THAN TWO DISTANCES (MEASUREMENTS TO WELL)