Book 23, Folio 67.

A13762

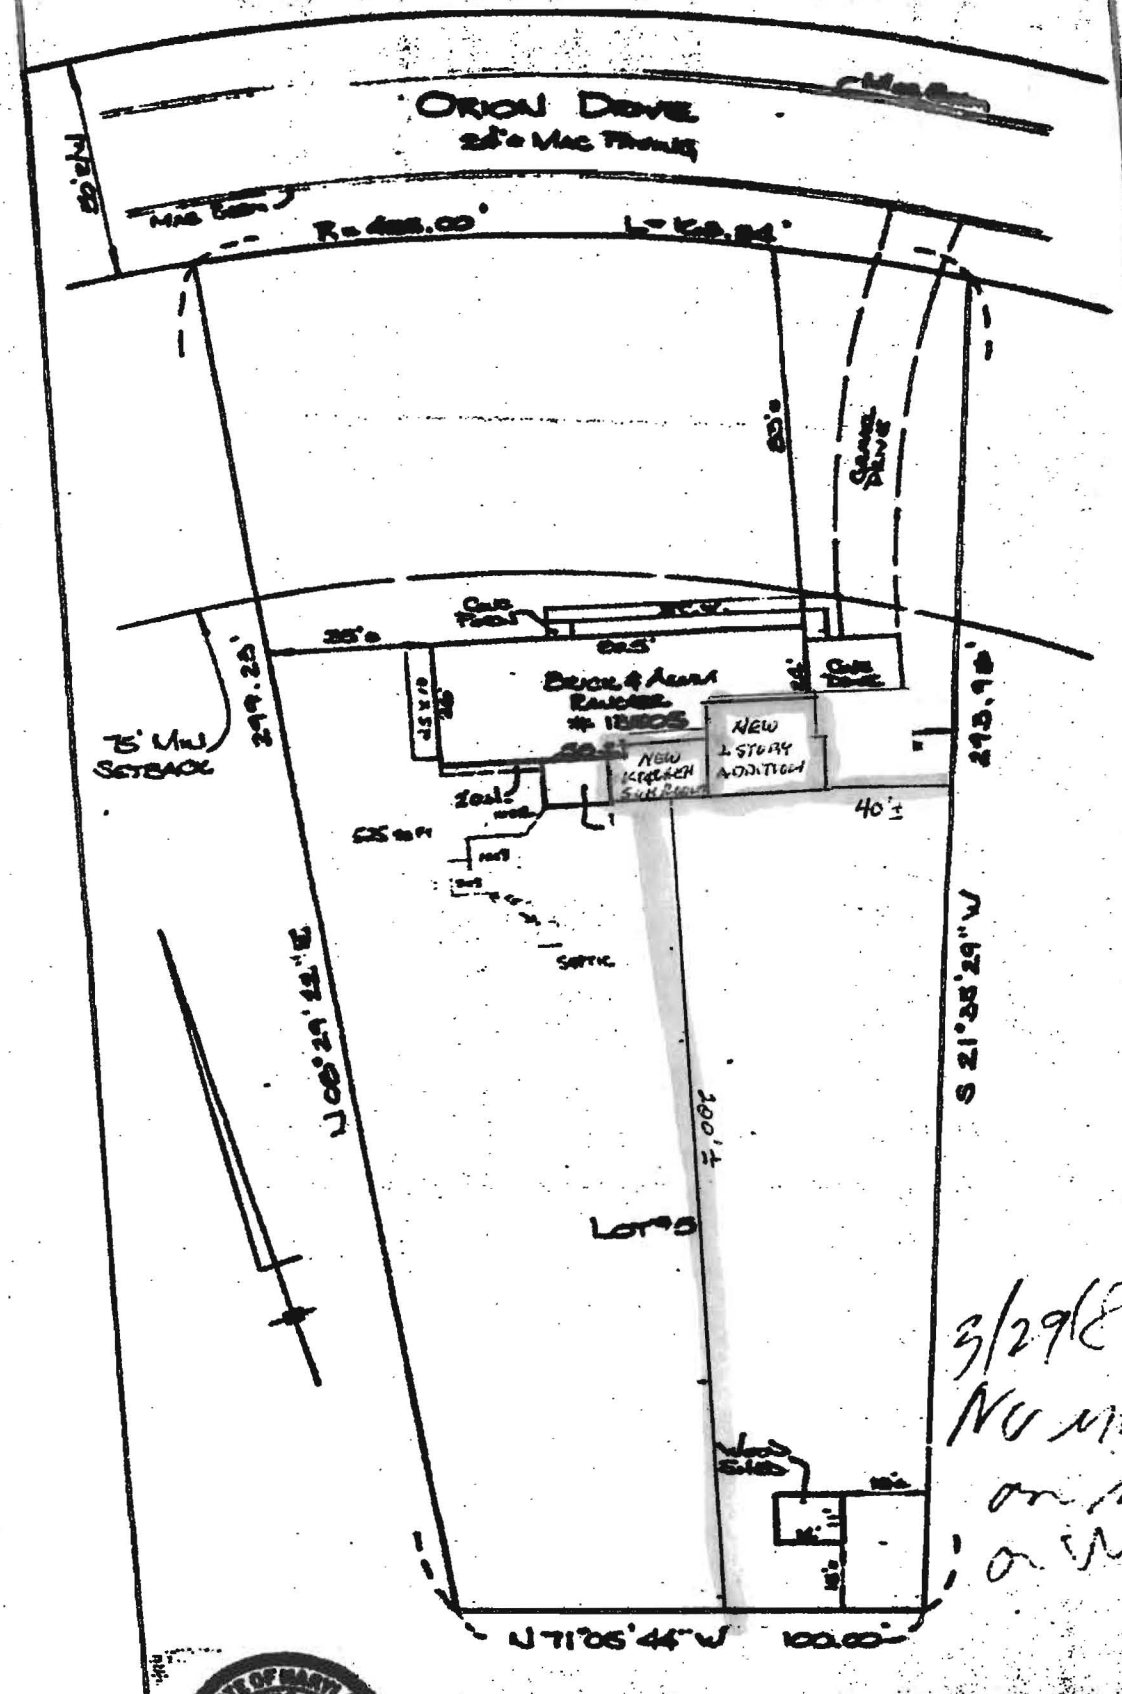

3/29/88
No impact
on septic
or well
RB