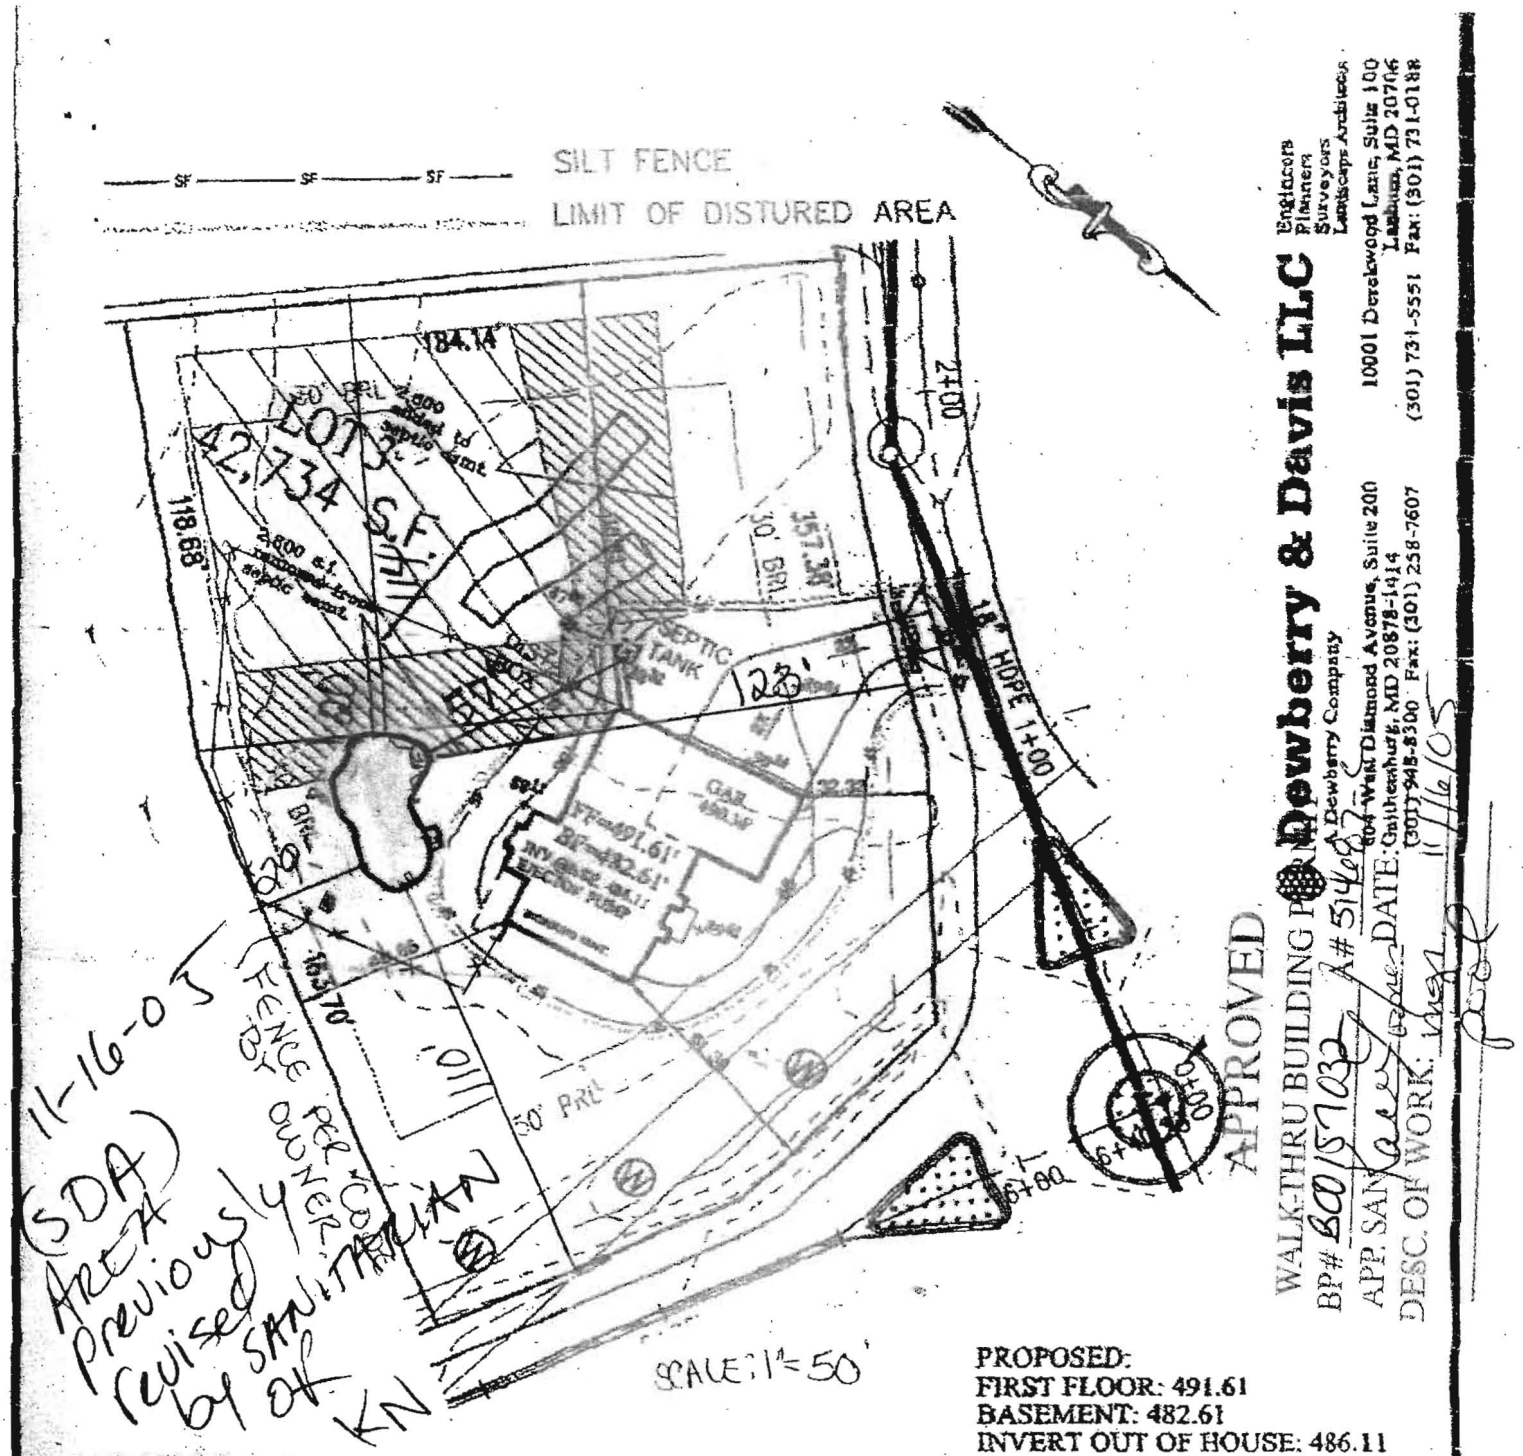

PAVING SPECIFICATION:
2' ASPHALT 4'CR-6 OR
2.5' ASPHALT 1.5' OVERLAY

GRADE@SEPTIC TANK: 488.32
GRADE@DIST.BOX: 487.88
GRADE@TRENCHES: 487.88

PROPOSED:
FIRST FLOOR: 491.61
BASEMENT: 482.61
INVERT OUT OF HOUSE: 486.11
INVERT INTO SEPTIC TANK: 485.82
INVERT INTO DIST.BOX: 485.38
INVERT INTO TRENCHES: 484.40

HOUSE MODEL LEWIS RESIDENCE	LOT 3, PINDELL WOODS LOTS 1 THRU 47 AND PRESERVATION PARCELS A THRU F	PLOT PLAN SINGLE FAMILY DWELLING
DATE: AUGUST 6, 2002 SCALE: 1"=50'	OWNER/BUILDER: DALE THOMPSON BUILDERS 6300 WOODSIDE COURT COLUMBIA, MD 21045 (410) 995-6736	LOT 3 PINDELL WOODS HOWARD COUNTY, MARYLAND
PLAT REFERENCES LIBER/FOLIO: PLAT BOOK: PLAT NO. FOLIO:		