AVP

2049

Rdbnhwy LWLCLAYSILT

Loam

mica 15%

WEST 8

WKorg L Loam

13'

2047/2046

Strd brn hwy L

5'

brn micac Loam/ SL

BOTTOM 14'

2045

hyL 5½'

lt brn brn L

12' Bottom

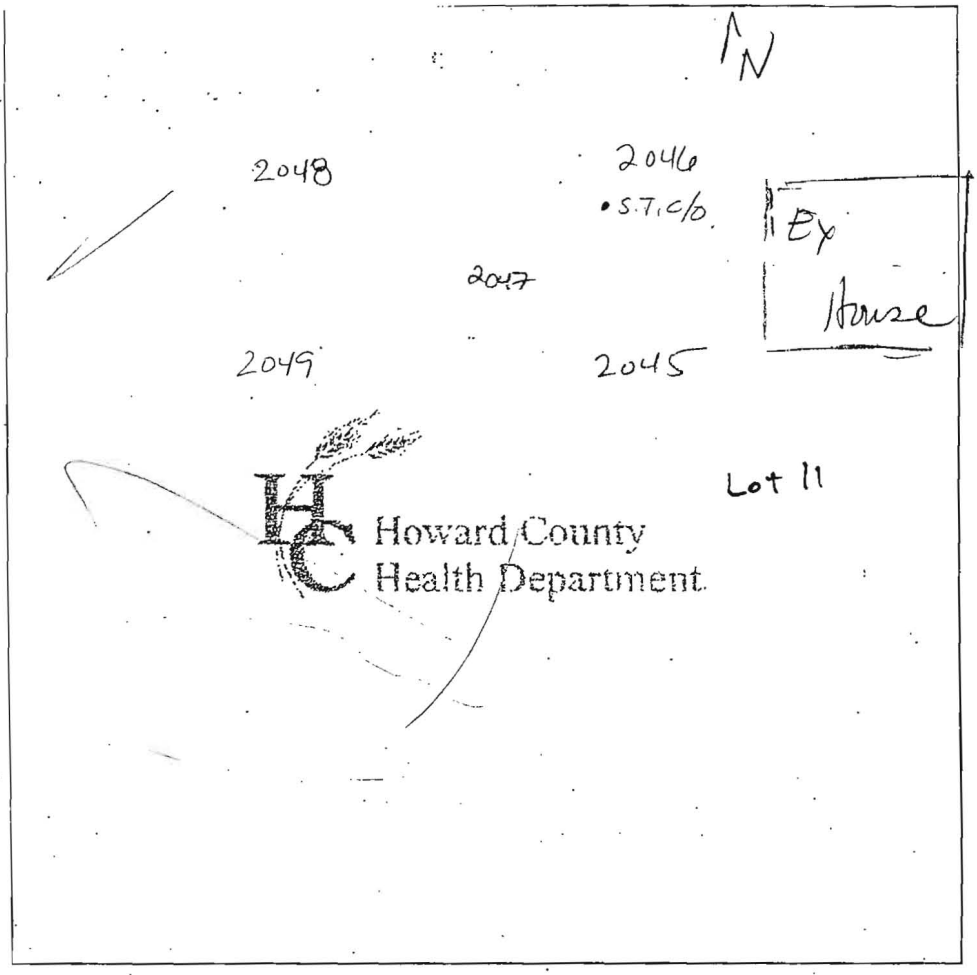

DATE	TEST #	DEPTH	START	BREAK 1" DROP	STOP 2" DROP	TIME OF 2nd INCH	P/F/H
4-24-06	2049	5'	3:10	3:18	Stopped due to time	8-10	P
	2047	5½	3:16	3:20	3:26	6	P
	2046	5½	3:18	3:22	3:29	7	P
	2045	NOT DUG DUE TO TIME					OK
		EXISTING SEPTIC APPEARS TO BE BACKING up. c/o on? sewage.					
				S. Tank ? owner says S. TANK, E House to be raised			
		AREA HOMOGENEOUS					

REMARKS Holes dug on stake

SANITARIAN Kacu 22 MAR 06 8:28 BACKHOE Hatfields OTHERS

TEST HOLES USED IN SDA AVG. PERC TIME SQ.-FT/BR

TRENCH WIDTH INLET DEPTH MAX. BOT DEPTH EFFECTIVE S/W

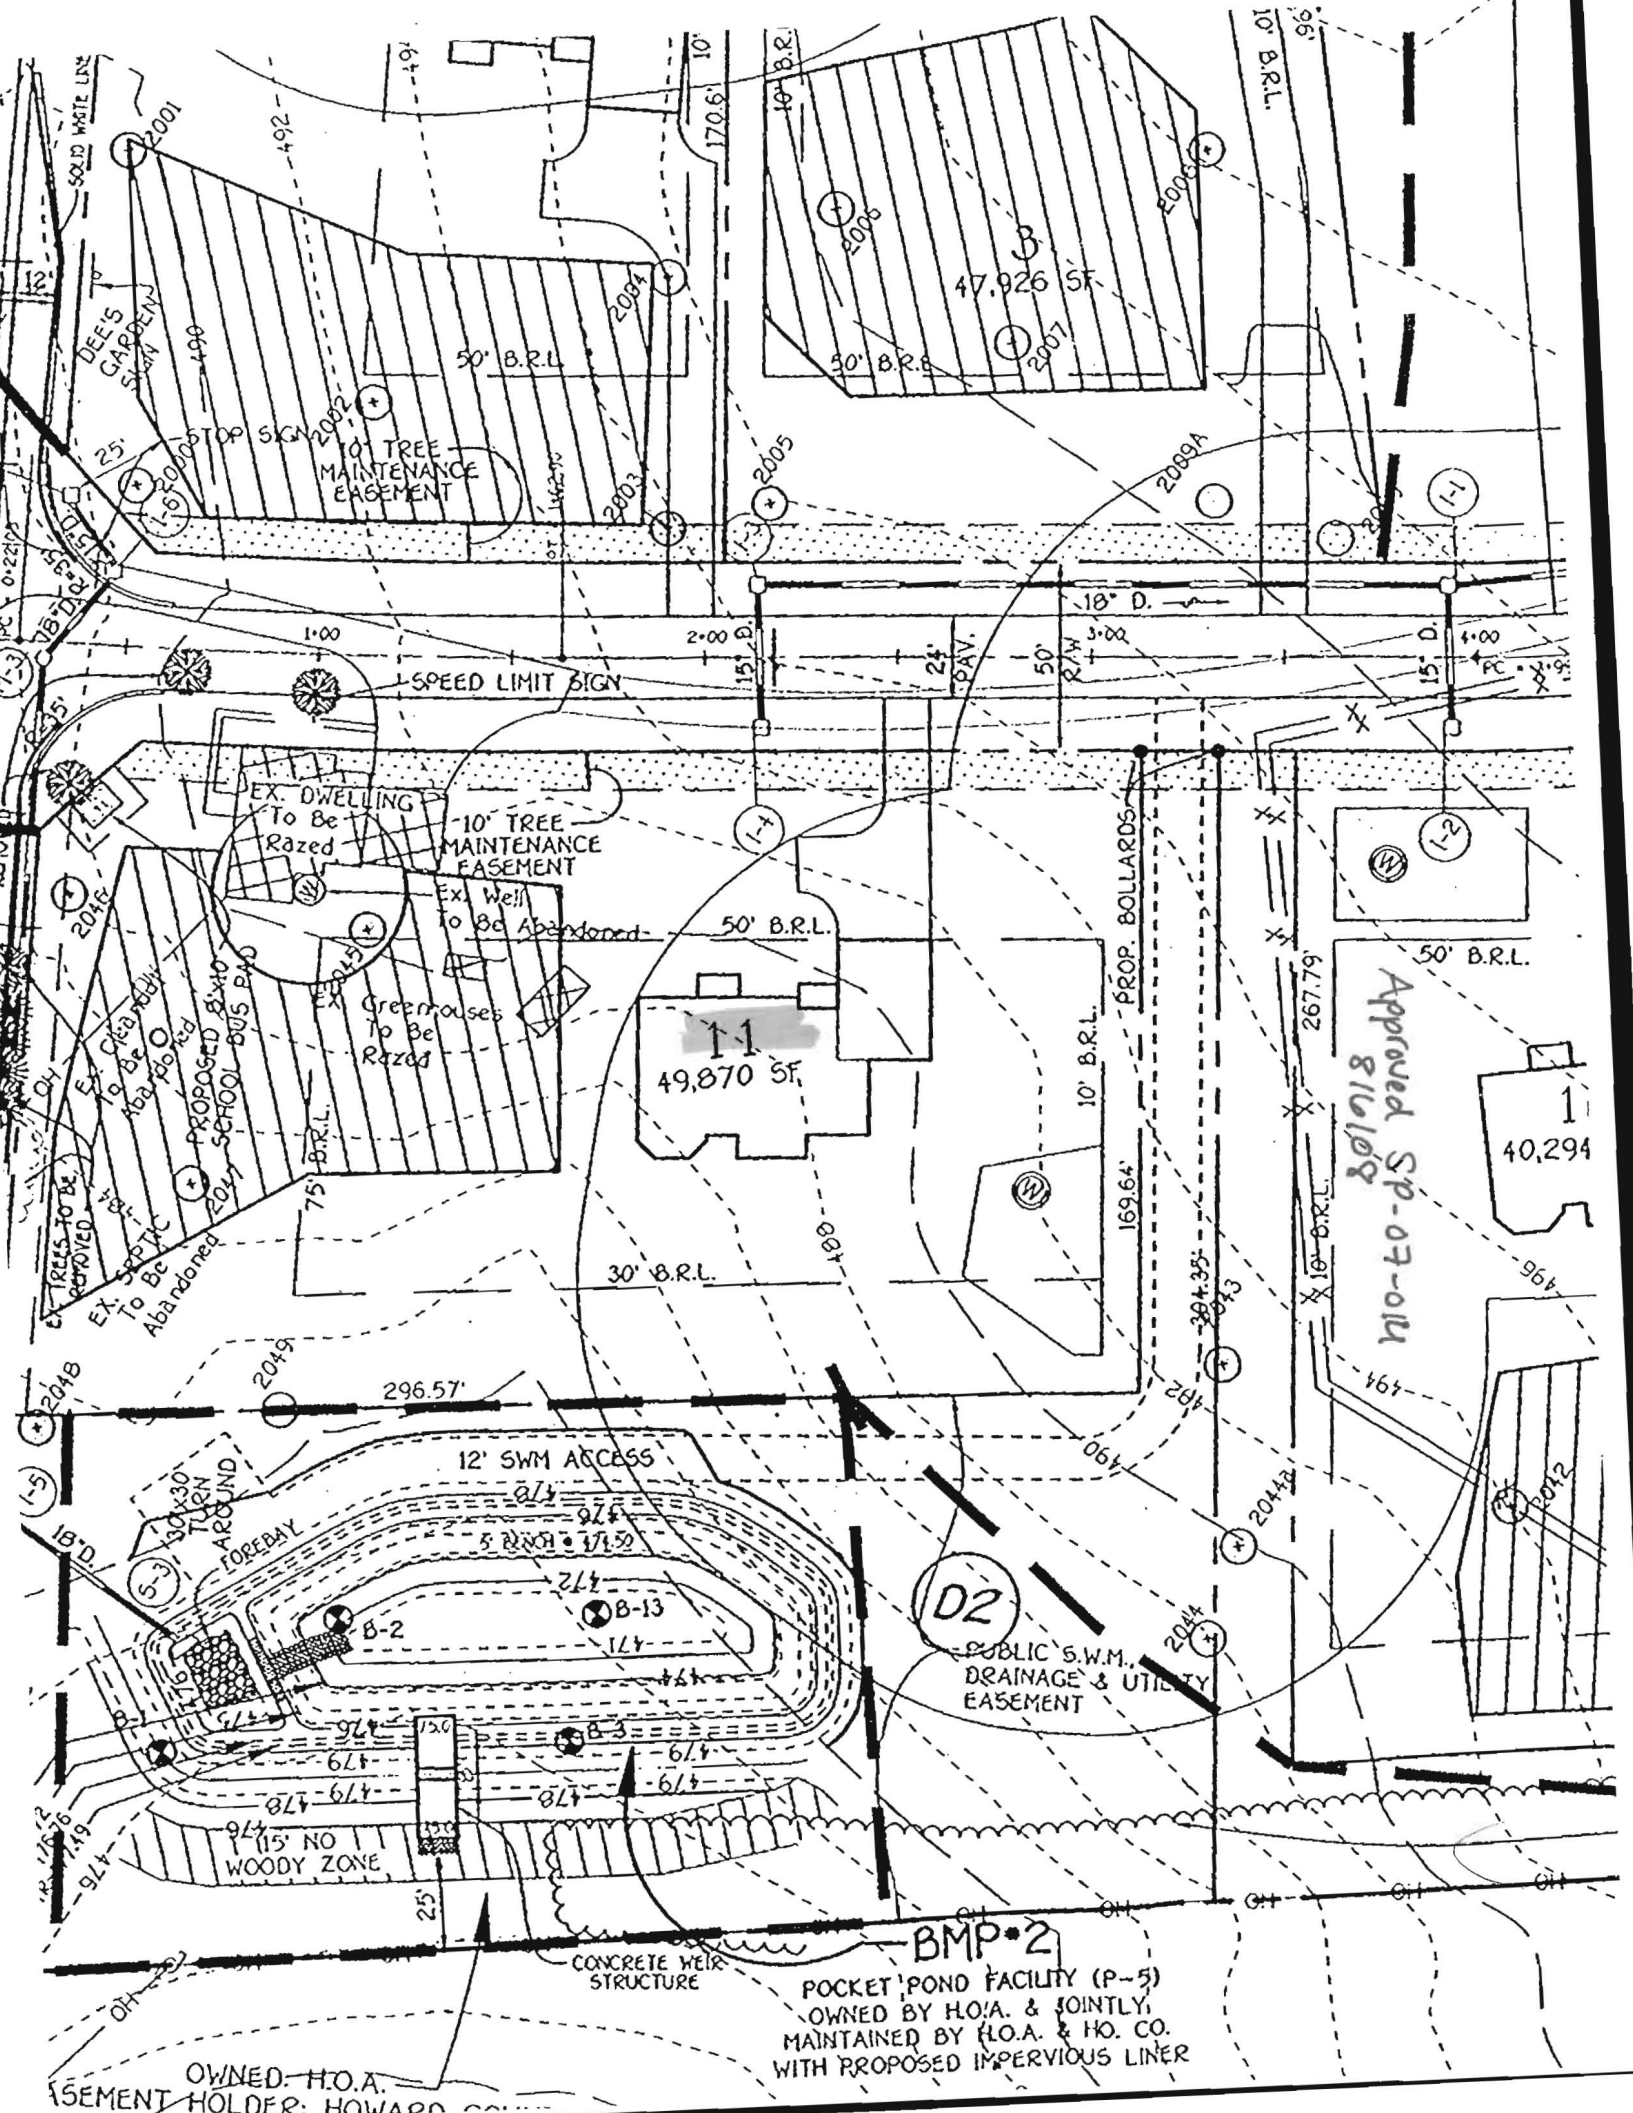
SOLID WASTE LANE
DEE'S GARDENS
STOP SIGN
10' TREE MAINTENANCE EASEMENT
50' B.R.L.
B
47,926 SF.
SPEED LIMIT SIGN
EX. DWELLING To Be Razed
10' TREE MAINTENANCE EASEMENT
Ex. Well To Be Abandoned
Ex. Greenhouses To Be Razed
PROPOSED 8'x10' ASPHALT SCHOOL BUS PAD
EX. SEPTIC To Be Abandoned
TREES TO BE REMOVED
PROP. BOLLARDS
1-1
49,870 SF.
1
40,294
Approved SP-07-04 8/16/08
296.57'
12' SWM ACCESS
20'x30' TURN AROUND
FOREBAY
D2
PUBLIC S.W.M., DRAINAGE & UTILITY EASEMENT
B-1
B-2
B-3
B-13
15' NO WOODY ZONE
CONCRETE WEIR STRUCTURE
BMP-2
POCKET POND FACILITY (P-5)
OWNED BY H.O.A. & JOINTLY MAINTAINED BY H.O.A. & HO. CO.
WITH PROPOSED IMPERVIOUS LINER
OWNED: H.O.A.
EASEMENT HOLDER: HOWARD