

# APPLICATION

PERCOLATION TESTING

A 513 of 2

P \_\_\_\_\_

HOWARD COUNTY HEALTH DEPARTMENT  
BUREAU OF ENVIRONMENTAL HEALTH  
3525-H ELLICOTT MILLS DRIVE/ELLICOTT CITY, MARYLAND 21043  
TELEPHONE: 313-2640

DISTRICT \_\_\_\_\_

DATE \_\_\_\_\_

TO: THE COUNTY HEALTH OFFICER  
ELLICOTT CITY, MARYLAND

I HEREBY APPLY FOR THE NECESSARY TEST PRIOR TO APPLICATION FOR PERMIT TO CONSTRUCT (OR RECONSTRUCT) A SEWAGE DISPOSAL SYSTEM.

PROPERTY OWNER \_\_\_\_\_

ADDRESS \_\_\_\_\_ PHONE \_\_\_\_\_

AGENT OR PROSPECTIVE BUYER \_\_\_\_\_

ADDRESS \_\_\_\_\_ PHONE \_\_\_\_\_

PROPERTY LOCATION:

SUBDIVISION \_\_\_\_\_ LOT NO. \_\_\_\_\_

ROAD AND DESCRIPTION \_\_\_\_\_

TAX MAP \_\_\_\_\_ PARCEL # \_\_\_\_\_

SIZE OF LOT \_\_\_\_\_ TYPE BLDG. \_\_\_\_\_  
(SINGLE FAMILY DWELLING OR COMMERCIAL)

THE SYSTEM INSTALLED UNDER THIS APPLICATION IS ACCEPTABLE ONLY UNTIL PUBLIC FACILITIES BECOME AVAILABLE. I FULLY UNDERSTAND THE FEE CONNECTED WITH THE FILING OF THIS PERC TEST APPLICATION IS NON-REFUNDABLE UNDER ANY CIRCUMSTANCES. I ALSO AGREE TO COMPLY WITH ALL M.O.S.H.A. REQUIREMENTS IN TESTING THIS LOT.

(SIGNATURE OF APPLICANT)

APPROVED BY \_\_\_\_\_ FOR \_\_\_\_\_ DATE \_\_\_\_\_

DISAPPROVED BY \_\_\_\_\_ FOR \_\_\_\_\_ DATE \_\_\_\_\_

HOLD PENDING FURTHER TESTS \_\_\_\_\_

REASONS FOR REJECTION OR HOLDING \_\_\_\_\_

PERCOLATION TEST PLAT/PRELIMINARY PLAT - TITLE OR I.D. # \_\_\_\_\_ DATE \_\_\_\_\_


SITE DEVELOPMENT PLAN/FINAL PLAT - TITLE OR I.D. # \_\_\_\_\_ DATE \_\_\_\_\_

# THIS IS NOT A PERMIT

# HOMewood RD.

COUNTY # \_\_\_\_\_

SOIL PROFILE  
 0' (541)  
 Topsoil  
 org brn  
 CL LM  
 5-5 1/2' tan, org brn  
 brn  
 LM  
 Rock Frag <5%  
 14' Bottom  
 (540)  
 1" Topsoil  
 KD, Brn  
 HVY  
 CL LM  
 6 1/2-7' tan  
 brn  
 SA LM  
 Rock Frag  
 15-20%  
 13 1/2' Bottom  
 (539)  
 1" Topsoil  
 org br  
 CL LM  
 5 1/2' HVY  
 LM org brn  
 6' brn  
 tan  
 org brn  
 Micaceous  
 SA LM  
 Rock 5-10%  
 14' Bottom

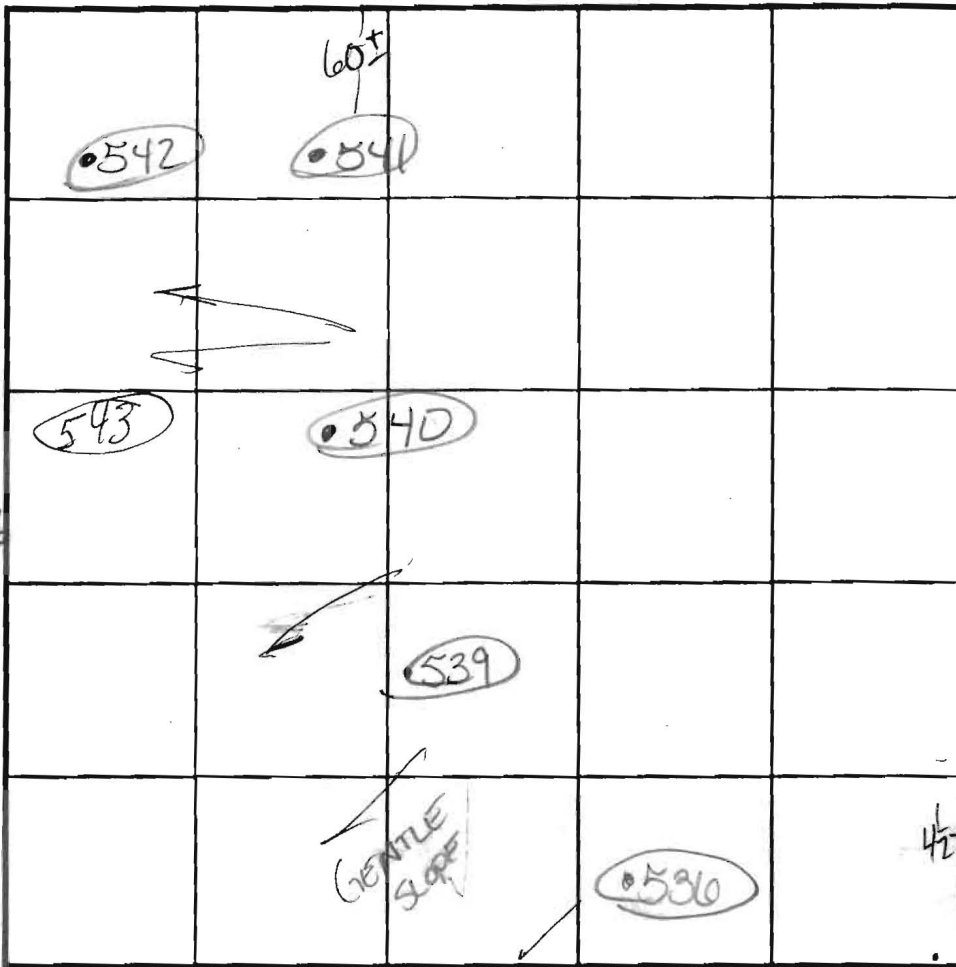

SOIL PROFILE  
 0' (536/537)  
 Topsoil  
 HVY org brn  
 Loam  
 3-4' Micaceous  
 SA LM  
 org brn  
 tan  
 H beige  
 Rock Frag  
 5-10%  
 Bottom  
 13 1/2' 543/542  
 4 1/2-5 1/2' org brn  
 tan cl lm  
 Lt. brn beige  
 sa lm  
 <5% Lx  
 14'

INDICATE NORTH - NAME ADJOINING ROADWAY AS BASE LINE.

DATE	TEST NO.	DEPTH	PRE-WET		TEST - 1" DROP		TIME
			START	STOP	START	STOP	
9/27	541	5 1/2' / 14'	11:11 <sup>30</sup>	11:16	11:16	11:25	9 min
	542	6 1/4' / 14'	4:04	4:05	4:05	4:07	2
	540	6' 2" S	11:20	>30 min for 1" drop			
		8' S 13 1/2' D	3:36 <sup>00</sup>	3:39 <sup>40</sup>	3:37 <sup>40</sup>	3:39 <sup>10</sup>	1 1/2 min
	539	6' 2" S	11:29	11:34	11:34	11:44	10 min
		14' 2" D					PASS
	536	5' S	11:49 <sup>00</sup>	11:53	11:53	11:57	8 min
		13 1/2' D					PASS
	537	5' 3" S	11:59	12:00 <sup>30</sup>	12:00 <sup>30</sup>	12:04 <sup>30</sup>	4 min
	543	6' / 14'	2:02	2:04	2:04	2:08	4 min

REMARKS HOLES PER PLAN

TYPE OF SOIL \_\_\_\_\_

TESTED BY Goedeking ALSO PRESENT Chuck C. Ford  
Mike & crew

TRENCH DESIGN DATA: AVERAGE PERCOLATION TIME \_\_\_\_\_ TRENCH WIDTH \_\_\_\_\_

INLET DEPTH \_\_\_\_\_ MAXIMUM BOTTOM DEPTH \_\_\_\_\_ SQ. FT./BEDROOM \_\_\_\_\_



Vehicle log

1/15 'Riverwood'

Comment sent

1/23, revised 1/24

See Plot.

There is a pipeline  
between the two  
wells (one each on lots  
72 & 73?)

**Area Tabulation for Sheet 2**

Total Number of Subdivisible Lots to be Recorded	1
Total Number of Non-Subdivisible Preservation Parcels to be Recorded	0
Total Number of Non-Subdivisible Parcels to be Recorded	0
Total Area of Subdivisible Lots to be Recorded	1,140 Ac.
Total Area of Non-Subdivisible Preservation Parcels to be Recorded	6,520 Ac.
Total Area of Non-Subdivisible Parcels to be Recorded	0.000 Ac.
Total Area of Land to be Recorded	7,660 Ac.
Total Area of Land to be Recorded	5,770 Ac.








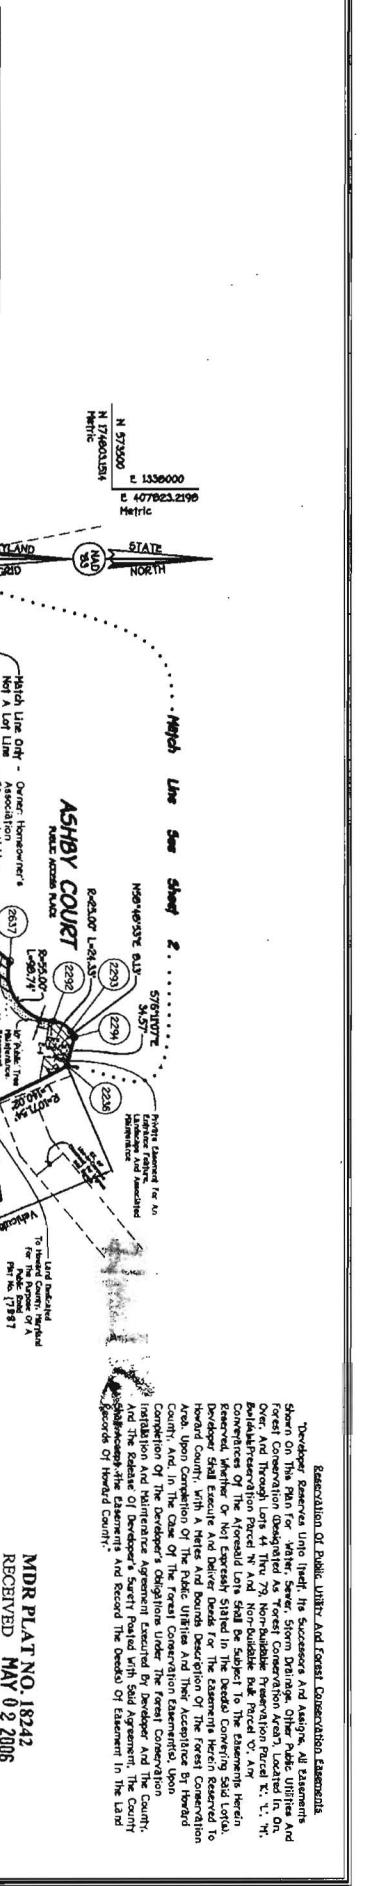



# APPLICATION

PERCOLATION TESTING

A \_\_\_\_\_

P \_\_\_\_\_

HOWARD COUNTY HEALTH DEPARTMENT  
BUREAU OF ENVIRONMENTAL HEALTH  
3525-H ELLICOTT MILLS DRIVE/ELLICOTT CITY, MARYLAND 21043  
TELEPHONE: 313-2840

DISTRICT \_\_\_\_\_

DATE \_\_\_\_\_

TO: THE COUNTY HEALTH OFFICER  
ELLICOTT CITY, MARYLAND

I HEREBY APPLY FOR THE NECESSARY TEST PRIOR TO APPLICATION FOR PERMIT TO CONSTRUCT (OR RECONSTRUCT) A SEWAGE DISPOSAL SYSTEM.

PROPERTY OWNER \_\_\_\_\_

ADDRESS \_\_\_\_\_ PHONE \_\_\_\_\_

AGENT OR PROSPECTIVE BUYER \_\_\_\_\_

ADDRESS \_\_\_\_\_ PHONE \_\_\_\_\_

PROPERTY LOCATION:

SUBDIVISION Benedict Farm LOT NO. \_\_\_\_\_

ROAD AND DESCRIPTION \_\_\_\_\_

TAX MAP \_\_\_\_\_ PARCEL # \_\_\_\_\_

SIZE OF LOT \_\_\_\_\_ TYPE BLDG. \_\_\_\_\_  
(SINGLE FAMILY DWELLING OR COMMERCIAL)

THE SYSTEM INSTALLED UNDER THIS APPLICATION IS ACCEPTABLE ONLY UNTIL PUBLIC FACILITIES BECOME AVAILABLE. I FULLY UNDERSTAND THE FEE CONNECTED WITH THE FILING OF THIS PERC TEST APPLICATION IS NON-REFUNDABLE UNDER ANY CIRCUMSTANCES. I ALSO AGREE TO COMPLY WITH ALL M.O.S.H.A. REQUIREMENTS IN TESTING THIS LOT.

(SIGNATURE OF APPLICANT)

APPROVED BY \_\_\_\_\_ FOR \_\_\_\_\_ DATE \_\_\_\_\_

DISAPPROVED BY \_\_\_\_\_ FOR \_\_\_\_\_ DATE \_\_\_\_\_

HOLD PENDING FURTHER TESTS \_\_\_\_\_

REASONS FOR REJECTION OR HOLDING \_\_\_\_\_

PERCOLATION TEST PLAT/PRELIMINARY PLAT - TITLE OR I.D. # \_\_\_\_\_ DATE \_\_\_\_\_


SITE DEVELOPMENT PLAN/FINAL PLAT - TITLE OR I.D. # \_\_\_\_\_ DATE \_\_\_\_\_

# THIS IS NOT A PERMIT

COUNTY #

SOIL PROFILE

0' **538**  
 Dense Strong Rd Brn Micaceous SCLM Rx 15-20%  
 4'  
 tan beige strong tan Micaceous Lm to silM Rx ~50%  
 Bottom 13'

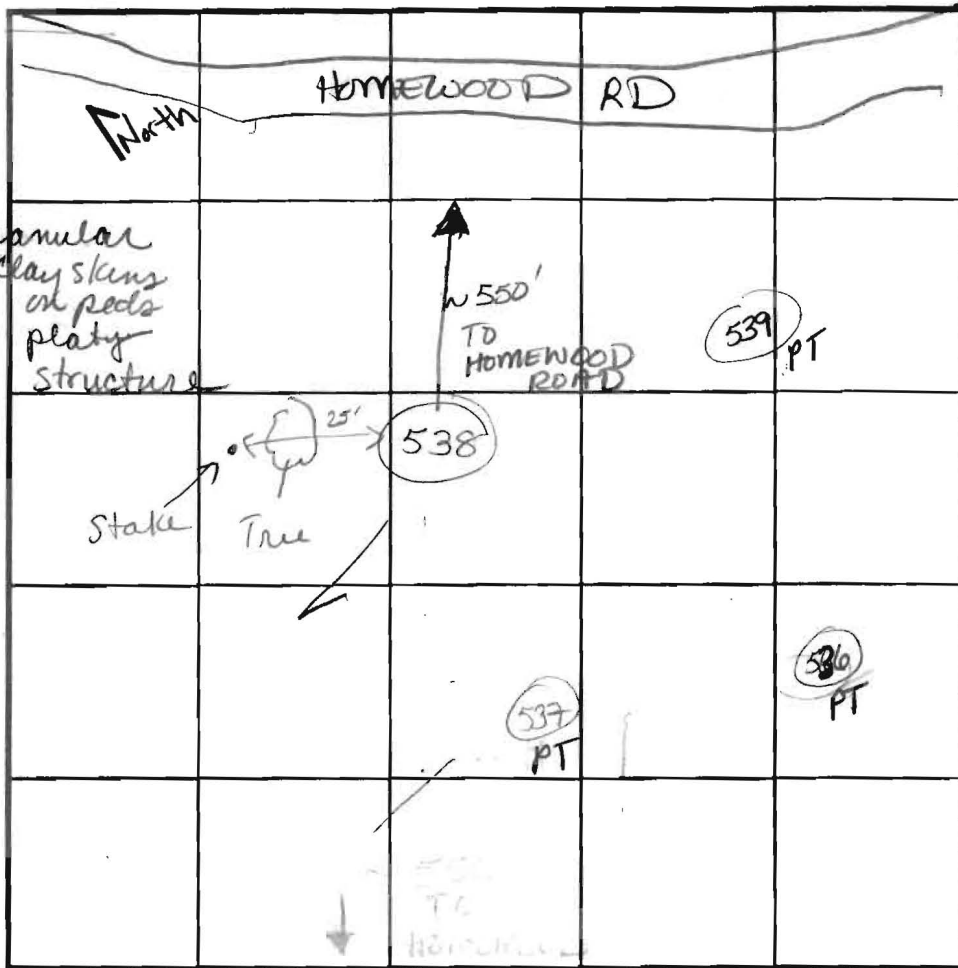

SOIL PROFILE

0'

INDICATE NORTH - NAME ADJOINING ROADWAY AS BASE LINE.

DATE	TEST NO.	DEPTH	PRE-WET		TEST - 1" DROP		TIME
			START	STOP	START	STOP	
2-22-02	538	4 1/2' S	2:49	3:05	3:05	3:32	28
		13' D					OK

REMARKS Hole per plan  
 TYPE OF SOIL \_\_\_\_\_  
 TESTED BY Goedeking ALSO PRESENT Chuck Crow  
Mike Johnson  
 TRENCH DESIGN DATA: AVERAGE PERCOLATION TIME \_\_\_\_\_ TRENCH WIDTH \_\_\_\_\_  
 INLET DEPTH \_\_\_\_\_ MAXIMUM BOTTOM DEPTH \_\_\_\_\_ SQ. FT./BEDROOM \_\_\_\_\_

