

C 1 7272

SEQUENCE NO. (MDE USE ONLY)

STATE OF MARYLAND WELL COMPLETION REPORT

THIS REPORT MUST BE SUBMITTED WITHIN 45 DAYS AFTER WELL IS COMPLETED.

1 2 3 6 (THIS NUMBER IS TO BE PUNCHED IN COLS. 3-6 ON ALL CARDS)

COUNTY NUMBER

ST/CO USE ONLY DATE RECEIVED

DATE WELL COMPLETED

Depth of Well 22 300 26

PERMIT NO. FROM "PERMIT TO DRILL WELL" HO-95-1333

OWNER Spring Mill LLC STREET OR RFD Mitchells Way TOWN West Friendship SUBDIVISION Cloverfield SECTION 2 LOT 2

WELL LOG table with columns: DESCRIPTION, FEET (FROM, TO), check if water bearing. Includes entries: red clay (0-8), Brown shale (8-79), Gray Limestone (79-300).

GROUTING RECORD: WELL HAS BEEN GROUTED (Y), TYPE OF GROUTING MATERIAL: CEMENT (CM), BENTONITE CLAY (BC), NO. OF BAGS: 52, NO. OF POUNDS: 4888, GALLONS OF WATER: 312, DEPTH OF GROUT SEAL: 0 ft. to 81 ft.

CASING RECORD: casing types insert appropriate code below. MAIN CASING TYPE: ST (STEEL), Nominal diameter: 06, Total depth of main casing: 84.

OTHER CASING (if used) diameter inch, depth (feet) from to.

SCREEN RECORD: screen type or open hole. insert appropriate code below. SCREEN TYPE: ST (STEEL), BR (BRASS), HO (OPEN HOLE).

DEPTH (nearest ft.) table with columns 1-21 and rows A-E. Includes slot size and diameter of screen information.

PUMPING TEST: HOURS PUMPED (nearest hour) 3, PUMPING RATE (gal. per min.) 10, METHOD USED TO MEASURE PUMPING RATE: 1902, WATER LEVEL (distance from land surface) BEFORE PUMPING 26 ft., WHEN PUMPING 66 ft., TYPE OF PUMP USED: S (submersible).

PUMP INSTALLED: DRILLER INSTALLED PUMP (YES/NO), TYPE OF PUMP INSTALLED: S, PLACE (A,C,J,P,R,S,T,O) IN BOX 29, CAPACITY: GALLONS PER MINUTE (to nearest gallon) 31-35, PUMP HORSE POWER 37-41, PUMP COLUMN LENGTH (nearest ft.) 43-47, CASING HEIGHT (circle appropriate box and enter casing height) + above, LAND SURFACE, - below, 02 (nearest foot).

LOCATION OF WELL ON LOT: SHOW PERMANENT STRUCTURE SUCH AS BUILDING, SEPTIC TANKS, AND /OR LANDMARKS AND INDICATE NOT LESS THAN TWO DISTANCES (MEASUREMENTS TO WELL). Includes a north arrow.

NUMBER OF UNSUCCESSFUL WELLS: 0

WELL HYDROFRACTURED: YES (Y) NO (N)

CIRCLE APPROPRIATE LETTER: A (ABANDONED), E (ELECTRIC LOG), P (TEST WELL CONVERTED).

I HEREBY CERTIFY THAT THIS WELL HAS BEEN CONSTRUCTED IN ACCORDANCE WITH COMAR 26.04.04 "WELL CONSTRUCTION" AND IN CONFORMANCE WITH ALL CONDITIONS STATED IN THE ABOVE CAPTIONED PERMIT.

DRILLERS LIC. NO. 1 M SD 009, DRILLERS SIGNATURE (Must match signature on application)

LIC. NO. 1 D

SITE SUPERVISOR (sign. of driller or journeyman responsible for sitework if different from permittee)

GRAVEL PACK IF WELL DRILLED WAS FLOWING WELL INSERT F IN BOX 68

MDE USE ONLY (NOT TO BE FILLED IN BY DRILLER) T (E.R.O.S.) W Q

70 72 74 75 76 TELESCOPE CASING LOG INDICATOR OTHER DATA

No survey stakes

B 1 8228

SEQUENCE NO. (MDE USE ONLY)

STATE OF MARYLAND APPLICATION FOR PERMIT TO DRILL WELL

STATE PERMIT NUMBER

10-95-1333 fill in this form completely

522862 please type

Date Received (APA)

OWNER INFORMATION

Spring Mill LLC, P.O. Box 417, Ellicott City, Md 21041


LOCATION OF WELL

Howard County, Cloverfield Subdivision, West Friendship Nearest Town, 4 miles from town

DRILLER INFORMATION

Allen Compton, M S D 009, Eagles Well Drilling, 6003 Woodbine Rd.

DIRECTION OF WELL FROM TOWN (CIRCLE BOX)

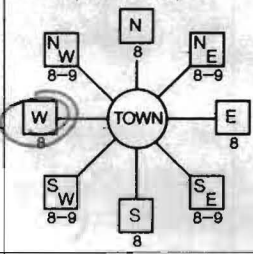

ON WHICH SIDE OF ROAD (CIRCLE APPROPRIATE BOX)

100 feet distance from road, 15 tax map, 7 blk, 119 parcel

WELL INFORMATION

5 approx. pumping rate, 500 average daily quantity needed

USE FOR WATER (CIRCLE APPROPRIATE BOX)

- DOMESTIC POTABLE SUPPLY & RESIDENTIAL IRRIGATION (circled), FARMING, INDUSTRIAL, PUBLIC WATER SUPPLY WELL, TEST, OBSERVATION, MONITORING, GEO-THERMAL

NOT TO BE FILLED IN BY DRILLER HEALTH DEPARTMENT APPROVAL

Howard County, State Signature, Date Issued 2/25/06, Co Signature, Exp. Date 2/25/09, North Grid 536 000, East Grid 802 000

APPROXIMATE DEPTH OF WELL 300 FEET

APPROXIMATE DIAMETER OF WELL 6 INCH

METHOD OF DRILLING (circle one)

- BORED (circled), AIR-ROTary, JETTED, ROTARY (Hydraulic Rotary), GABLE, REVerse-ROTary, DRive-POINT

REPLACEMENT OR DEEPEMED WELLS (CIRCLE APPROPRIATE BOX)

- THIS WELL WILL NOT REPLACE AN EXISTING WELL (circled), THIS WELL WILL REPLACE A WELL THAT WILL BE ABANDONED AND SEALED, THIS WELL WILL REPLACE A WELL THAT WILL BE USED AS A STANDBY-CONTACT LOCAL APPROVING AUTHORITY FOR POLICY ON STANDBY WELLS, THIS WELL WILL DEEPEM AN EXISTING WELL

PERMIT NUMBER OF WELL TO BE REPLACED OR DEEPEMED (IF AVAILABLE)

Not to be filled in by driller (MDE OR COUNTY USE ONLY)

APPROP. PERMIT NUMBER HD 2107 G 003, PERMIT No. 10-95-1333


SHOW MAJOR FEATURES OF BOX & LOCATE WELL WITH AN X

SOURCES OF DRILLING WATER

WRITE THE BOX NUMBER FROM THE MAP HERE

E 802, N 536

DRAW A SKETCH BELOW SHOWING LOCATION OF WELL IN RELATION TO NEARBY TOWNS AND ROADS AND GIVE DISTANCE FROM WELL TO NEAREST ROAD JUNCTION

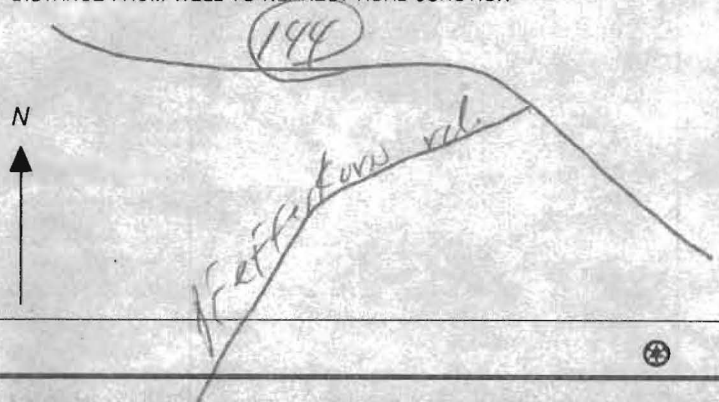

SPECIAL CONDITIONS

NOTE - APPROVING AUTHORITIES SHOULD USE SEPARATE SHEET IF NEEDED

**HOWARD COUNTY HEALTH DEPARTMENT
BUREAU OF ENVIRONMENTAL HEALTH
WATER AND SEWERAGE PROGRAM
TEL: (410)313-2640- FAX: (410)313-2648
313-1771**

Information Form for the Installation of the Well Pump, Pitless Adapter, and Supply Piping

NOTE: The installer is responsible for requesting an inspection prior to 9 am on the day of the desired inspection. No work is to be covered until approved by the Health Department. All installations must comply with the National Standard Plumbing Code (NSPC, as amended locally) and COMAR 26.04.04 (MD Well Construction Regulations). Submission of a complete form is required prior to Use and Occupancy approval.

Company Name: ATLANTIC BLUE LLC Telephone #: 410-840-8112
Address: 75 ALLIANCE CT SUITE 7
WESTMINSTER MD 21157

(Must circle one) Licensed Plumber Licensed Well Driller Licensed Well Pump Installer
License # and name of individual responsible for the field installation:
Name (Print): MARK MATHER License# 63797

*A licensed individual must perform the actual installation. Apprentices must be under the direct supervision of a licensed journeyman or master plumber, pump installer or well driller. Licenses may be subjected to field verification.

Name of Property Owner: Sprink Mill CC Telephone #: 410-442-2211
Subdivision: CLAYFIELD SECTION 2 Lot #: 2 Well Tag #: HO-95-1333
Site Address: WEST FRIENDSHIP MD 21794

Submersible Pump Data	Pitless Adapter	Well Cap and Electric Conduit
Make: <u>JENSEN</u>	Make: <u>Campbell</u>	Two piece watertight cap: <input checked="" type="checkbox"/>
Model #: <u>755654-2W</u>	Model#: _____	Screened, vented well cap: <input checked="" type="checkbox"/>
Pump Capacity <u>7</u> GPM	Depth: <u>42</u> (36" min)	Cap secured to casing: <input checked="" type="checkbox"/>
Well Yield: <u>10</u> GPM	NSF approved: <input checked="" type="checkbox"/>	Conduit min 18" B.G.: <input checked="" type="checkbox"/>
Depth of well encountered at time of pump installation: <u>280</u> (feet)		Conduit secured to well cap: <input checked="" type="checkbox"/>

If pump capacity exceeds well yield, a low water cut off switch is required by NSPC 1990 Section 17.8.4
Torque arrestors or Cable guards are required - Must circle one
Safety rope, if used, attached to inside of well casing with eye bolt _____

Piping to house	House Connection
Type: <u>POLYETHYLENE</u>	PVC sleeved to undisturbed soil at wall penetration: <u>YES</u>
PSI: <u>160</u> (160 psi min)	Approximate length of sleeve: <u>2 FT</u>
Depth of supply line: <u>42</u> (36" min)	Sleeve caulked and sealed properly: <u>YES</u>

The water supply line is required to be at least ten feet from the septic tank, pump chamber, sewage piping, distribution box, drainfields, and sewage reserve area. If this cannot be accomplished, contact this office for approval prior to installation.

Signature of company representative responsible for installation: _____ date: 6/18/14

For Health Department Use Only - Not to be completed by Installer

Date Insp. Requested: _____ Date Insp. Approved: 8/26/2014 BB/KW

Inspection Data:

Pitless adapter and water supply line at least 36" below grade	<input checked="" type="checkbox"/>
Two piece cap installed and attached to casing securely	<input checked="" type="checkbox"/>
Elec. conduit extends at least 18" below grade/attached to cap properly	<input checked="" type="checkbox"/>
Safety rope installed inside of well casing	<input checked="" type="checkbox"/>
Correct well tag attached properly and casing 8" above finished grade	<input checked="" type="checkbox"/>
Water supply line sleeved adequately at house connection	<input checked="" type="checkbox"/>
Adequate grout observed below pitless adapter	<input checked="" type="checkbox"/>

MD Well Permit # HO-95-1333

Date of Test: 2-27-08

Subdivision Name: cloverfield

Section Lot # 2

Street Address: Mitchells way

Measuring Point (MP) Description: Top of casing
(for ex. "Top of casing")

Distance from MP to ground surface 2' ft.

Well Depth 300' ft.

Well Driller: Fogle's Well Drilling

Must be submitted with the State of Maryland Well Completion Report

Submit to:

Pump Start Time	Static Water level	Pumping Rate	Calculated Flow (gallons per minute)
10:30	26 ft.	() Time to fill 1 gal. bucket () Flow meter reading (if used)	15
TIME	WATER LEVEL BELOW M.P.		
Water level and pumping rate must be recorded every 15 minutes			
1	10:30	26 ft.	4 15 GPM
2	10:45	66 ft.	6 10 GPM
3	11:00	66 ft.	6 10 GPM
4	11:15	66 ft.	6 10 GPM
5	11:30	66 ft.	6 10 GPM
6	11:45	66 ft.	6 10 GPM
7	12:00	66 ft.	6 10 GPM
8	12:15	66 ft.	6 10 GPM
9	12:30	66 ft.	6 10 GPM
10	12:45	66 ft.	6 10 GPM
11	1:00	66 ft.	6 10 GPM
12	1:15	66 ft.	6 10 GPM
13	1:30	66 ft.	6 10 GPM
14	1:45	66 ft.	6 10 GPM
15		ft.	GPM
16		ft.	GPM
NOTES:

B 1 1029

SEQUENCE NO. (MDE USE ONLY)

STATE OF MARYLAND APPLICATION FOR PERMIT TO DRILL WELL please type 527862

STATE PERMIT NUMBER HO-95-1333 fill in this form completely

Date Received (APA)

OWNER INFORMATION

8 MM DD YY 13 Security Development Corporation 15 Last Name Owner First Name 34 P.O. Box 417 36 Street or RFD 55 Elliott City Md 21041 57 Town 70 State 72 Zip 76


B 3 LOCATION OF WELL

8 COUNTY Howard 21 Cloverfield Section II 23 SUBDIVISION SECTION 4 44 46 LOT 2 48 50 West Friendship 52 NEAREST TOWN 71 MILES FROM TOWN (enter 0 if in town) 3 73 76 77 78

DRILLER INFORMATION

Driller's Name Joseph L Mayne MS DO 24 76 License No. 81 Firm Name Joseph L Mayne Well Drilling Address 5512 Ridge Rd Mt. Airy Md 21041 Address Signature Joseph L Mayne 10-15-07 Date

B 4 DIRECTION OF WELL FROM TOWN (CIRCLE BOX)

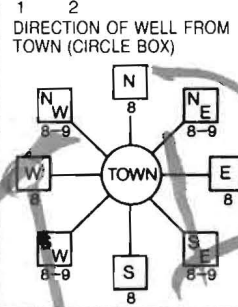

Mitchells way 11 NEAR WHAT ROAD 30 ON WHICH SIDE OF ROAD (CIRCLE APPROPRIATE BOX) NORTH [] WEST [] EAST [] SOUTH [] DISTANCE FROM ROAD 34 75 37 FT ENTER FT OR MI 38 39 TAX MAP: 15 BLK: 7 PARCEL 119

B 2 WELL INFORMATION

APPROX. PUMPING RATE (GAL. PER MIN.) 5 8 12 AVERAGE DAILY QUANTITY NEEDED (GAL. PER DAY) 500 14 20

USE FOR WATER (CIRCLE APPROPRIATE BOX)

- [D] DOMESTIC POTABLE SUPPLY & RESIDENTIAL IRRIGATION [F] FARMING (LIVESTOCK WATERING & AGRICULTURAL IRRIGATION) [I] INDUSTRIAL, COMMERCIAL, DEWATERING [P] PUBLIC WATER SUPPLY WELL [T] TEST, OBSERVATION, MONITORING [G] GEO-THERMAL

NOT TO BE FILLED IN BY DRILLER HEALTH DEPARTMENT APPROVAL

Howard (13) A520768 COUNTY NAME COUNTY NO. STATE SIGNATURE Brian Bapor 10/30/2007 10/30/2008 INSERT S 41 DATE ISSUED CO SIGNATURE EXP. DATE 43 MM DD YY 48 NORTH GRID 536 000 EAST GRID 802 000 50 55 57 63

APPROXIMATE DEPTH OF WELL 500 24 28 FEET APPROXIMATE DIAMETER OF WELL 0 NEAREST INCH

METHOD OF DRILLING (circle one)

BORED (or Augered) JETTED Jetted & DRIVEN 30 AIR-ROTary AIR-PERCussion ROTARY (Hydraulic Rotary) 37 CABLE REVERSE-ROTary DRIVE-POINT other

REPLACEMENT OR DEEPEMED WELLS (CIRCLE APPROPRIATE BOX)

- [N] THIS WELL WILL NOT REPLACE AN EXISTING WELL [Y] THIS WELL WILL REPLACE A WELL THAT WILL BE ABANDONED AND SEALED [S] THIS WELL WILL REPLACE A WELL THAT WILL BE USED AS A STANDBY-CONTACT LOCAL APPROVING AUTHORITY FOR POLICY ON STANDBY WELLS [D] THIS WELL WILL DEEPEM AN EXISTING WELL PERMIT NUMBER OF WELL TO BE REPLACED OR DEEPEMED (IF AVAILABLE) 41 52


Not to be filled in by driller (MDE OR COUNTY USE ONLY)


APPROX. PERMIT NUMBER H02007G003 PERMIT No. H095-1333 70 71 72 73 74 75 76 77 78 79

SHOW MAJOR FEATURES OF BOX & LOCATE WELL WITH AN X SOURCES OF DRILLING WATER 1. well 2. 3.

WRITE THE BOX NUMBER FROM THE MAP HERE E 802 N 536

DRAW A SKETCH BELOW SHOWING LOCATION OF WELL IN RELATION TO NEARBY TOWNS AND ROADS AND GIVE DISTANCE FROM WELL TO NEAREST ROAD JUNCTION

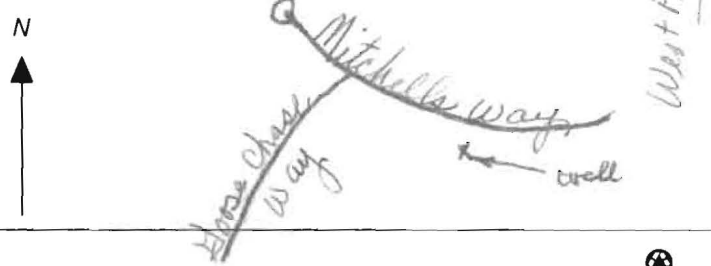

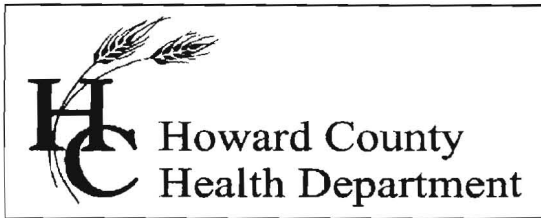

Bureau of Environmental Health

8930 Stanford Blvd., Columbia, MD 21045
Main: 410-313-1771 | Fax: 410-313-2648
TDD 410-313-2323 | Toll Free 1-866-313-6300
www.hchealth.org
Facebook: www.facebook.com/hocohealth
Twitter: HowardCoHealthDep

Maura J. Rossman, M.D., Health Officer

INTERIM CERTIFICATE OF POTABILITY

Expiration Date – FEBRUARY 26, 2015

8/26/2014

Homeowner
13589 Mitchells Way
West Friendship, MD 21794

RE: Cloverfield II, Lot 2
13589 Mitchells Way
Building Permit: B13004355
Well Permit: HO-95-1333

Dear Homeowner:

This is to advise you that the septic system installation and water well construction for the above referenced property have been inspected and approved. Final approval of the septic system was granted on **8/26/2014**. Final approval of the well line connection to the dwelling was granted on **8/26/2014**. The well construction was completed on **2/27/2008**. Water samples were collected on **8/13/2014**.

The water sample results indicate that the water samples submitted for testing were free of coliform and fecal coliform bacteria at the time of sampling and are bacteriologically safe for drinking. This certifies that the initial sampling requirements of COMAR 26.04.04 "Well Regulations" have been met for the water supply system installed under well permit HO-95-1333. Although the submitted sample results are in compliance with COMAR standards, the Health Department does not guarantee water supplies.

This Interim Certificate of Potability will expire **six months** from the date of issuance. Submission of a second bacteriological test indicating the water is free of coliform and fecal coliform bacteria is required prior to the expiration date, after which time a Final Certificate of Potability will be issued. **Failure to submit an additional sample and obtain a Final Certificate of Potability will result in a Notice of Violation and is punishable as a misdemeanor under the Annotated Code of Maryland, Environment Article, 9-1311, subject to a fine of up to \$500 or imprisonment not to exceed three months.**

Please contact (410) 313-1773 to schedule a final water sample appointment or contact a Maryland certified water laboratory to schedule a water sample. A list of laboratories certified by the state of Maryland may be found at the following website:
<http://www.mde.state.md.us/assets/document/WSP-Labs-2010apr16.pdf>

Approving Authority,

A handwritten signature in cursive script that reads "Robert Bricker".

Robert Bricker, REHS/R.S., L.E.H.S.
Environmental Sanitarian
Well & Septic Program

cc: Howard County Dept. of Inspections, Licenses, and Permits
Community Hygiene Program
File

FOUNTAIN VALLEY ANALYTICAL LABORATORY, INC.

1413 Old Taneytown Rd. Westminster, MD (410) 848-1014 (410) 876-4554 FAX (410) 848-0298

REPORT OF ANALYSIS

Laboratory ID #: 95615 Account #: 1045
Reference: Catonsv. Homes Lot 2 Section 2 Company: Atlantic Blue Water Services
Location: 13589 Mitchells Way ✓ West Friendship, MD 21794 Requested By: Mark Mather
Date/ Time Collected: 8/13/2014 1030 Source: Well Water
Date/Time Rec'd: 8/13/2014 1110 Site: Kitchen Sink Tap
Chlorine ppm: Free: ND ✓ Total: ND Treatment: None
Collected By: M. Mather 3480MM pH: 6.7
Well #: HO-95-1333 ✓

PARAMETERS	RESULTS	UNITS	REFERENCE	METHOD	DATE/TIME/ANALYST
Bacteria, Coliform, Total, MPN	<1.0 ✓	MPN/ 100 ml	<1.0	SM18 9223	8/14/2014 / 0815 / LLO
Bacteria, E. coli, MPN	<1.0 ✓	MPN/ 100 ml	<1.0	SM18 9223	8/14/2014 / 0815 / LLO
Nitrate	7.27 ✓	mg/L	10	601	8/13/2014 / 1245 / CRS
Turbidity	3.76 ✓	NTU	<10	SM18 2130B	8/13/2014 / 1320 / CRS
Nitrite	0.013 ✓	mg/L	1	SM4500-NO2 B	8/13/2014 / 1130 / CRS

OK! reb 8/25/2014

NOTES

- 1 mg/L = milligrams per liter (also, parts per million)
- 2 MPN/ 100 ml = Most Probable Number [of viable bacteria] per 100 ml of sample.
- 3 NTU = Nephelometric Turbidity Units
- 4 Results less than or within the reference range are considered satisfactory and within potable water limits at the time of sampling.
- 5 ND:None Detected
- 6 pH and Chlorine level tested in lab
- 7 Sample collected by client, analyzed as received

Reason for Test : Use & Occupancy
Building Permit # : B13004355

Date Reported: 8/14/2014

10/30/01

Well Site
Benchmark

NON-BUILDABLE PRESERVATION
PARCEL A

PROPOSED ZONED:
SUBDIVISION
(PARCEL 4)
SP-05-002

MITCHELLS WAY
(PUBLIC ACCESS PLACE)

GOOSE CHASE WAY
(PUBLIC ACCESS PLACE)

MITCHELLS WAY
(PUBLIC ACCESS PLACE)

NO.	DATE

