

INELL PROPERTY
T. NO. 12285
ZONED-RC

EX. DWELLING
EX. 2289

SEPTIC TANK

Now Lot 6

Now Lot 1

LOT 6

LOT 5

LOT 3

LOT 2

LOT 1

Sister PC Stratco

ROMAN EMDG
LOT 5
TAX MAP 1/5
PARCEL 202

ROMAN EMDG
LOT 4
TAX MAP 1/5
PARCEL 201

N 597.150

E 1,312.850

540

567

560

555

LOT 7

566

565

CgB2












561

562

A/P 19

Brown L
 Orange/Brown CL
 2 1/2'
 Brown/Yellow SL
 5'
 Yellow/Brown SL w/ 15% Cobble
 10'
 Yellow/Brown S
 14'

 






Brown L
 Yellow/Brown Heavy CL
 4 1/2'
 Red/Brown SL
 16'
 Brown/Red Yellow SL
 10'
 Yellow/Brown SL
 12 1/2'

P-15
 Black/Brown L
 1'
 Yellow/Brown Heavy CL
 4'
 Yellow/Red SL w/ 10% Cobble
 5 1/2'
 Red/Brown SL
 11'
 Yellow/Brown SL
 15'

P-16
 Brown L
 1'
 Yellow/Brown Heavy CL
 4'
 Red/Brown CL
 7'
 Yellow/Red SL w/ 10% Cobble
 12'
 Yellow/Brown S
 13 1/2'

| DATE | TEST # | DEPTH | START | BREAK 1" DROP | STOP 2" DROP | TIME OF 2nd INCH | P/F/H |
|---------|--------|------------------|-------|---------------|--------------|------------------|-------|
| 3/30/05 | P-19 | 6' / 14' | 7:40 | 7:45 | 7:49 | 4min | P |
| | P-15 | 6 1/2' / 15' | 7:50 | 7:55 | 8:05 | 10mins | F |
| | P-16 | 8' / 12 1/2' | 8:18 | 8:22 | 8:26 | 4min | P |
| | P-17 | 7 1/2' / 12 1/2' | 8:12 | 8:15 | 8:21 | 6min | P |
| | | | | | | | |
| | | | | | | | |
| | | | | | | | |
| | | | | | | | |
| | | | | | | | |
| | | | | | | | |

REMARKS Holes dug to plan, bottom of ^{holes} lot & manhole ^{located} 10' to 12' from
 SANITARIAN KB/SF BACKHOE Handheld/Daniel OTHERS
 TEST HOLES USED IN SDA _____ AVG. PERC TIME _____ SQ. FT/BR _____
 TRENCH WIDTH _____ INLET DEPTH _____ MAX. BOT DEPTH _____ EFFECTIVE SW _____

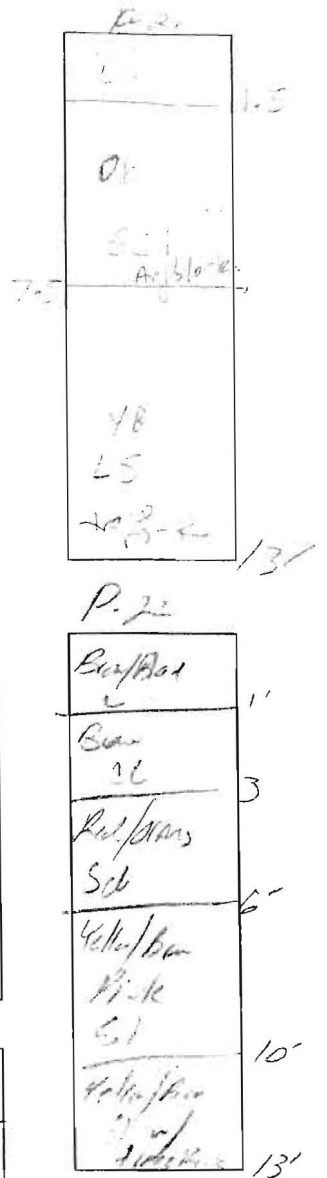 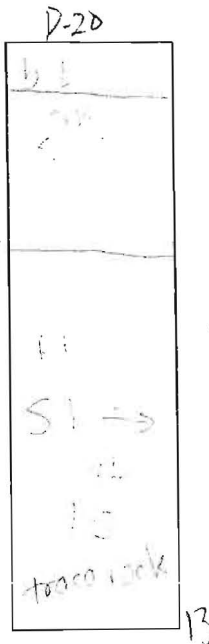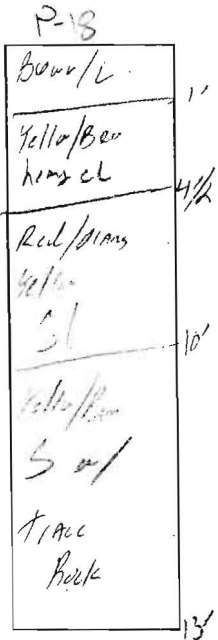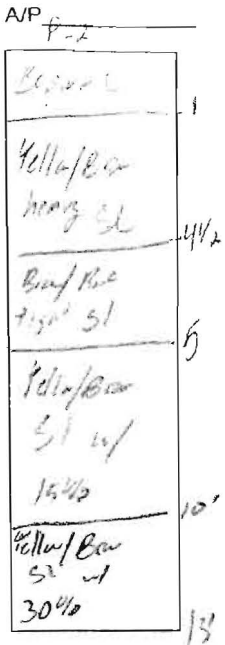

| DATE | TEST # | DEPTH | START | BREAK 1" DROP | STOP 2" DROP | TIME OF 2nd INCH | P/F/H |
|--------|--------|---------------|-------|---------------|--------------|------------------|-------|
| 3/3/05 | P-21 | 5' / 13' | 8:29 | 8:30 | 8:32 | 2 min | P |
| | P-18 | 6 1/2' / 13' | 8:36 | 8:39 | 8:44 | 5 min | P |
| | P-20 | 6 1/2' / 13' | 8:50 | 8:53 | 8:59 | 6 min | P |
| | P-23 | 7.5' / 13' | 9:20 | 9:29 | 9:47 | 12 | P |
| | P-22 | 11 1/2' / 13' | 9:25 | 9:27 | 9:29 | 2 min | P |
| | | | | | | | |
| | | | | | | | |
| | | | | | | | |
| | | | | | | | |

REMARKS: ^{was #20} ~~Barber~~ lot 5 All other holes dug to plan moved up hill due to sewage. Field located

SANITARIAN KB/SP BACKHOE Hartman (Donnie) OTHERS _____

TEST HOLES USED IN SDA _____ AVG. PERC TIME _____ SQ. FT/BR _____

TRENCH WIDTH _____ INLET DEPTH _____ MAX. BOT DEPTH _____ EFFECTIVE SW _____