A 08734

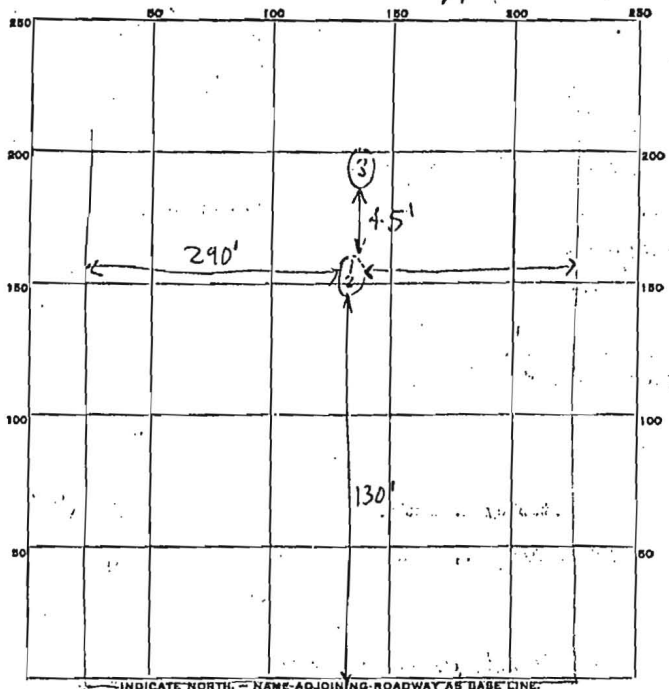

INDICATE NORTH — NAME ADJOINING ROADWAY AS BASE LINE.

Stone Lane (no name)

To Mink Hollow Rd

DATE	TEST NO.	DEPTH	PRE-WET START	PRE-WET STOP	TEST - 1" DROP START	TEST - 1" DROP STOP	TIME
7/14/64	1	9½ ft	945	946	946	950	4 min.
	2	5 ft.	948	952	952	10:00	8 min.
	3	9½ ft.	955	956	956	959	3 min.
	Well permit # 65-W-336						

SOIL AUGER FINDING

TESTED BY R.D.F. 7/14/64

REMARKS

ALSO PRESENT Stanley A. Dunlap LOT NO.