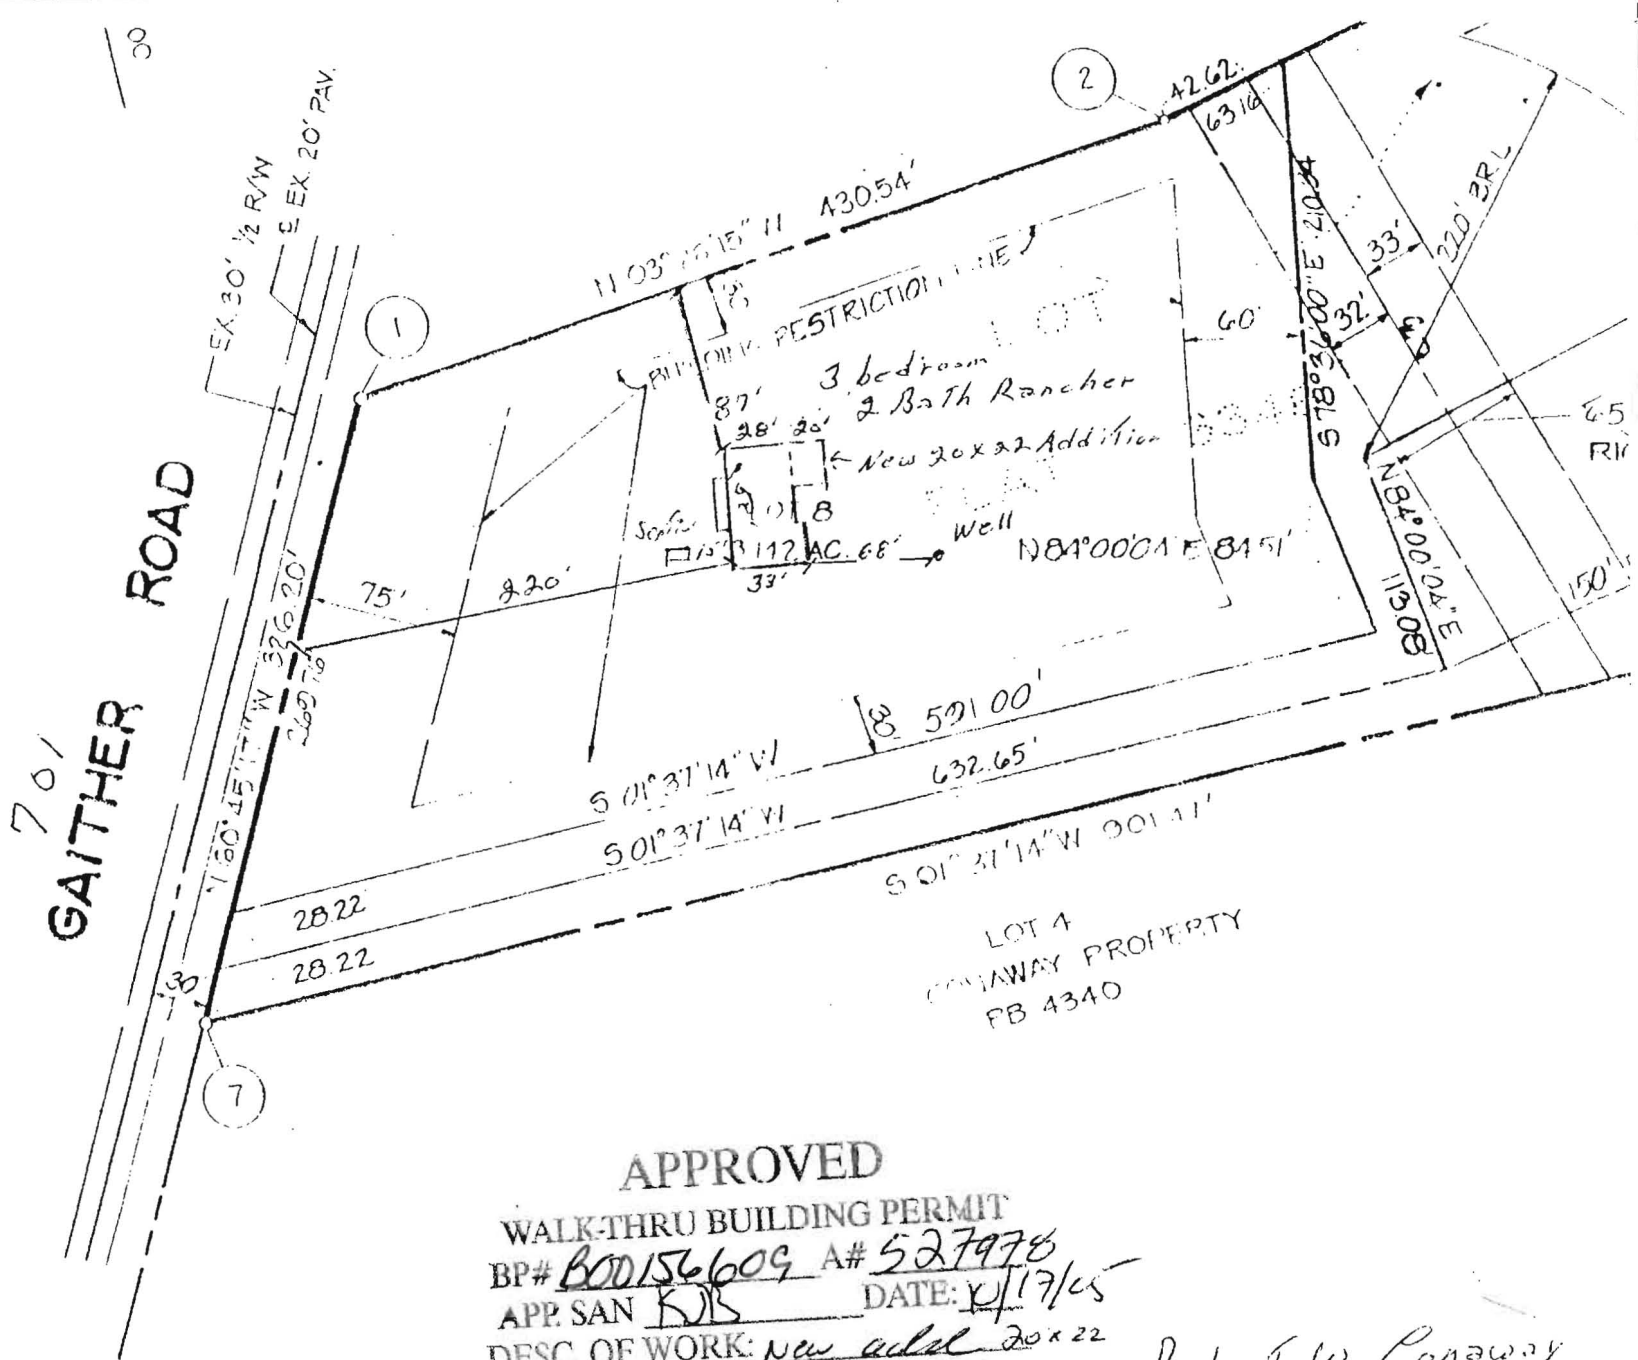

APPROVED
WALK-THRU BUILDING PERMIT
BP# B00156609 A# 527978
APP. SAN KJB DATE: 11/17/05
DESC. OF WORK: New addl 20x22
w/ 1 Bedroom Septic Ok
Per Fyock Septic Services.

Robert W. Conaway
701 Gaither Rd
Sykesville, MD 21784-582

Scale 1" = 100'

AREA TABULATIONS

TOTAL NUMBER OF LOTS: 3
TOTAL AREA OF LOTS: 10.479 AC.
TOTAL AREA OF RIGHT-OF-WAY DEDICATION: NONE
TOTAL AREA OF FLOOD PLAIN DEDICATION: NONE
TOTAL AREA OF PLAT: 11.011 AC.