DEPARTMENT OF INSPECTIONS, LICENSES & PERMITS
3430 COURT HOUSE DRIVE
ELLICOTT CITY, MD 21043
PERMITS (410) 313-2455
INSPECTIONS (410) 313-1850

HOWARD COUNTY RESIDENTIAL HEATING-VENTILATION-AIR CONDITIONING AND REFRIGERATION PERMIT APPLICATION

HVACR PERMIT # M10000947

BUILDING PERMIT #

BUILDING ADDRESS: 17707 Huntmaster CT
SUITE/APT:
SUBDIVISION:
CENSUS TRACT: SECTION: AREA:
LOT: TAX MAP: PARCEL:
BLOCK: ZONE:
PROPERTY ID: MAP COORDINATES:
TYPE OF IMPROVEMENTS: USE:

OWNERS NAME: Thomas Glacken
ADDRESS: 17707 Huntmaster CT
CITY: Woodbine
STATE: MD ZIP CODE: 21797
HOME PHONE: 410 489 2716 WORK PHONE:

	CHECK ONE	HOW MANY
SINGLE FAMILY DWELLING	☑	2 ZONES
SINGLE FAMILY TOWNHOUSE	☐	____ ZONES
MULTI-FAMILY / HOTEL/MOTEL	☐	____ ROOMS
ASSISTED LIVING HOMES (16 OR FEWER RESIDENTS)	☐	____ ROOMS

COMPANY NAME: Fresh Air Concepts
LICENSEE NAME: Joseph Haycock
ADDRESS: 10305 Guilford RD
CITY: Jessup
STATE: MD ZIP CODE: 20794
PHONE: 301 498 4001 HVACR LICENSE NO: 5468

New
- ☐ Heating and Air Conditioning
- ☑ Geo Thermal System
- ☐ Heating System Only
- ☐ Ductless Mini Splits
- ☐ Other Work (Describe):
- ☐ Thru The Wall Systems

Replacement
- ☐ Heating
- ☐ Air Conditioning
- ☑ Heating and Air Conditioning

9/28/10
Approved
BB

Additions and Alterations
- ☐ Heating
- ☐ Air Conditioning
- ☐ Heating and Air Conditioning

****Replacement Geo Thermal Systems are not required; However, if a tax credit is being sought a permit is required****

Zones

Permit Fee = # of Zones x $40 =	80.00
Technology Fee (10% of Permit Fee) =	8.00
Plus Application Fee	$50.00
Total Fees Due =	138.00

Rooms

Permit Fee = # of Rooms x $80 =	____
Technology Fee (10% of Permit Fee) =	____
Plus Application Fee $50	$50.00
Total Fees Due =	____

I HAVE CAREFULLY EXAMINED AND READ THIS APPLICATION AND KNOW IT IS TRUE AND CORRECT. THE WORK DESCRIBED HEREIN WILL BE PERFORMED BY A STATE HVACR LICENSED PERSON(S), AND ALL WORK WILL BE PERFORMED IN COMPLIANCE WITH APPLICABLE CODES AND STANDARDS OF HOWARD COUNTY THE STATE OF MARYLAND.

Joseph Haycock — 9/15/10
SIGNATURE OF LICENSEE — DATE

Joseph Haycock
PRINT NAME OF LICENSEE

FreshAir1@verizon.net
Email Address

Validation
Check Number: 103600
Cash: ____
Receipt Number: 218825

Make check payable to: DIRECTOR OF FINANCE OF HOWARD COUNTY

Word doc: T:\Updated Forms\hvac application
Rev:10.2009

M7000947

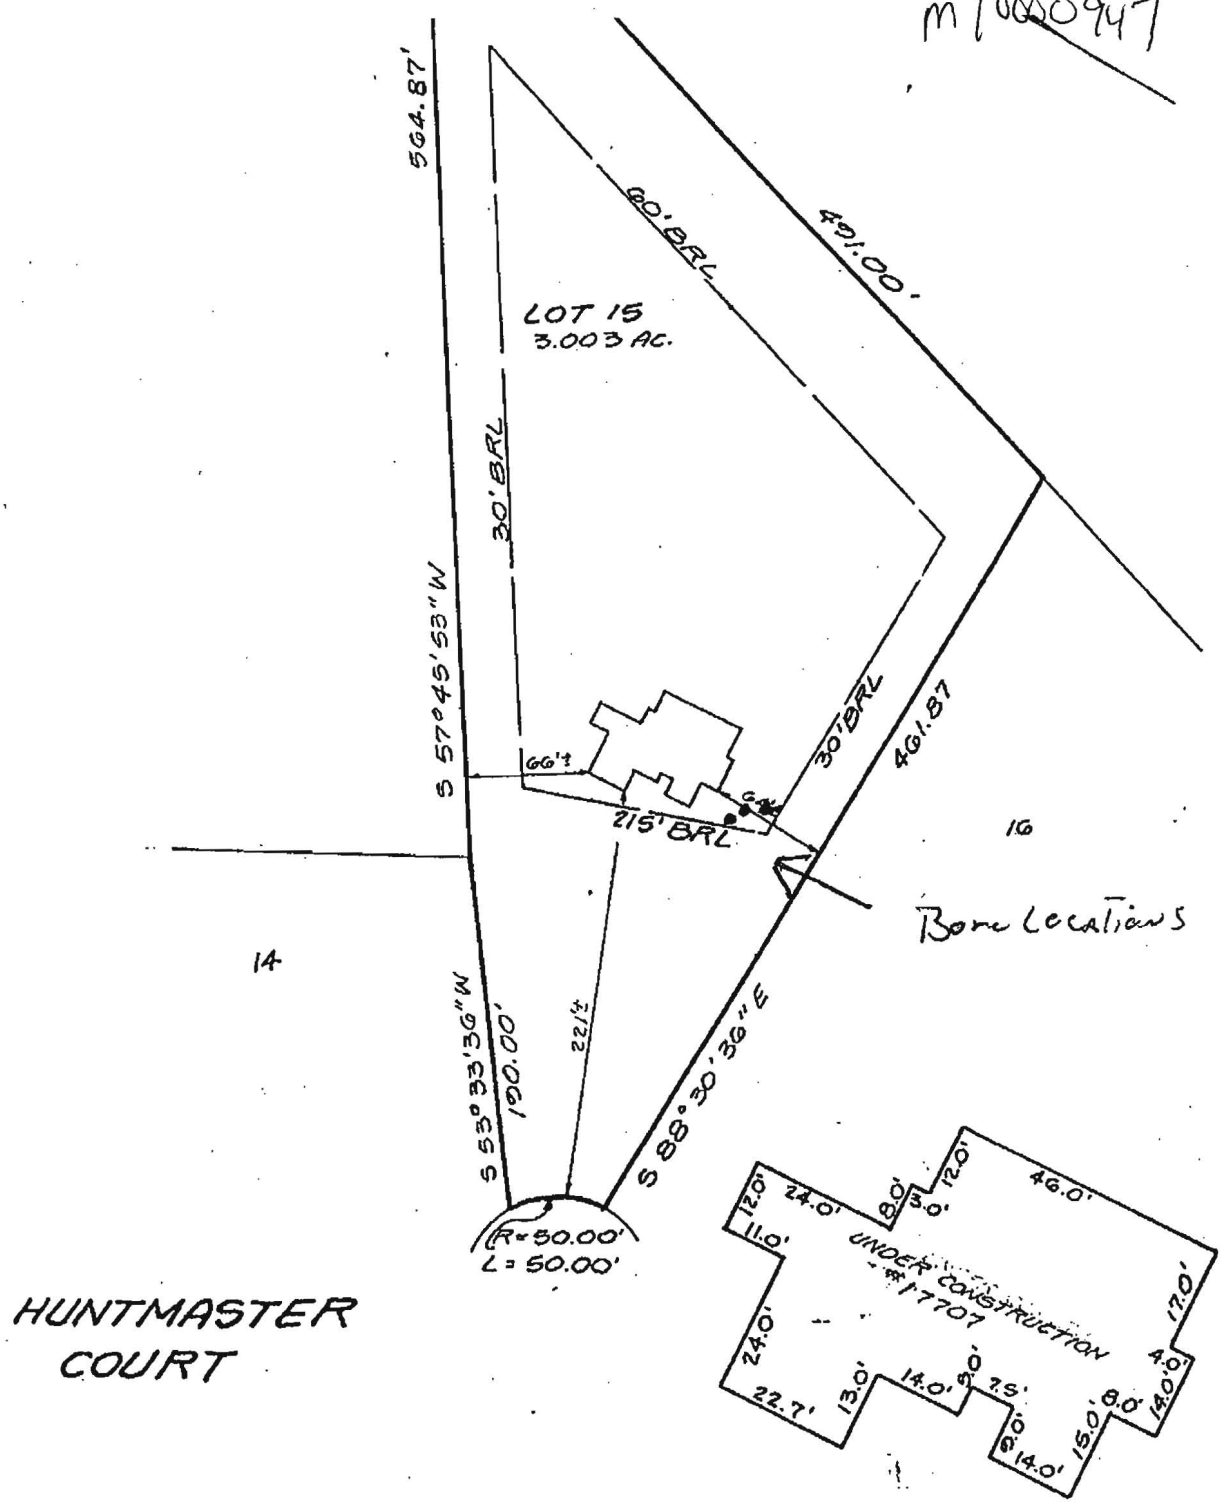

LOCATION SURVEY PLAT

SUBJECT PROPERTY NOT LOCATED IN A FLOOD PLAIN AREA UNLESS OTHERWISE NOTED

CERTIFICATION	SEAL	SCALE 1"=100' DATE 4-6-92
This is to certify that I have surveyed the property known as: 17707 HUNTMASTER COURT Woodbine, Md 21797 for the purpose of locating the improvements thereon, and the improvements are located as shown.	STATE OF MARYLAND WALTER PARK 5530 REGISTERED PROFESSIONAL LAND SURVEYOR	LAND DESIGN ENGINEERING, INC. SUITE 210 10620 GUILFORD ROAD JESSUP, MARYLAND 20794 880-0034 (BALT) 604-6264 (WASH) 604-6735 (FAX)