HO-73-0261

A/P _____

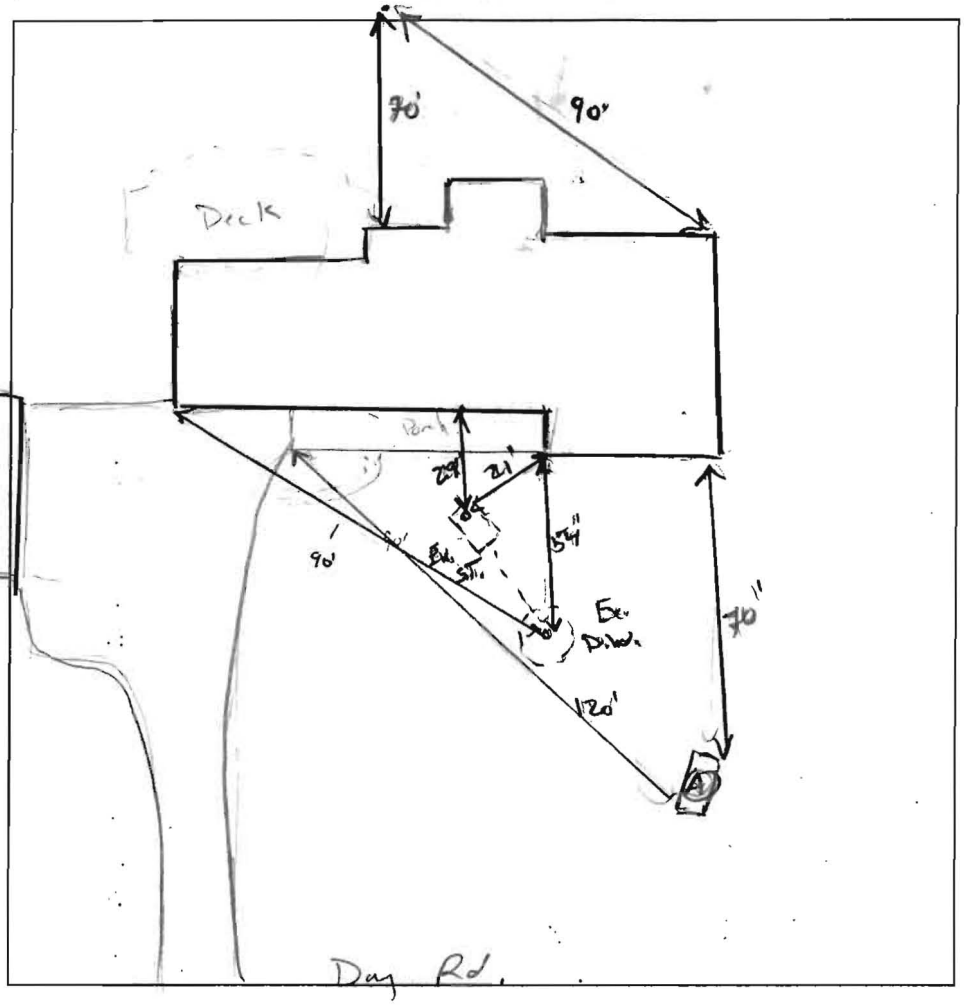

A

6"	layer of topsoil & herbaceous
-3'2"	Brown/Yellow Cl, w/ SBK very Friable, Dry, many roots, 5% chunks,
5'	med. Loam, Friable, wsBk, tonny plenty, 10% schist chunks
15'9"	MSL, Loam, CW, micaceous, Dry. ↓ FSL, Friable, Dry, Heavy mica

DATE	TEST #	DEPTH	START	BREAK 1" DROP	STOP 2" DROP	TIME OF 2nd INCH	P/F/H
7/6/11	A	3'6"/15'9"	10:56	1/2" movement in 20 mins			
		5'3"	11:17	11:24	11:33	11	P
				(rates increase w/ Depth)			

REMARKS _____

SANITARIAN K. Wolf BACKHOE Mark Seal OTHERS Rudi & Homeowner

TEST HOLES USED IN SDA 1 AVG. PERC TIME _____ SQ. FT/BR _____

TRENCH WIDTH 2' INLET DEPTH 4' MAX. BOT DEPTH 9' EFFECTIVE S/W 6'

(3BR) 150 = 450/0.8 = 562.5 ÷ 2 = 281.25 (.44) = 123